

WPX Energy Rocky Mountain LLC

FINAL

RWF 13-14


API #05-045-20147-00

1866' FNL x 2347' FWL - (SENW) - SHL

2200' FSL x 1246' FWL - (NWSW) - BHL

Sec. 14-T6S-R94W

Garfield County, Colorado

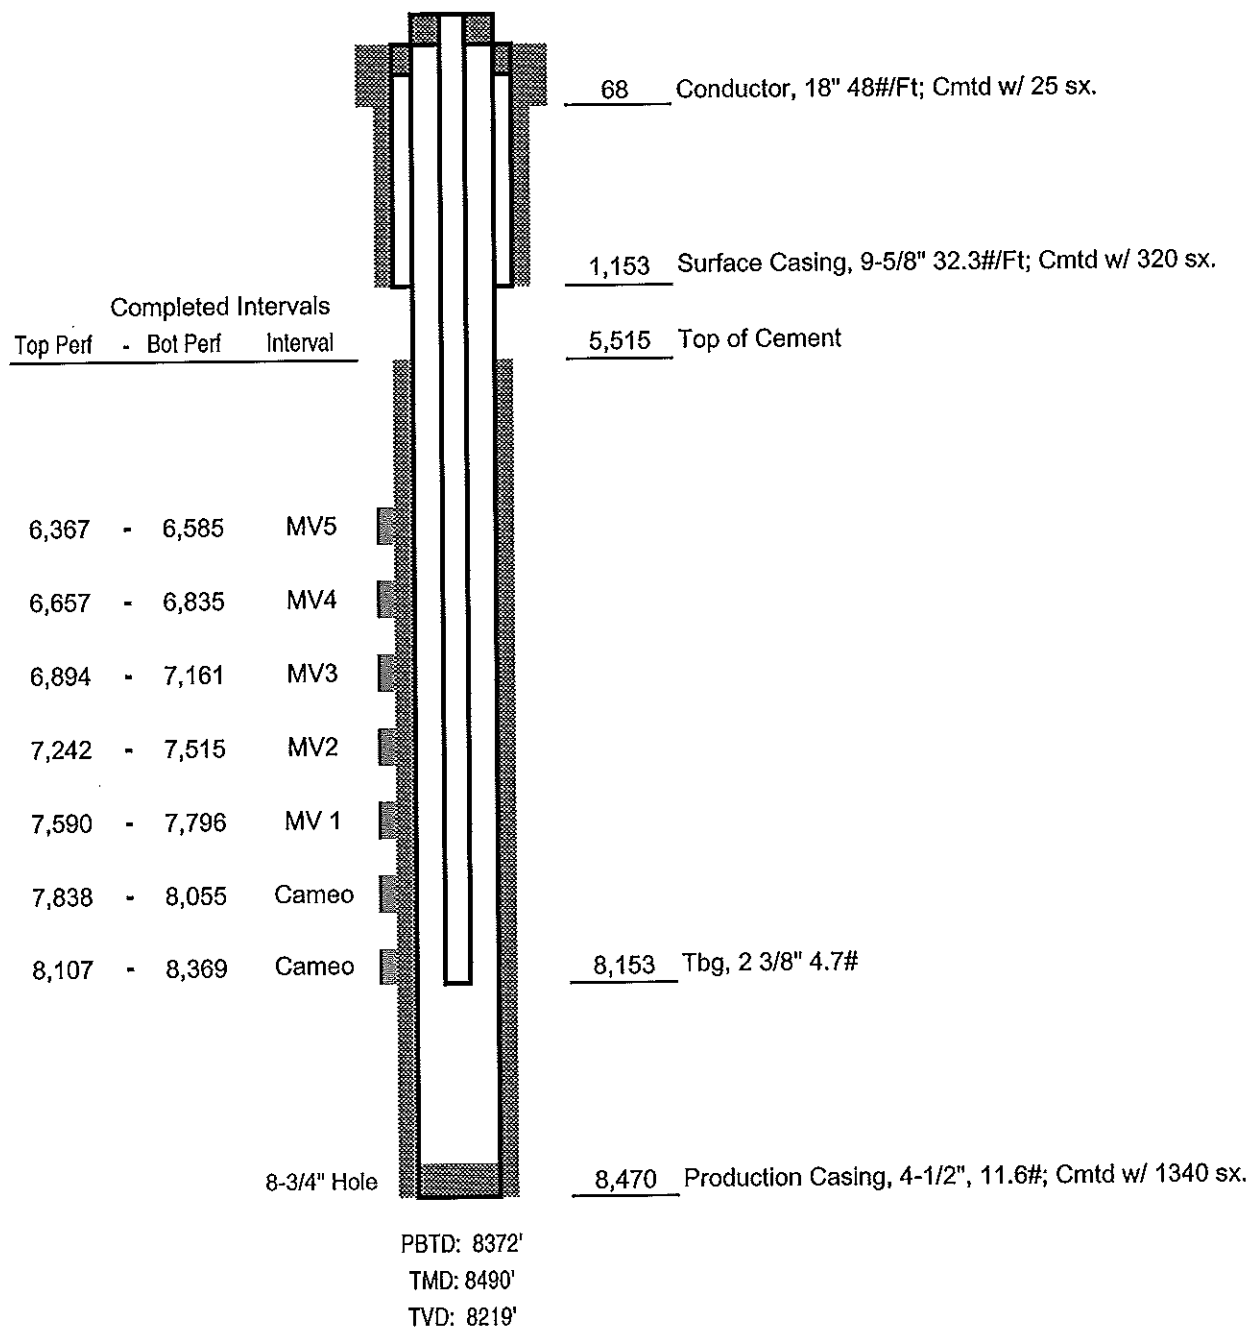

Not to Scale