

WPX Energy Rocky Mountain LLC

FINAL

RWF 323-14


API #05-045-20148-00

1861' FNL x 2342' FWL - (SENW) - SHL

2498' FSL x 1381' FWL - (NESW) - BHL

Sec. 14-T6S-R94W

Garfield County, Colorado

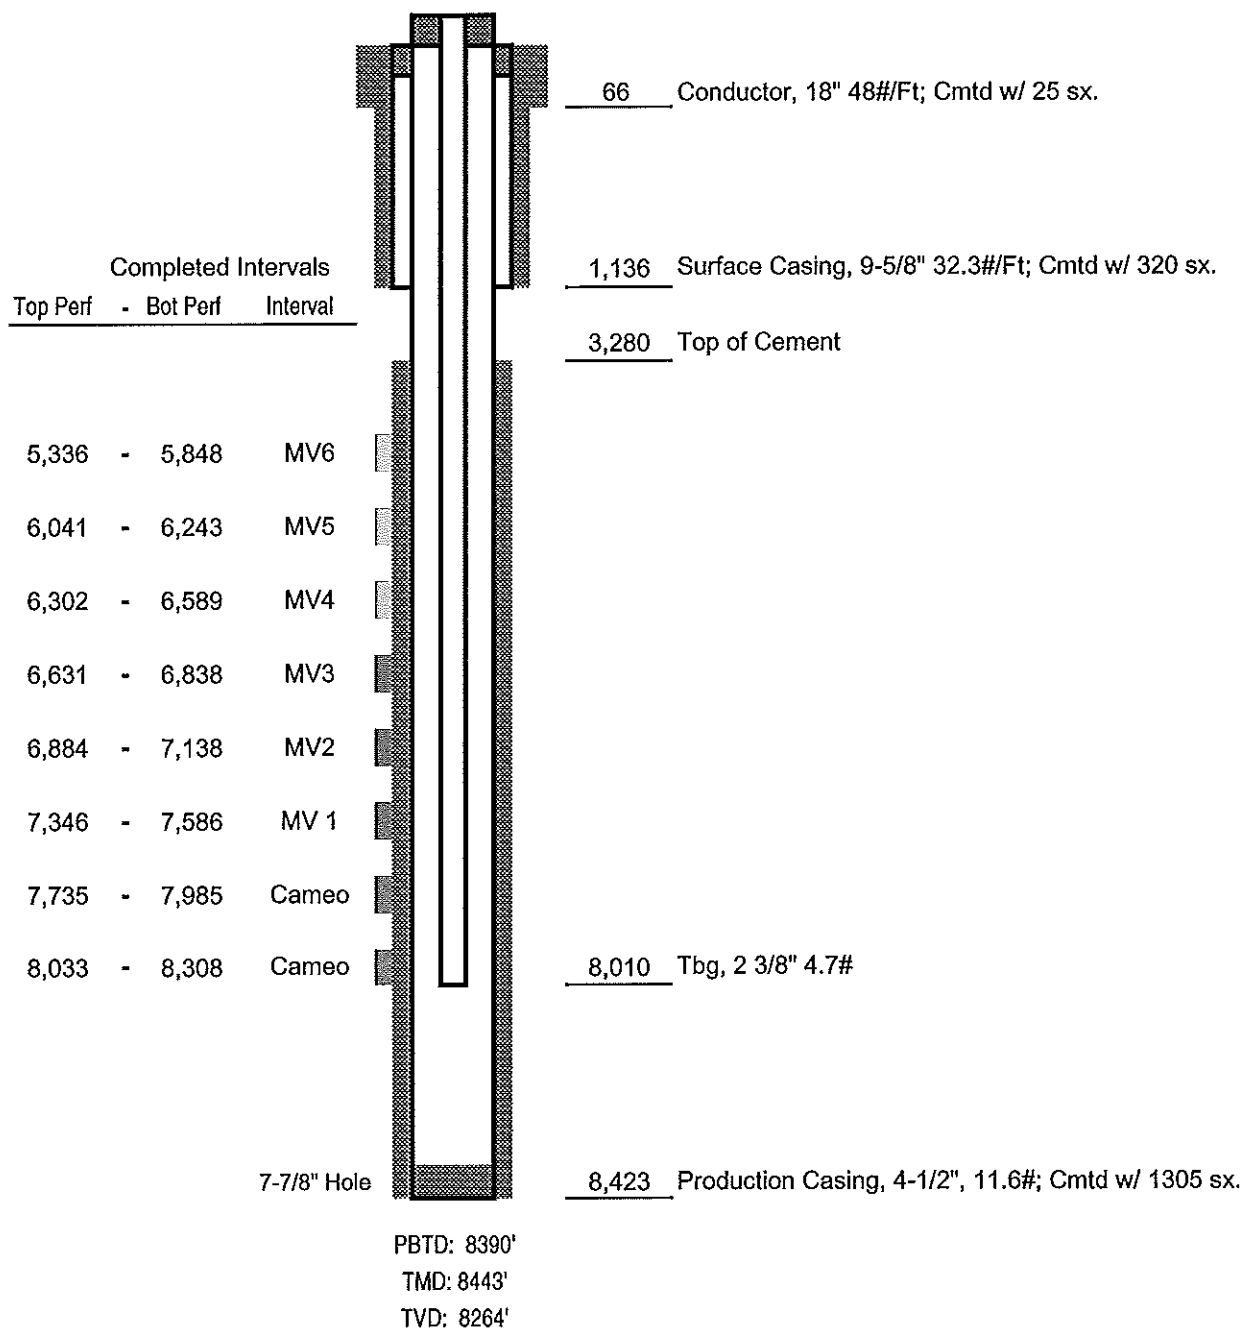

Not to Scale