
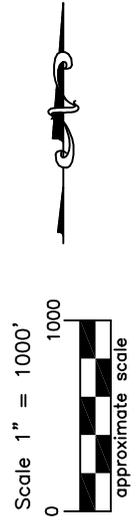


JR Land Surveying, LLC  
 8114 Northstar Drive  
 Windsor, Colorado 80528  
 P. 970-576-4641

# WELL LOCATION CERTIFICATE

THIS MAP DOES NOT REPRESENT A BOUNDARY SURVEY

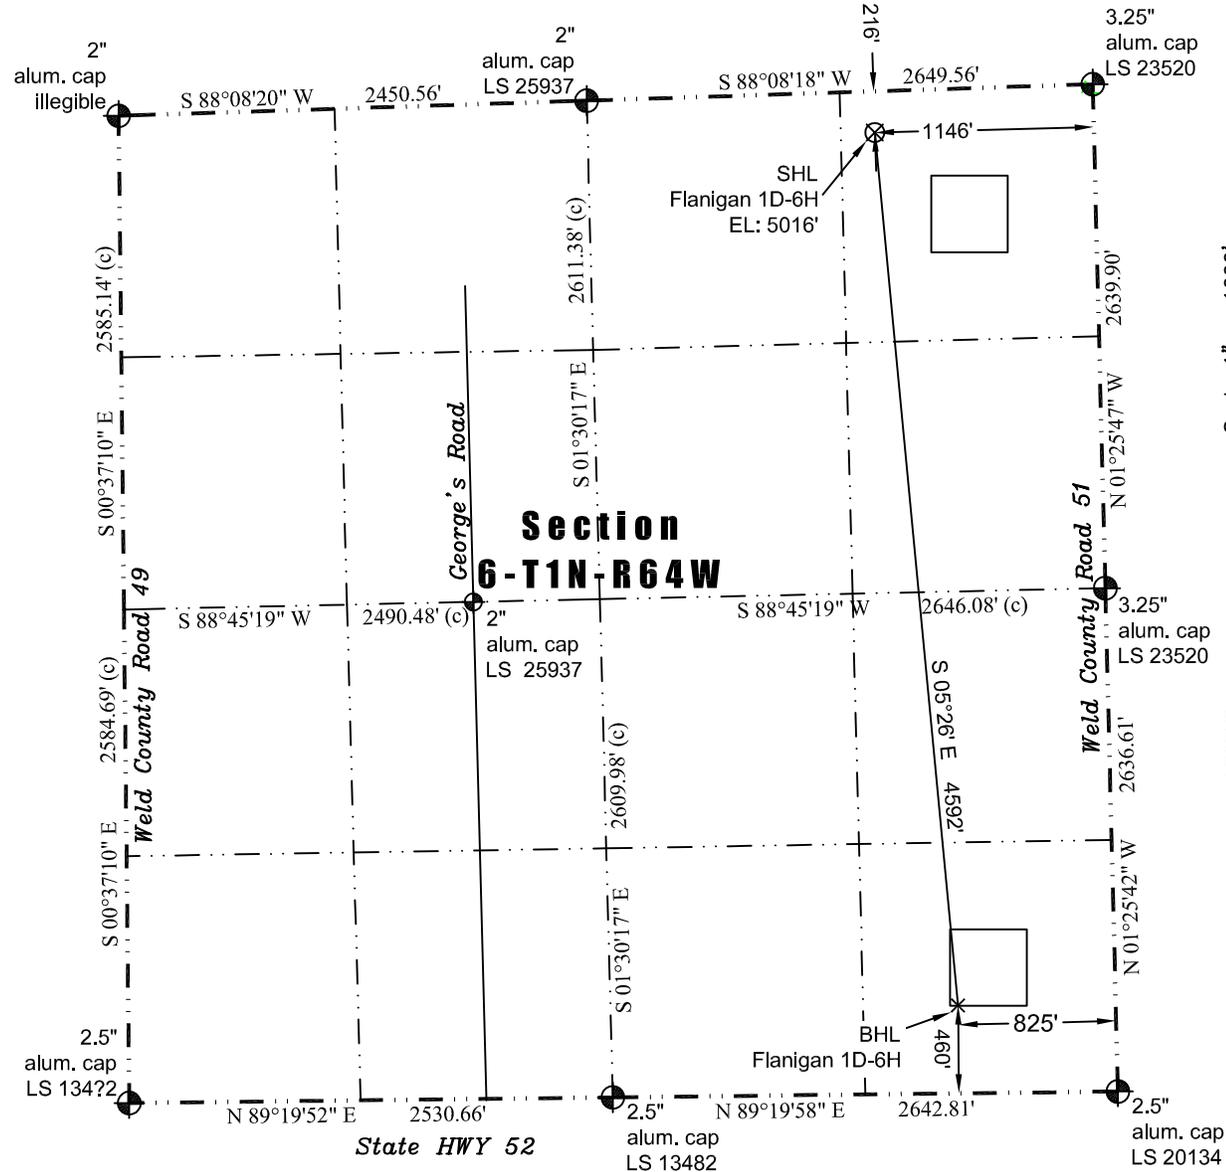

**LEGEND**  
 — found survey monument  
 (c) — calculated dimension

In accordance with a request from Jay Knutson of EnCana Oil & Gas (USA) Inc., JR Land Surveying, LLC has determined the location of the **Flanigan 1D-6H** well site to be SHL: 216' FNL and 1146' FEL, (BHL: 460' FSL and 825' FEL), as measured at ninety (90) degrees from the section lines of Sections 6, Township 1 North, Range 64 West of the 6th Principal Meridian, Weld County Colorado.

**Surface Hole Data:**

Latitude: N 40.08707° (BHL: 40.07450°)  
 Longitude: W 104.58854° (BHL: 104.58715°)  
 PDOP: 2.3

**Nearest:**

Building: 1,080' southeast	Above Ground Utility: 959' northeast
Public Road: 1,133' east	Railroad: 6,472' northwest
Property Line: 216' north	Well Window: SHL is 372' outside
Existing Well: Flanigan #1, 791' southeast	

**Notes:**

- 1) Bearings and distances based on NAD 83 Colorado North State Plane Coordinates using RTK GPS observations taken 4/3/12 by operator John Rice.
- 2) Conversion factor to ground (1.000273635).
- 3) Elevations based on NAVD 88 GPS heights and Geoid 2003 corrections.
- 4) The surface use is a cultivated field.

**NOTICE:** According to Colorado law you must commence any legal action based upon any defect in this W.L.C. within three years after you first discover such defect. In no event may any action based upon any defect in this W.L.C. be commenced more than ten years from this said date of the certification shown hereon.

I hereby certify that this Well Location Certificate was prepared by me or under my direct supervision on 4/3/2012 for and on behalf of EnCana Oil & Gas (USA) Inc. That it is not a Land Survey Plat or an Improvement Survey Plat and that it is not to be relied upon for establishment of fences, buildings, or other future improvement lines.

**38219**  
 4-3-2012  
 JOHN ROBERT MCGEE, JR.  
 PROFESSIONAL LAND SURVEYOR

John Robert McGee, LS#38219  
 Well: Flanigan 1D-6H WLC