

WPX Energy Rocky Mountain LLC

FINAL

RWF 33-31


API #05-045-19780-00

405' FSL x 2401' FWL - (SESW) - SHL

2485' FSL x 2161' FEL - (NWSE) - BHL

Sec. 31-T6S-R94W

Garfield County, Colorado

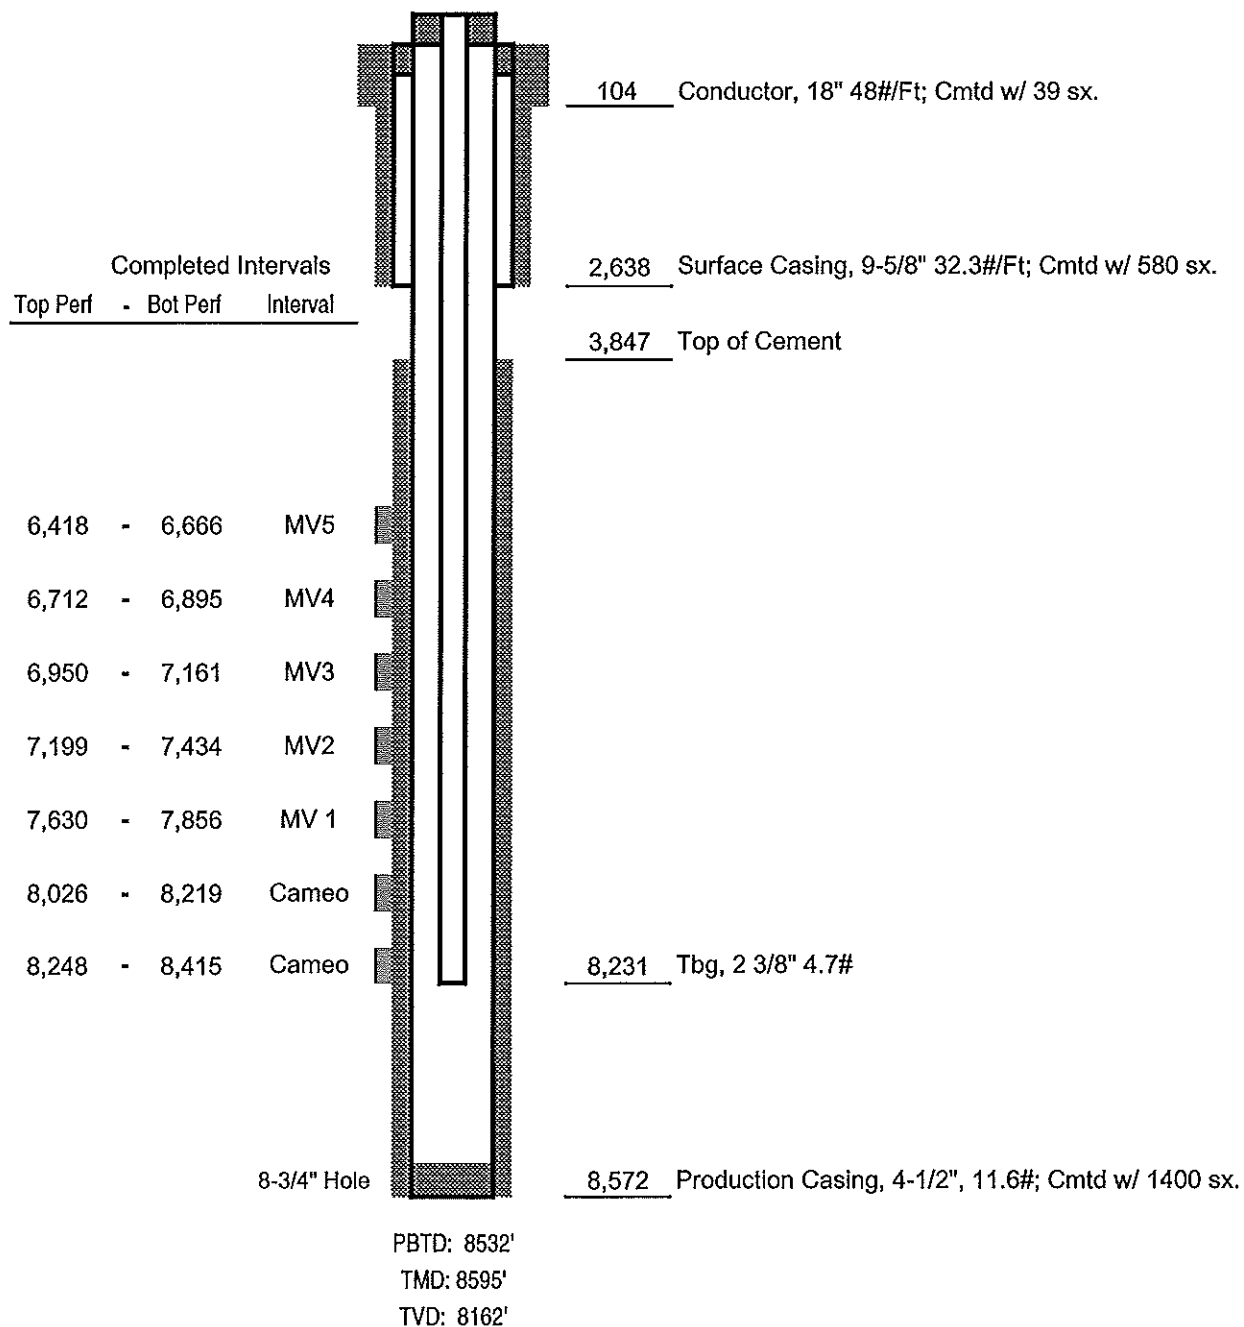

Not to Scale