


WPXENERGY

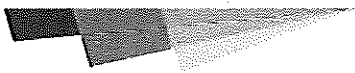

Well Name: RWF 333-31
Surface Location: RWF 34-31 Pad
North American Datum 1983 , US State Plane 1983 . Colorado Central Zone
Ground Elevation: 5707.00
KELLY BUSHING @ 5733.00usft (SSD 573 (26' KB) kjs)

+N/-S	+E/-W	Northing	Easting	Latitude	Longitude	Slot
0.00	0.00	1607179.40	2314329.20	39.47531	-107.92930	A11

