


|  |  |                                  |                                |                              |
|--|--|----------------------------------|--------------------------------|------------------------------|
| Qtr/Qtr, Block, Sec, Town, Range<br>NE/NE, Sec. 16, T10N, R68W | License #<br>400134589                 | Field Name<br>RAWHIDE FLATS      | State/Province<br>COLORADO     | Country<br>USA               |
| Well Configuration Type<br>HORIZONTAL                          | Original KB Elevation (ft)<br>5,603.00 | KB-Ground Distance (ft)<br>25.00 | KB-Casing Flange Distance (ft) | KB-Tubing Head Distance (ft) |

**Most Recent Job**

|                            |  |                    |                          |          |
|----------------------------|--|--------------------|--------------------------|----------|
| Job Category<br>COMPLETION | Primary Job Type<br>INITIAL COMPLETION | Secondary Job Type | Start Date<br>11/15/2011 | End Date |
|----------------------------|--|--------------------|--------------------------|----------|

**TD: 11,585.0**

HORIZONTAL - RAWHIDE FLATS 10-68-16-1H BP01, 4/19/2012 9:07:39 AM

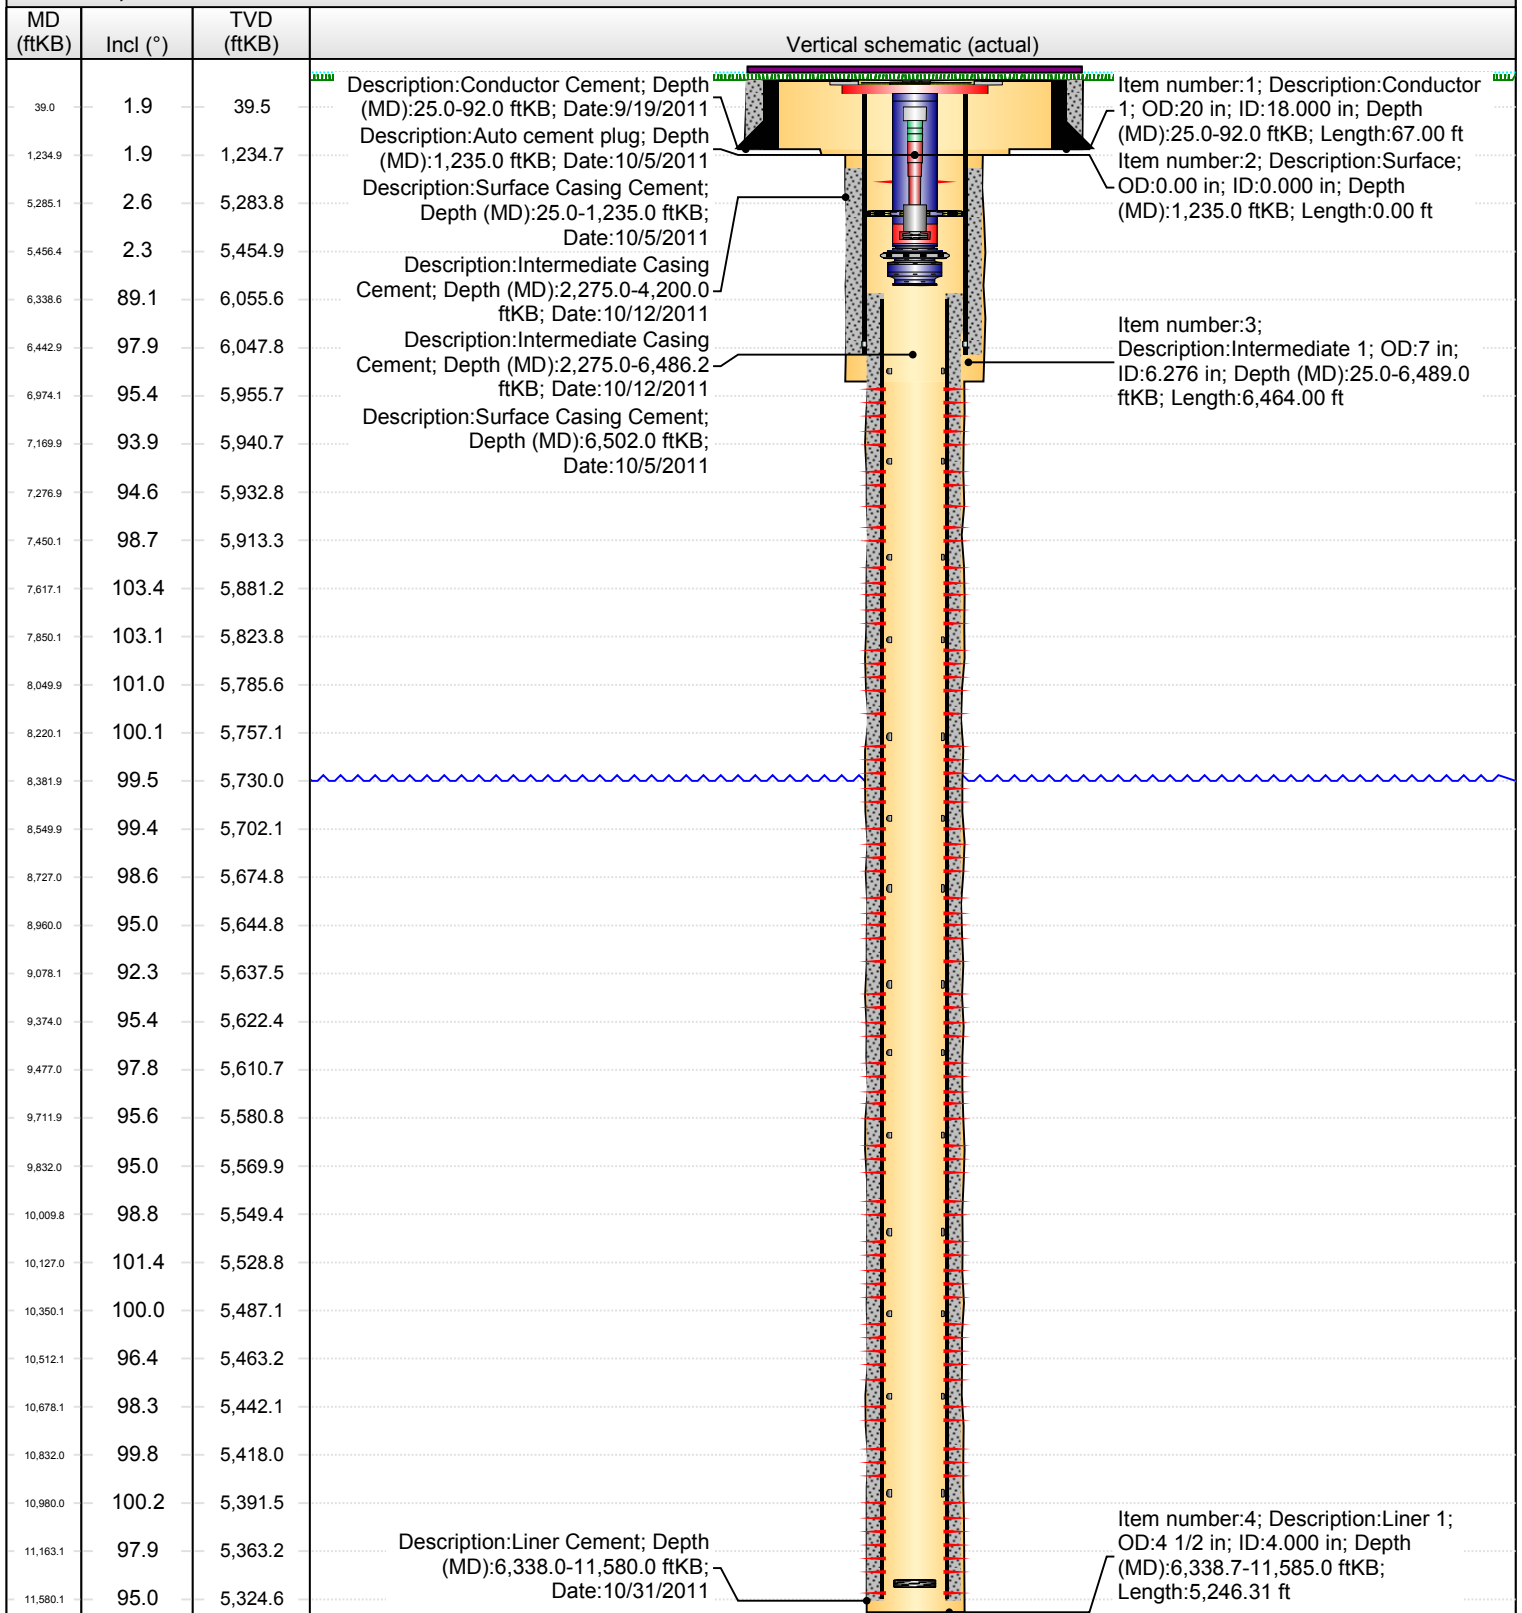

# Schematic - Current

## Well Name: RAWHIDE FLATS 10-68-16-1H


|  |  |                                  |                                |                              |
|--|--|----------------------------------|--------------------------------|------------------------------|
| Qtr/Qtr, Block, Sec, Town, Range<br>NE/NE, Sec. 16, T10N, R68W | License #<br>400134589                 | Field Name<br>RAWHIDE FLATS      | State/Province<br>COLORADO     | Country<br>USA               |
| Well Configuration Type<br>HORIZONTAL                          | Original KB Elevation (ft)<br>5,603.00 | KB-Ground Distance (ft)<br>25.00 | KB-Casing Flange Distance (ft) | KB-Tubing Head Distance (ft) |

### Most Recent Job

|                            |  |                    |                          |          |
|----------------------------|--|--------------------|--------------------------|----------|
| Job Category<br>COMPLETION | Primary Job Type<br>INITIAL COMPLETION | Secondary Job Type | Start Date<br>11/15/2011 | End Date |
|----------------------------|--|--------------------|--------------------------|----------|

**TD: 11,585.0**

HORIZONTAL - RAWHIDE FLATS 10-68-16-1H BP01, 4/19/2012 9:07:39 AM

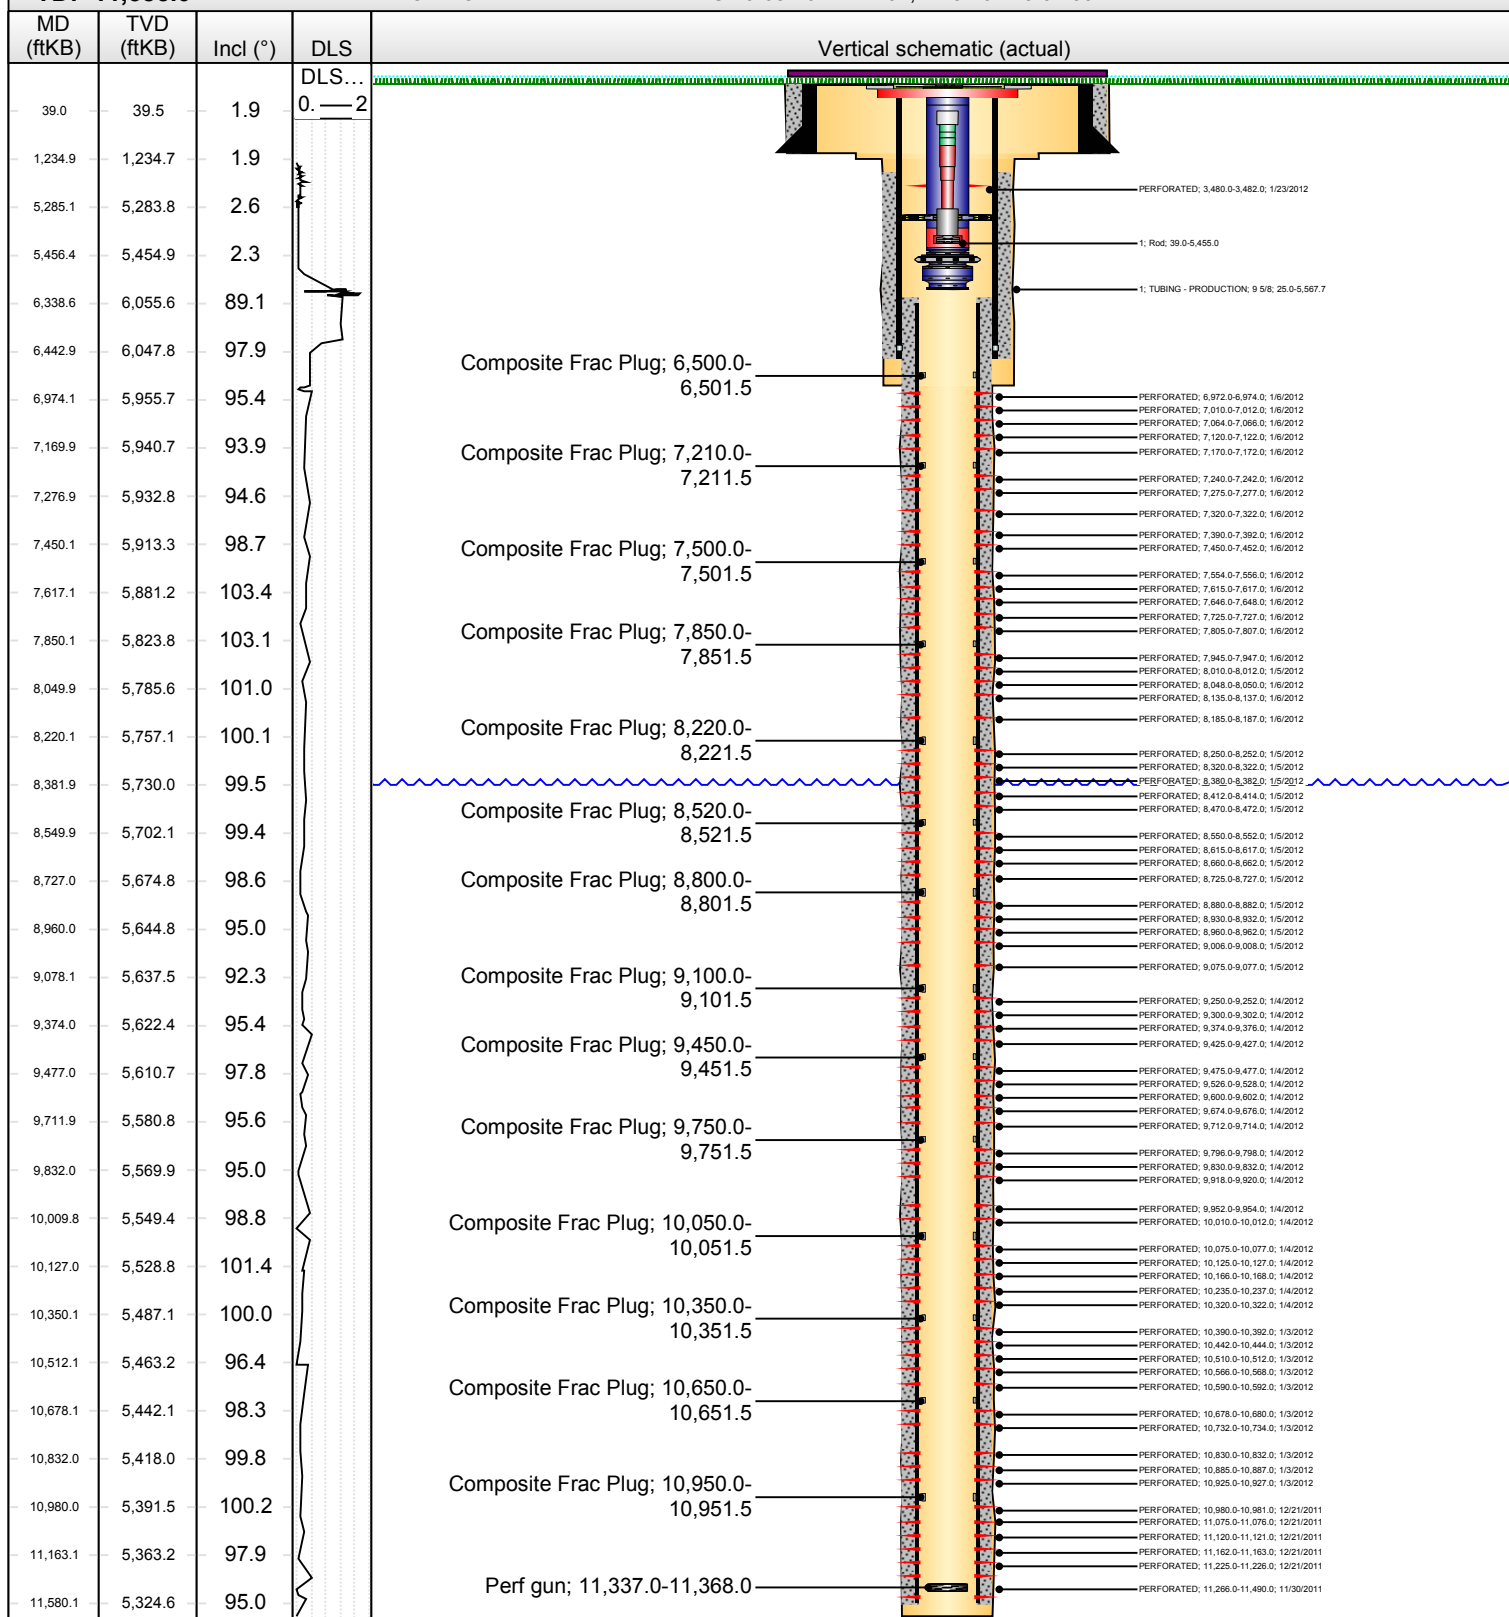

|  |  |                                  |                                |                              |
|--|--|----------------------------------|--------------------------------|------------------------------|
| Qtr/Qtr, Block, Sec, Town, Range<br>NE/NE, Sec. 16, T10N, R68W | License #<br>400134589                 | Field Name<br>RAWHIDE FLATS      | State/Province<br>COLORADO     | Country<br>USA               |
| Well Configuration Type<br>HORIZONTAL                          | Original KB Elevation (ft)<br>5,603.00 | KB-Ground Distance (ft)<br>25.00 | KB-Casing Flange Distance (ft) | KB-Tubing Head Distance (ft) |

**Most Recent Job**

|                            |  |                    |                          |          |
|----------------------------|--|--------------------|--------------------------|----------|
| Job Category<br>COMPLETION | Primary Job Type<br>INITIAL COMPLETION | Secondary Job Type | Start Date<br>11/15/2011 | End Date |
|----------------------------|--|--------------------|--------------------------|----------|

**TD: 11,585.0**

HORIZONTAL - RAWHIDE FLATS 10-68-16-1H BP01, 4/19/2012 9:07:39 AM

Directional schematic (actual)

