


WELL LOCATION CERTIFICATE


THIS MAP DOES NOT REPRESENT A BOUNDARY SURVEY

SECTION: 36
TOWNSHIP: 4N
RANGE: 64W

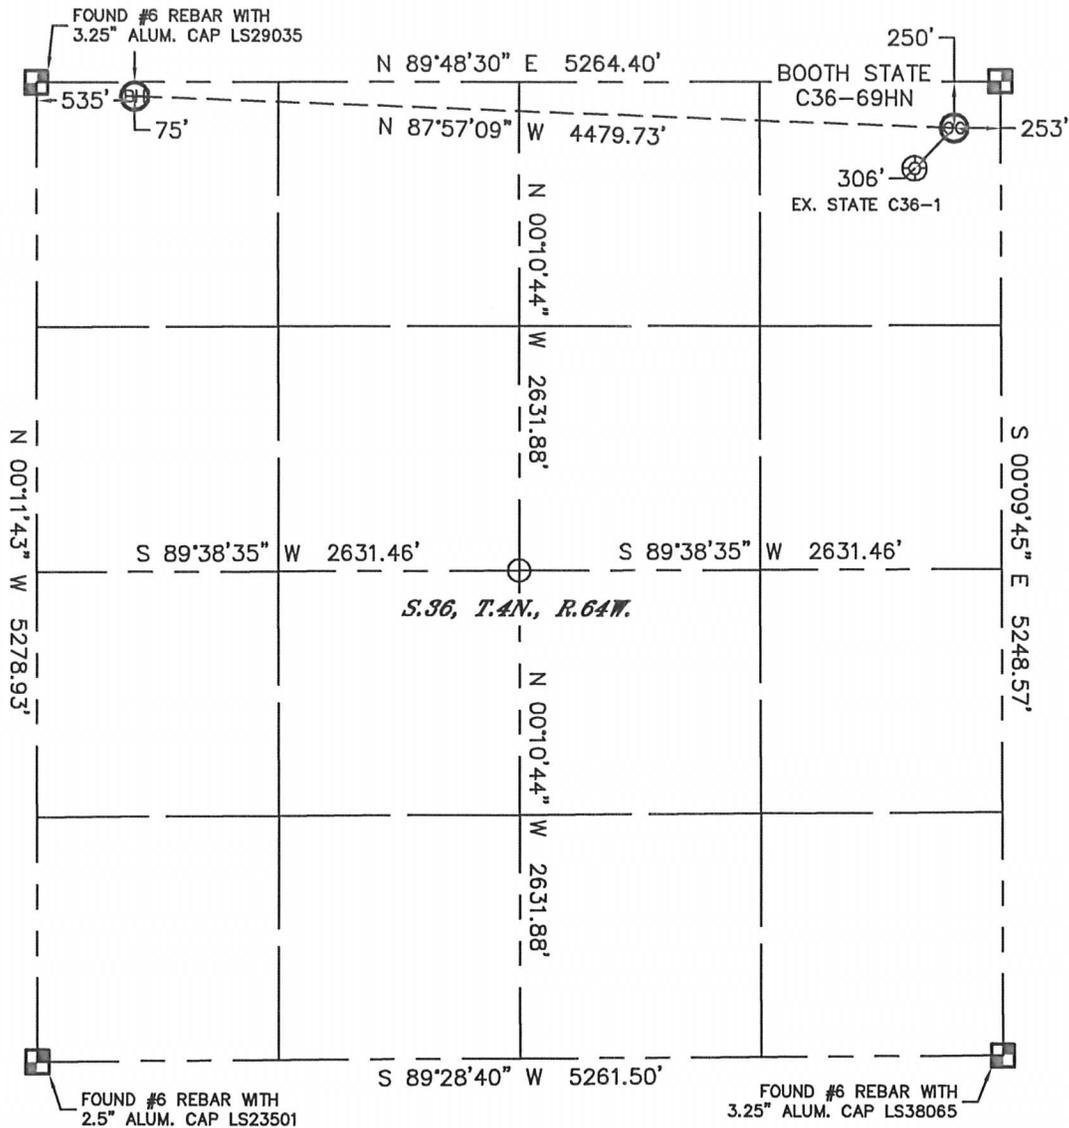

In accordance with a request from Matt Verbit with Noble Energy Inc. Lat40°, Inc. has determined the surface location of the BOOTH STATE C36-69HN to be 250' from the NORTH line and 253' from the EAST line and the bottom hole to be 75' from the NORTH line and 535' from the WEST line as measured at right angles from the section lines of Section 36, Township 4 North, Range 64 West of the Sixth Principal Meridian, County of Weld, State of Colorado.


I hereby state that this Well Location Certificate was prepared by me, or under my direct supervision, that the fieldwork was completed on 11/3/11, for and on behalf of Noble Energy Inc. That this is not a Land Survey Plat or an Improvement Survey Plat, and that it is not to be relied upon for establishment of fence, building, or other future improvement lines.

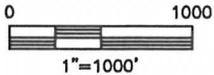

NOTE:

- 1) Bearings shown are Grid Bearings of the Colorado State Plane Coordinate System, North Zone, North American Datum 1983/2007. The lineal dimensions as contained herein are based upon the "U.S. Survey Foot."
- 2) Ground elevations are based on an observed GPS elevation (NAVD 1988 DATUM).
- 3) NEAREST EXISTING WELL: STATE C36-1, 306'
- 4) IMPROVEMENTS: See LOCATION DRAWING for all visible improvements within 400' of disturbed area.
- 5) SURFACE USE: RANGELAND
- 6) INSTRUMENT OPERATOR: ADAM KELLY

SURFACE LOCATION	BOTTOM HOLE
LATITUDE: 40.27543°N	LATITUDE: 40.27601°N
LONGITUDE: 104.49073°W	LONGITUDE: 104.50676°W
PDOP: 1.8	
ELEV: 4758'	
1/4, 1/4: NE1/4NE1/4	
NEAREST PROPERTY LINE: 253' EAST	

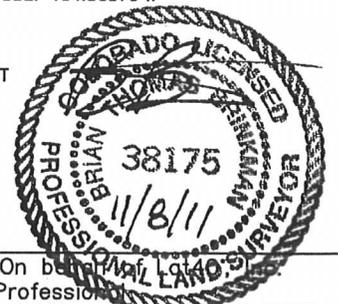

NOTE

According to Colorado law, you must commence any legal action based upon any defect in this W.L.C. within three years after you discover such defect. In no event, may any action based upon any defect in this survey be commenced more than ten years after the date of the certificate shown hereon. (13-80-105 C.R.S.)

LEGEND


-  = ALIQUOT MONUMENT AS DESCRIBED
-  = CALCULATED POSITION

Brian T. Brinkman—On behalf of Lat40°
Colorado Licensed Professional Land Surveyor No. 38175
PROJECT#: 2011314

SITE SKETCH

BOOTH STATE C36-69HN

SECTION: 36
TOWNSHIP: 4N
RANGE: 64W

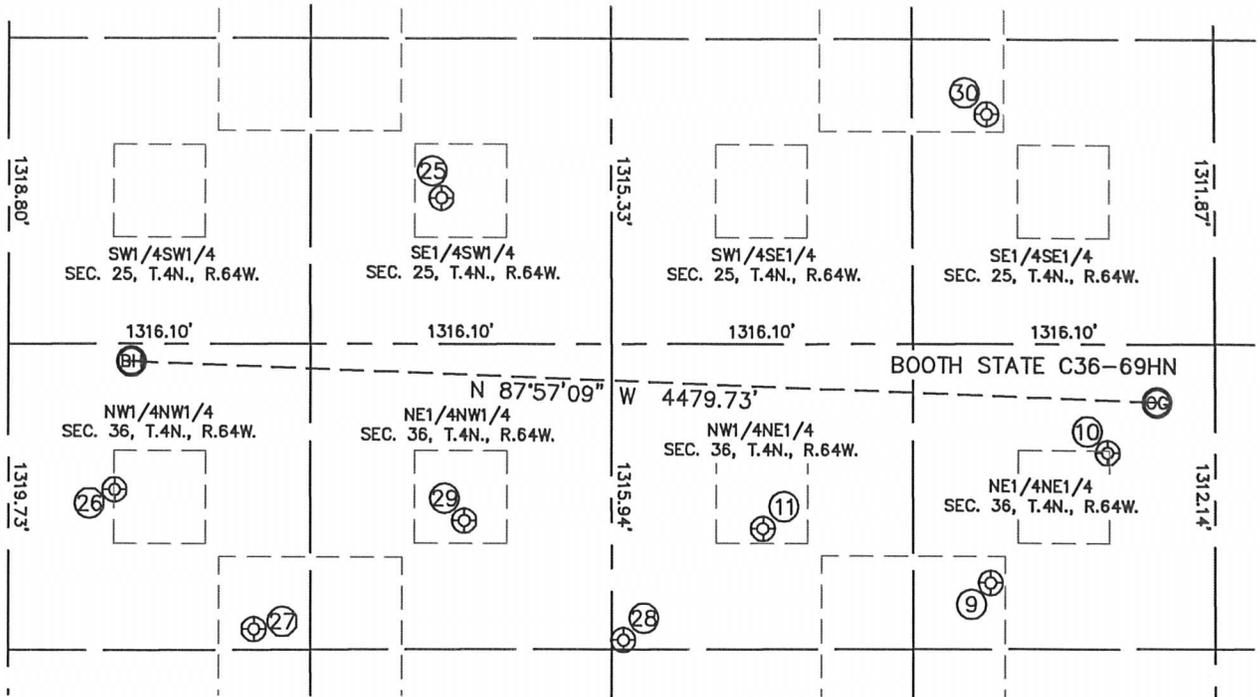

⑨
STATE 'B' 41-36
NE1/4NE1/4
1028' FNL
979' FEL
LAT-40.27331°N
LONG-104.49335°W
PDOP: 2.7
ELEV: 4758'

⑩
STATE C36-1
NE1/4NE1/4
467' FNL
469' FEL
LAT-40.27484°N
LONG-104.49151°W
PDOP: 1.1
ELEV: 4755'

⑪
STATE 36-214
NW1/4NE1/4
795' FNL
1971' FEL
LAT-40.27397°N
LONG-104.49690°W
PDOP: 1.2
ELEV: 4738'

BOOTH 14-25
SE1/4SW1/4
628' FSL
1889' FWL
LAT-40.27791°N
LONG-104.50189°W
PDOP: 2.1
ELEV: 4726'

STATE C36-4
NW1/4NW1/4
628' FNL
462' FWL
LAT-40.27449°N
LONG-104.50704°W
PDOP: 3.0
ELEV: 4723'

STATE C36-414
NW1/4NW1/4
1230' FNL
1069' FWL
LAT-40.27283°N
LONG-104.50488°W
PDOP: 2.1
ELEV: 4720'

AVA STATE C36-18
NW1/4NE1/4
1276' FNL
2581' FEL
LAT-40.27266°N
LONG-104.49910°W
PDOP: 2.9
ELEV: 4736'

STATE 36-314
NE1/4NW1/4
761' FNL
1989' FWL
LAT-40.27409°N
LONG-104.50157°W
PDOP: 2.7
ELEV: 4725'

UPRR 66 AMOCO 1
SE1/4SE1/4
990' FSL
990' FEL
LAT-40.27885°N
LONG-104.49335°W
PDOP: 2.6
ELEV: 4738'

