


MARATHON OIL CO. OWL CREEK 8-64-6-1H AS-DRILLED WELL LOCATION PLAT

LOCATED WITHIN LOT 4 SECTION 6, T8N, R64W,
OF THE 6TH P.M., WELD COUNTY, COLORADO

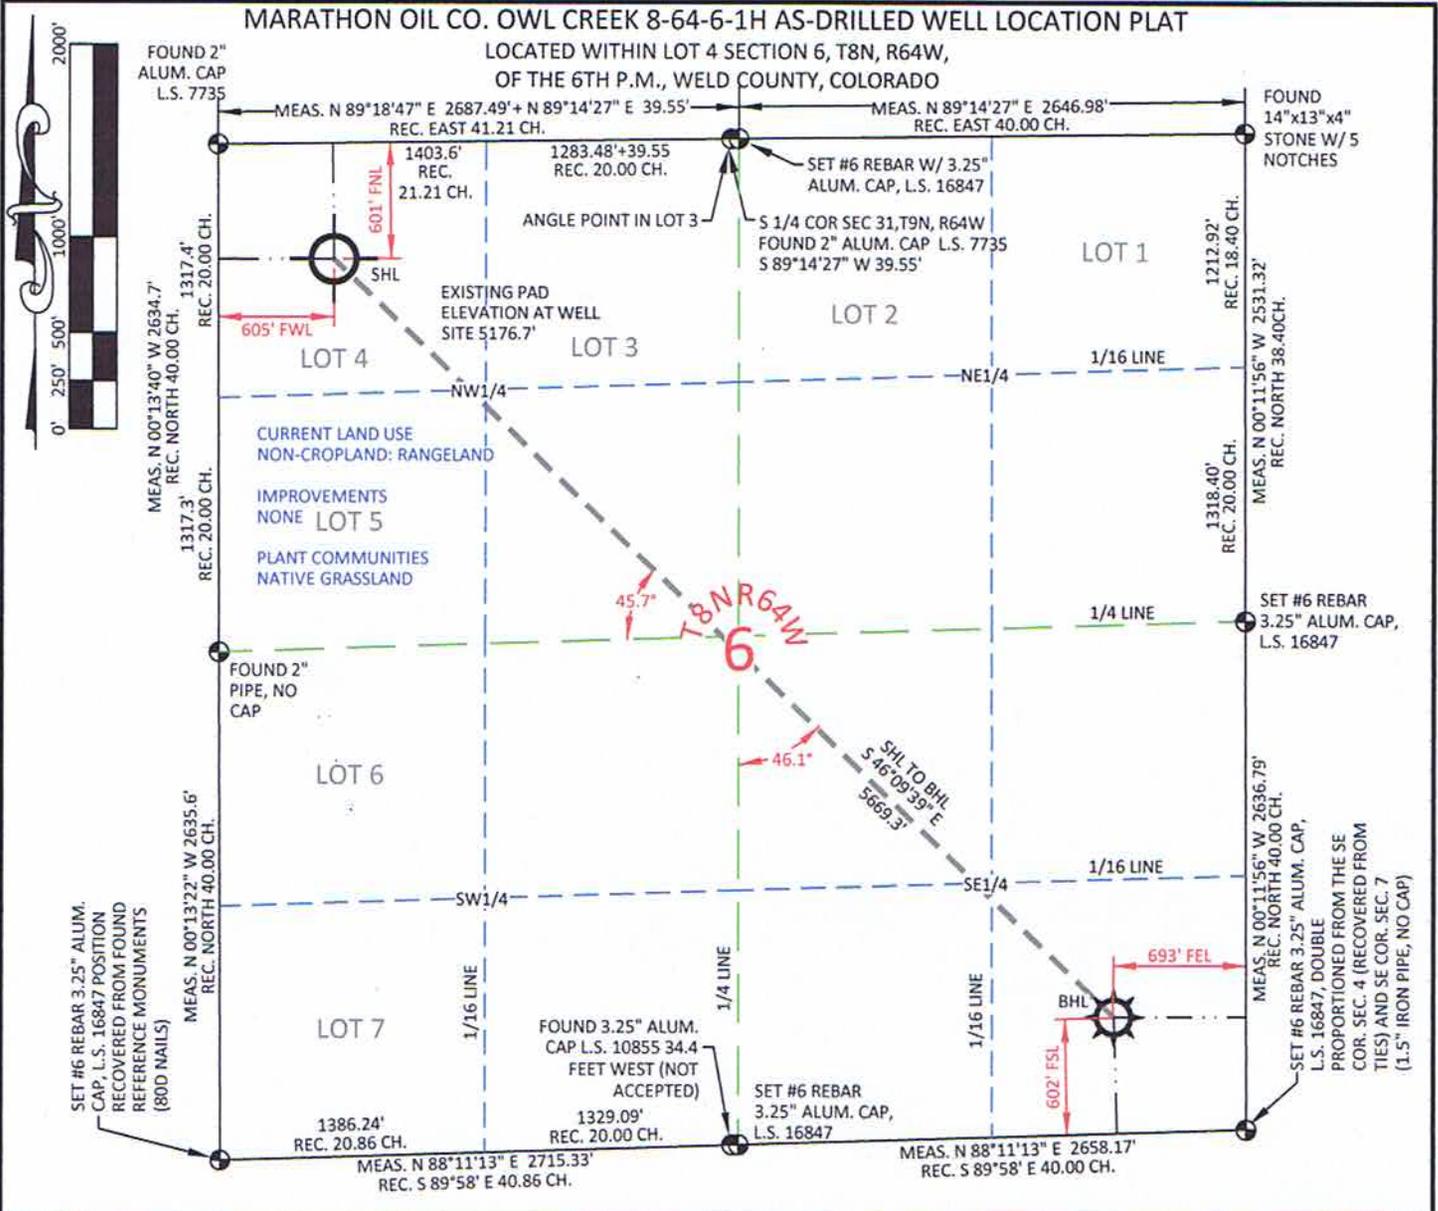

| SURFACE HOLE (AS-DRILLED) | | BOTTOM HOLE (AS-DRILLED) | |
|------------------------------|---------------------|------------------------------|----------------|
| LAT. | 40.694335° | LAT. | 40.683442° |
| LONG. | 104.598600° | LONG. | 104.584001° |
| LAT. | 40.694354° | LAT. | 40.683461° |
| LONG. | 104.598084° | LONG. | 104.583485° |
| LAT. | 40°41'39.60" | LAT. | 40°41'00.39" |
| LONG. | 104°35'54.96" | LONG. | 104°35'02.40" |
| LAT. | 40°41'39.67" | LAT. | 40°41'00.46" |
| LONG. | 104°35'53.10" | LONG. | 104°34'00.55" |
| NORTH | 1497059.92 | NORTH | 1493133.19 |
| EAST | 3249954.85 | EAST | 3254044.02 |
| NORTH | 497059.62 | NORTH | 493132.96 |
| EAST | 2250104.71 | EAST | 2254193.80 |
| FOOTAGE: 605' FWL - 601' FNL | | FOOTAGE: 693' FEL - 602' FSL | |
| MEASURE DATE | INSTRUMENT OPERATOR | PDOP | SHL GRND ELEV. |
| 2/25/2012 | ALLEN BLATTEL | 1.4 | 5176.7' |

I, Rodney A. Walters, Professional Land Surveyor, CO. LS # 16847 hereby certify that (in accordance with a request from Erin Bibeau with Marathon Oil Co, 5555 San Felipe, Houston, TX 77056) I and/or personnel under my direction made a survey on the 25th day of February 2012, for the Surface Hole Location and Elevation of Marathon Oil Co. OWL CREEK 8-64-6-1H being located within Lot 4, Section 6, T8N, R64W, and the Bottom Hole Location being located in the SE1/4 SE1/4 of Section 6, T8N, R64W, both being of the 6th P.M., Weld County, State of Colorado.

- All bearings and distances are GRID, based on the Colorado State Plane Coordinate System, North Zone, North American Datum 1983 from GPS observations occupying a WHS control point (5/8" rebar) and having the Location and Elevation derived from an Opus Solution.
- Vertical Datum used is of NAVD 88.
- Record Bearings and Distances as shown are based on the General Land Office Survey plat approved on the 20th day of October 1870.
- Geographic coordinates for the bottom hole location were taken from the wellpath report prepared by Baker Hughes for Owl Creek 8-64-6-1H and dated 2/9/2012.



CONFIDENTIALITY NOTES:
The information contained in this plat is legally privileged and confidential information intended only for the use of the recipients. If you are not the intended recipients, you are hereby notified that any use, dissemination, distribution or copying of this information is strictly prohibited.

WILLIAM H. SMITH & ASSOCIATES P.C.
SURVEYING CONSULTANTS
350 EAST SECOND NORTH GREEN RIVER, WY
PHONE: 307-875-3638 307-875-3639
www.wsmithpc.com

| | |
|--------------------|-----------------|
| DRAWN BY: LAL | CHECKED BY: RAW |
| PROJECT NO: 86461H | JOB NO: 2011001 |
| REVISIONS: | |

LEGEND

- FOUND CORNER
- ⊗ CALCULATED CORNER
- NOTHING FOUND

LOCATION:
OWL CREEK 8-64-6-1H
WITHIN LOT 4 OF SECTION 6, T 8 N, R 64 W, 6TH PM.
WELD COUNTY, COLORADO

MARATHON OIL COMPANY
PO BOX 3128, HOUSTON TX, 77253
5555 SAN FELIPE, HOUSTON TX, 77056

AS-DRILLED WELL LOCATION PLAT

| | |
|-----------------|--------------|
| SCALE: 1"=1000' | EXHIBIT "A" |
| DATE: 5/2/2012 | SHEET 1 OF 1 |