


MARATHON CROW VALLEY 7-62-35-2H AS-DRILLED WELL LOCATION PLAT

LOCATED WITHIN THE NE1/4 NW1/4 SECTION 35 T7N R62W
OF THE 6TH P.M., WELD COUNTY, COLORADO

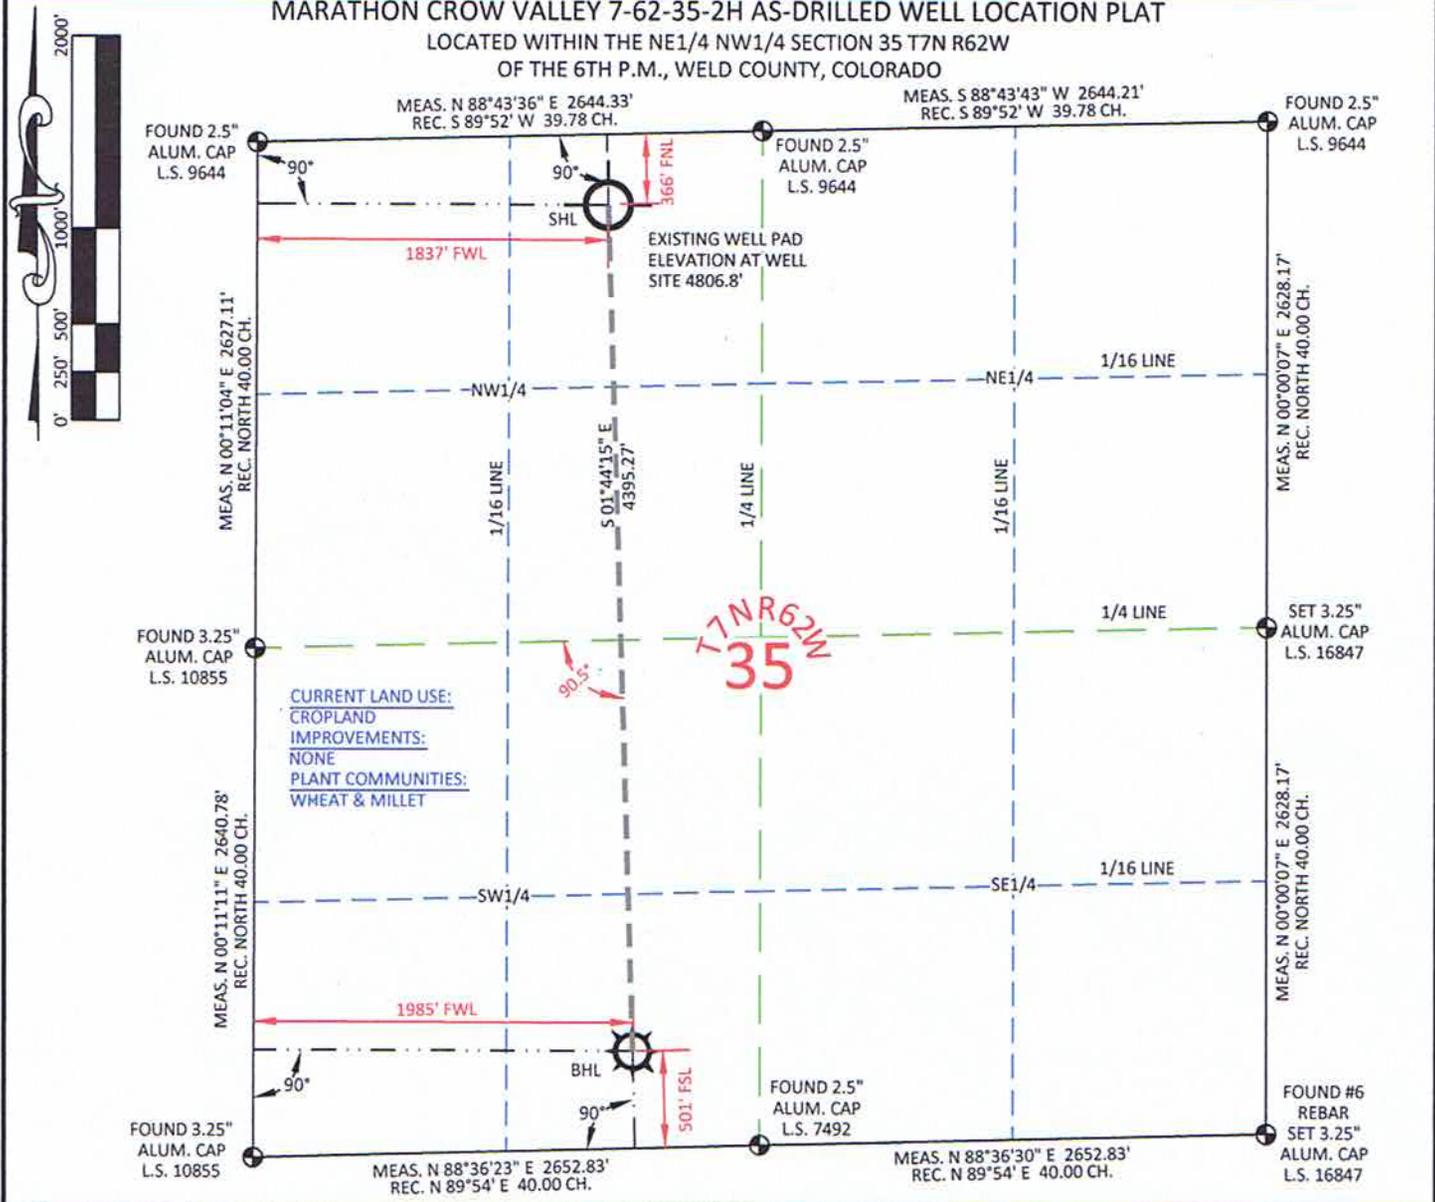

SURFACE HOLE LOCATION	
GEOGRAPHIC LAT.	40.537040°
GEOGRAPHIC LONG.	104.292081°
STATE PLANE CO. NORTH	40.537057°
STATE PLANE EAST	104.291575°
STATE PLANE NORTH	40°32'13.34"
STATE PLANE EAST	104°17'31.49"
STATE PLANE NORTH	40°32'13.41"
STATE PLANE EAST	104°17'29.67"
FOOTAGE:	1837' FWL - 366' FNL
MEASURE DATE	3/21/2012
INSTRUMENT OPERATOR	ALLEN BLATTEL
PDOP	1.6
SHL GRND ELEV.	4806.8'

BOTTOM HOLE LOCATION	
GEOGRAPHIC LAT.	40.524977°
GEOGRAPHIC LONG.	104.291817°
STATE PLANE CO. NORTH	40.524994°
STATE PLANE EAST	104.291311°
STATE PLANE NORTH	40°31'29.92"
STATE PLANE EAST	104°17'30.54"
STATE PLANE NORTH	40°31'29.98"
STATE PLANE EAST	104°17'28.72"
FOOTAGE:	1985' FWL - 501' FSL

I, Rodney A. Walters, Professional Land Surveyor, CO. PLS # 16847 hereby certify that (in accordance with a request from Erin Bibeau with Marathon Oil Co, 5555 San Felipe, Houston, TX 77056) I and or personnel under my direction made a survey on the 21st day of March 2012, for the Surface Hole Location and Elevation of Marathon Oil Co. CROW VALLEY 7-62-35-2H being located the NE 1/4 of the NW 1/4, Section 35, T7N R62W and the Bottom Hole Location being located in the SE1/4 of the SW1/4 of Section 35, T7N, R62W, both being of the 6th P.M., Weld County, State of Colorado.

- All bearings and distances are GRID, based on the Colorado State Plane Coordinate System, North Zone, North American Datum 1983 from GPS observations occupying a WHS control point (5/8" rebar) and having the Location and Elevation derived from an Opus Solution.
- Vertical Datum used is of NAVD 88.
- Record Bearings and Distances as shown are based on the General Land Office Survey plat approved on the 16th day of December 1872.
- Geographic coordinates for the bottom hole location were taken from the wellpath report prepared by Baker Hughes for Crow Valley 7-62-35-2H and dated 04/18/2012.



CONFIDENTIALITY NOTES:
 The information contained in this plat is legally privileged and confidential information intended only for the use of the recipients. If you are not the intended recipients, you are hereby notified that any use, dissemination, distribution or copying of this information is strictly prohibited.

WILLIAM H. SMITH & ASSOCIATES P.C.
 SURVEYING CONSULTANTS
 550 EAST SECOND NORTH GREEN RIVER, WY
 PHONE: 307-875-3638 307-875-3639
 www.wsmithpc.com

DRAWN BY: LAL CHECKED BY: RAW
 PROJECT NO: 762352H JOB NO: 2011001

LEGEND

- FOUND CORNER
- ⊗ CALCULATED CORNER
- NOTHING FOUND

LOCATION:
 CROW VALLEY 7-62-35-2H
 WITHIN THE NE 1/4 NW 1/4
 SECTION 35,
 T 7 N, R 62 W,
 6TH PM.
 WELD COUNTY,
 COLORADO

MARATHON OIL COMPANY
 PO BOX 3128, HOUSTON TX, 77253
 5555 SAN FELIPE, HOUSTON TX, 77056

AS-DRILLED WELL LOCATION PLAT

SCALE: 1"=1000' EXHIBIT "A"
 DATE: 4/28/2012 SHEET 1 OF 1