



RECEIVED 5/7/2012

SUNDRY NOTICE Submit original plus one copy. This form is to be used for general, technical and environmental sundry information. For proposed or completed operations, describe in full on Technical Information Page (Page 2 of this form) Identify well or other facility by API Number or by OGCC Facility ID. Operator shall send an informational copy of all sundry notices for wells located in High Density Areas to the Local Government Designee (Rule 603b)

1. OGCC Operator Number: 100264 4. Contact Name: Jessica Dooling
2. Name of Operator: XTO Energy Inc. Phone: 970-675-4122
3. Address: PO Box 6501 City: Englewood State: CO Zip: 80155 Fax: 970-675-4150
5. API Number: 05-103-07436 OGCC Facility ID Number: LOC ID# 314861
6. Well/Facility Name: Piceance Creek Unit 7. Well/Facility Number: F13-19G
8. Location (Qtr/Qtr, Sec, Twp, Rng, Meridian): NWSW, Sec 19, T-2S, R-95W, 6th PM
9. County: Rio Blanco 10. Field Name: Piceance Creek
11. Federal, Indian or State Lease Number: COD 45410

Complete the Attachment Checklist
OP OGCC
Survey Plat
Directional Survey
Surface Eqmpt Diagram
Technical Info Page
Other

General Notice

CHANGE OF LOCATION: Attach New Survey Plat (a change of surface qtr/qtr is substantive and requires a new permit)
CHANGE SPACING UNIT
CHANGE OF OPERATOR (prior to drilling):
CHANGE WELL NAME NUMBER
ABANDONED LOCATION:
NOTICE OF CONTINUED SHUT IN STATUS
SPUD DATE:
REQUEST FOR CONFIDENTIAL STATUS (6 mos from date casing set)
SUBSEQUENT REPORT OF STAGE, SQUEEZE OR REMEDIAL CEMENT WORK
RECLAMATION: Attach technical page describing final reclamation procedures per Rule 1004.

Technical Engineering/Environmental Notice

Notice of Intent
Report of Work Done
Details of work must be described in full on Technical Information Page (Page 2 must be submitted.)
Intent to Recomplete (submit form 2)
Request to Vent or Flare
E&P Waste Disposal
Change Drilling Plans
Repair Well
Beneficial Reuse of E&P Waste
Gross Interval Changed?
Rule 502 variance requested
Status Update/Change of Remediation Plans
Casing/Cementing Program Change
Other See Page 2 for Spills and Releases

I hereby certify that the statements made in this form are, to the best of my knowledge, true, correct and complete.

Signed: Dolena Johnson Date: 05/07/2012 Email: dee.johnson@xtoenergy.com
Print Name: DOLENA JOHNSON Title: REGULATORY COMPLIANCE TECHNICIAN

OGCC Approved: Chris Campbell Title: FOR Date: 05/11/2012
CONDITIONS OF APPROVAL, IF ANY:

NFA will be issued when backfill/reclamation is completed.
Aesthetic consideration OK

FORM

4

Rev 12/05

## TECHNICAL INFORMATION PAGE



FOR OGCC USE ONLY

- |  |                                 |                       |              |
|--|---------------------------------|-----------------------|--------------|
| 1. OGCC Operator Number:                       | 100264                          | API Number:           | 05-103-07436 |
| 2. Name of Operator:                           | XTO Energy Inc.                 | OGCC Facility ID #    |              |
| 3. Well/Facility Name:                         | Piceance Creek Unit             | Well/Facility Number: | F13-19G      |
| 4. Location (QtrQtr, Sec, Twp, Rng, Meridian): | NWSW, Sec 19, T2S, R96W, 6th PM |                       |              |

This form is to be completed whenever a Sundry Notice is submitted requiring detailed report of work to be performed or completed. This form shall be transmitted within 30 days of work completed as a "subsequent" report and must accompany Form 4, page 1

5. **DESCRIBE PROPOSED OR COMPLETED OPERATIONS**

XTO Energy herin requests consideration of site-specific background Arsenic levels as an alternative to the Table 910-1 value for the PCU F13-19G location. COGCC Table 910-1 Concentration Levels list the allowable concentration level for arsenic in soil at 0.39 mg/kg. Footnote 1 of Table 910-1 states "Consideration shall be given to background levels in native soils and ground water." At other locations COGCC has allowed the determination of allowable levels based upon a 10 % variability factor applied to background soil concentration values where the maximum allowable level is computed by multiplying the highest detected background concentration by 1.1.

Five representative background samples were collected from undisturbed areas adjacent to the subject location. Arsenic concentrations in those samples ranged from 3.5 mg/kg to 5.6 mg/kg. Applying the 10% variability factor to the highest concentration detected results in an allowable arsenic concentration level of 6.2 mg/kg.

Attached please find the Lab Data Summary Table and the Site Map indicating arsenic sampling locations.

We have removed an out of service partially buried tank from the PCU F13-19G location. A sample was collected from beneath the low point of the tank area and sampled per COGCC Table 910-1. Soil left in place does not exceed the allowable concentration levels listed in Table 910-1 with the exception of Arsenic (5.5 mg/kg). Clean backfill material will be imported from the Connell Pit in Meeker, CO. Please see associated Form 27.

XTO Energy respectfully requests No Further Action for the partially buried tank pit abandonment at the PCU F13-19G.

**Table 1**  
**Location: F13-19G**  
**Lab Summary**

Last update 4/30/2012



Analytical Parameter (with units)	Tank Excavation	Background 12/21/11					COGCC Table 910-1 Concentration Levels	Maximum based on Background
	Tank Excavation Bottom 12/21/11	#1	#2	#3	#4	#5		
Accutest Job #	D30595	D30572					-	-
Sample type (Composite/Discrete)	C	D	D	D	D	D	-	-
TPH (GRO) (mg/Kg)	ND	-	-	-	-	-	-	-
TPH (DRO) (mg/Kg)	50.1	-	-	-	-	-	-	-
TPH (GRO + DRO) (mg/Kg)	50.1	-	-	-	-	-	500	-
Benzene (mg/Kg)	ND	-	-	-	-	-	0.170	-
Toluene (mg/Kg)	ND	-	-	-	-	-	85	-
Ethylbenzene (mg/Kg)	ND	-	-	-	-	-	100	-
Xylenes (total) (mg/Kg)	ND	-	-	-	-	-	175	-
Acenaphthene (mg/Kg)	ND	-	-	-	-	-	1000	-
Anthracene (mg/Kg)	ND	-	-	-	-	-	1000	-
Benzo(A)anthracene (mg/Kg)	ND	-	-	-	-	-	0.22	-
Benzo(B)fluoranthene (mg/Kg)	ND	-	-	-	-	-	0.22	-
Benzo(K)fluoranthene (mg/Kg)	ND	-	-	-	-	-	2.2	-
Benzo(A)pyrene (mg/Kg)	ND	-	-	-	-	-	0.022	-
Chrysene (mg/Kg)	ND	-	-	-	-	-	22	-
Dibenzo(A,H)anthracene (mg/Kg)	ND	-	-	-	-	-	0.022	-
Fluoranthene (mg/Kg)	ND	-	-	-	-	-	1000	-
Fluorene (mg/Kg)	ND	-	-	-	-	-	1000	-
Indeno(1,2,3,C,D)pyrene (mg/Kg)	ND	-	-	-	-	-	0.22	-
Naphthalene (mg/Kg)	ND	-	-	-	-	-	23	-
Pyrene (mg/Kg)	ND	-	-	-	-	-	1000	-
Electrical Conductivity (mmhos/cm)	0.473	-	-	-	-	-	4	-
Sodium Adsorption Ratio (SAR)	4.28	-	-	-	-	-	12	-
pH	7.81	-	-	-	-	-	6-9	-
Arsenic (mg/kg)	5.5	4.3	3.5	5.6	5.1	3.9	0.39	6.2
Barium (mg/kg)	251	-	-	-	-	-	15000	-
Cadmium (mg/kg)	<1.1	-	-	-	-	-	70	-
Chromium (III) (mg/Kg)	42.9	-	-	-	-	-	120000	-
Chromium (VI) (mg/Kg)	<0.47	-	-	-	-	-	23	-
Copper (mg/kg)	8.7	-	-	-	-	-	3100	-
Lead (inorganic) (mg/kg)	11.2	-	-	-	-	-	400	-
Mercury (mg/kg)	<0.12	-	-	-	-	-	23	-
Nickel (mg/kg)	16.7	-	-	-	-	-	1600	-
Selenium (mg/kg)	<5.6	-	-	-	-	-	390	-
Silver (mg/kg)	<3.4	-	-	-	-	-	390	-
Zinc (mg/kg)	41.7	-	-	-	-	-	23000	-
% Solids	84.6	78.9	76.9	86.0	87.2	84.1	-	-

Notes:

- 1) ND = not detectible to the laboratory detection limit.
- 2) Results highlighted in yellow exceed Table 910-1 concentration levels. Results highlighted in Gray exceed Table 910-1, but are below background levels.
- 3) "-" indicates no analysis.
- 4) See site map for sample locations.

s:\pro\cto environmental\1112-06\_pcu\_f13-19g\civil\_3d\reclaim.dwg,5/3/12

LEGEND	
UT	FORMER UNDERGROUND STORAGE TANK
---	EDGE OF PAD
----	EXCAVATION AREA
∞	WELL HEAD
⊗	BACKGROUND SAMPLE LOCATION
⊗	ARSENIC: 4.3 mg/kg WITH ARSENIC LAB RESULTS

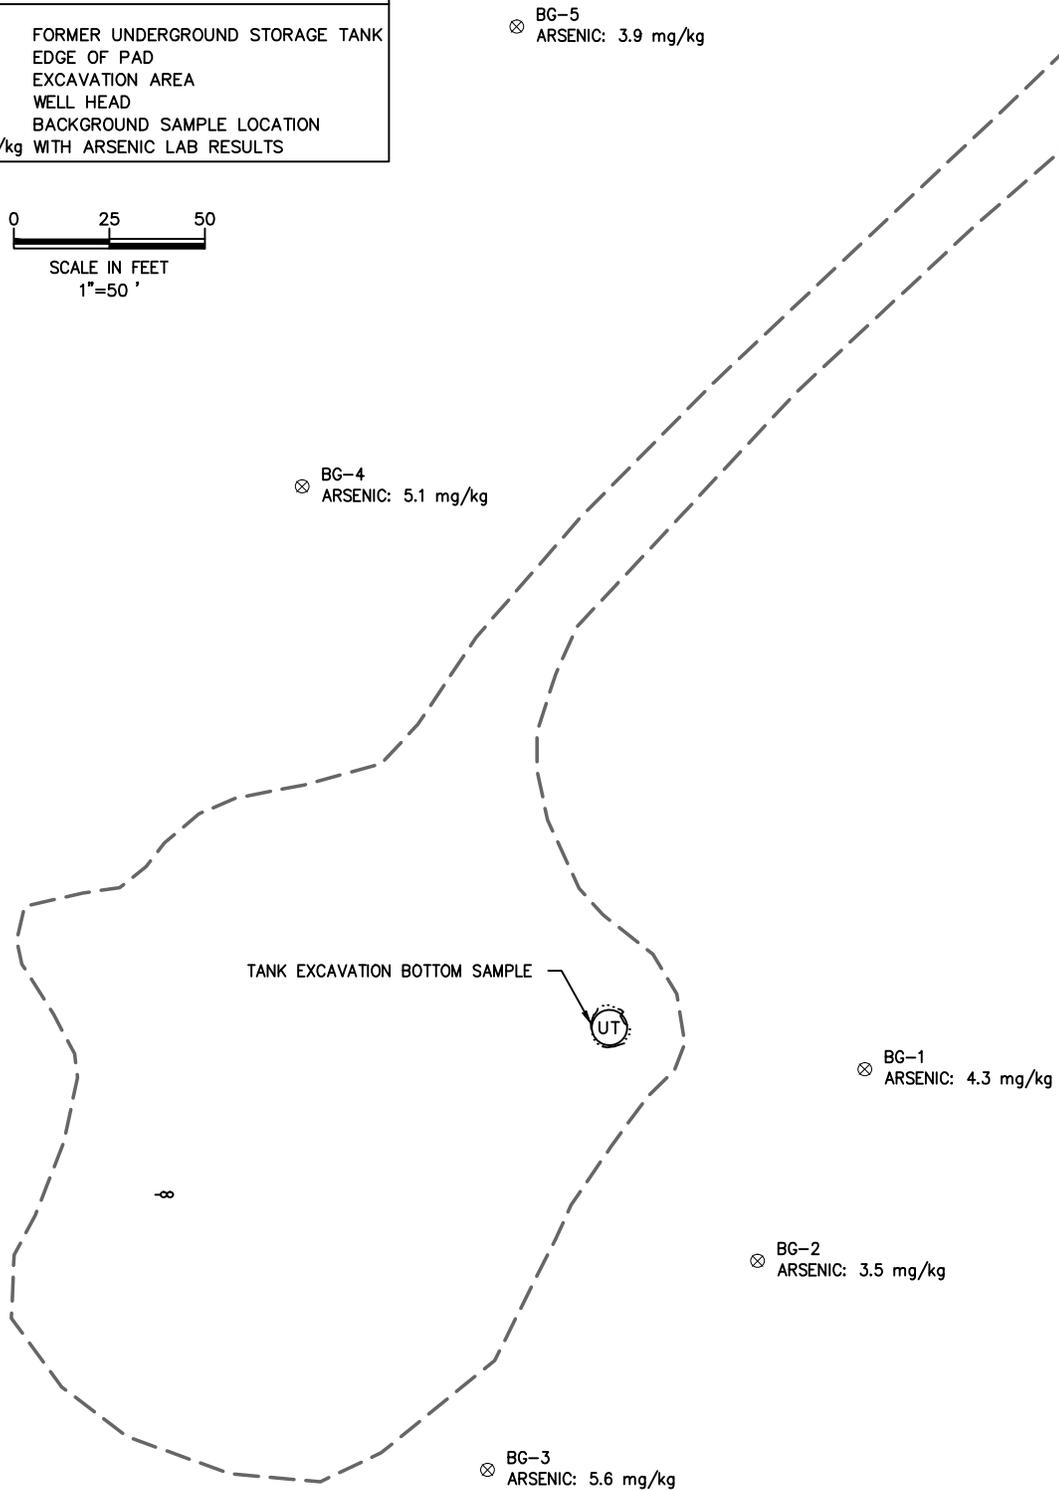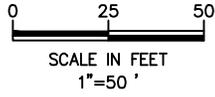

DESIGNED: CB	CHECKED: DK	FIGURE 1	NOTES:	
DATE: 5/3/12	DRAWN: DRF		DATE	REVISIONS
FILE NAME: reclaim	SHEET NO. 1 of 1	SCALE: 1"=50'		
PROJECT NO. 1112-06				

**KRW CONSULTING, INC.**  
8000 W. 14TH AVENUE, SUITE 200  
LAKEWOOD, COLORADO  
(303) 239-9011

FIGURE 1  
PICEANCE CREEK  
PCU F13-19G  
FINAL RECLAIM SITE MAP  
PREPARED FOR XTO ENERGY