Well Name:	Werner 31A-26-692	BILL BARRETT CORPORATION	
SHL:	SWSE Sec. 23 T6S R92W 6th PM	date updated	3/28/2012
		updated by	Mary Pobuda
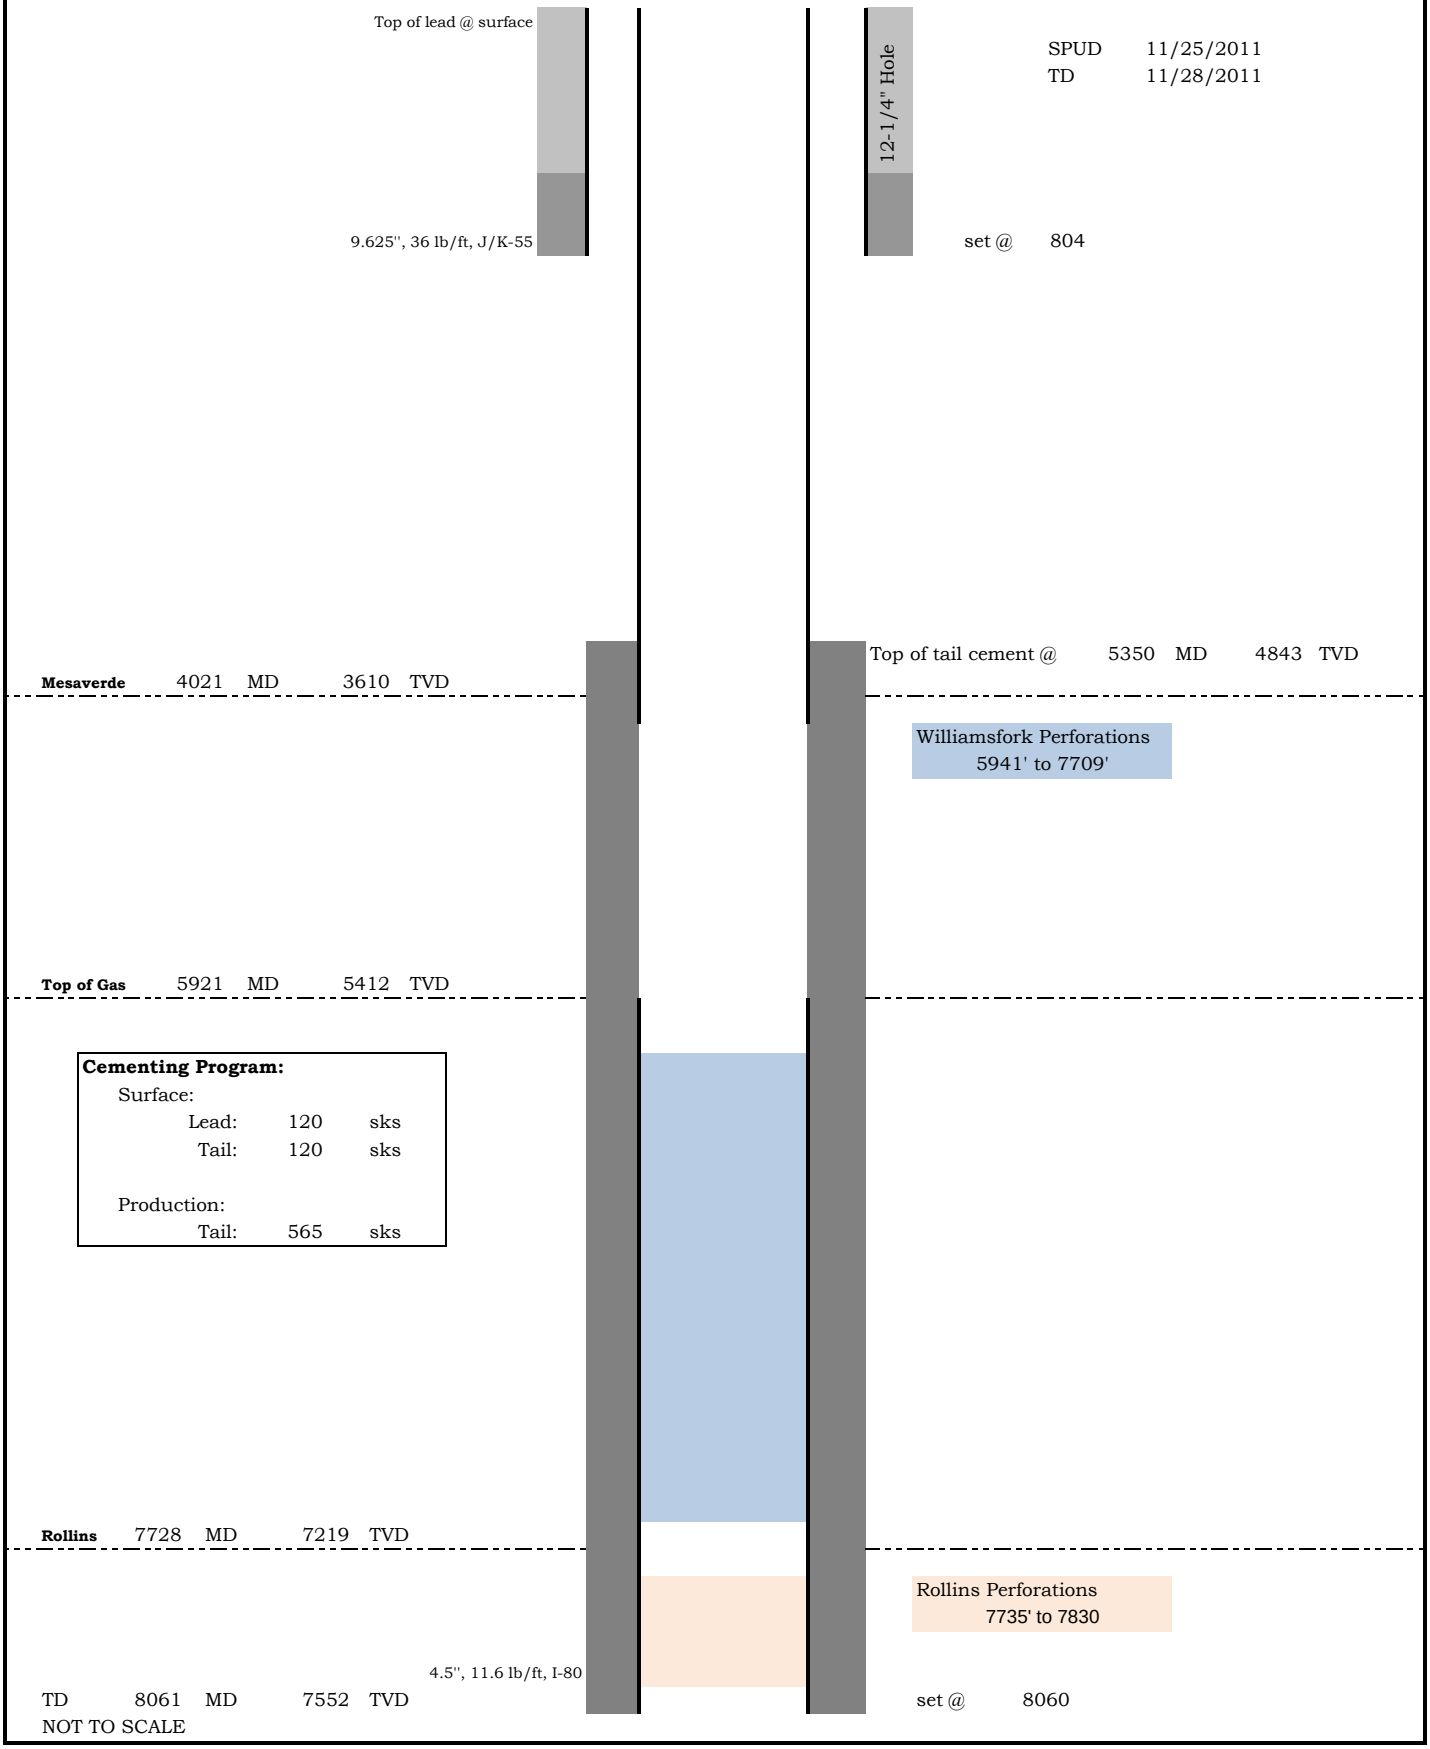
05-045-19235