

WPX Energy Rocky Mountain LLC

FINAL

RWF 443-31


API #05-045-19792-00

360' FSL x 2412' FWL - (SESW) - SHL

1744' FSL x 683' FEL - (NESE) - BHL

Sec. 31-T6S-R94W

Garfield County, Colorado

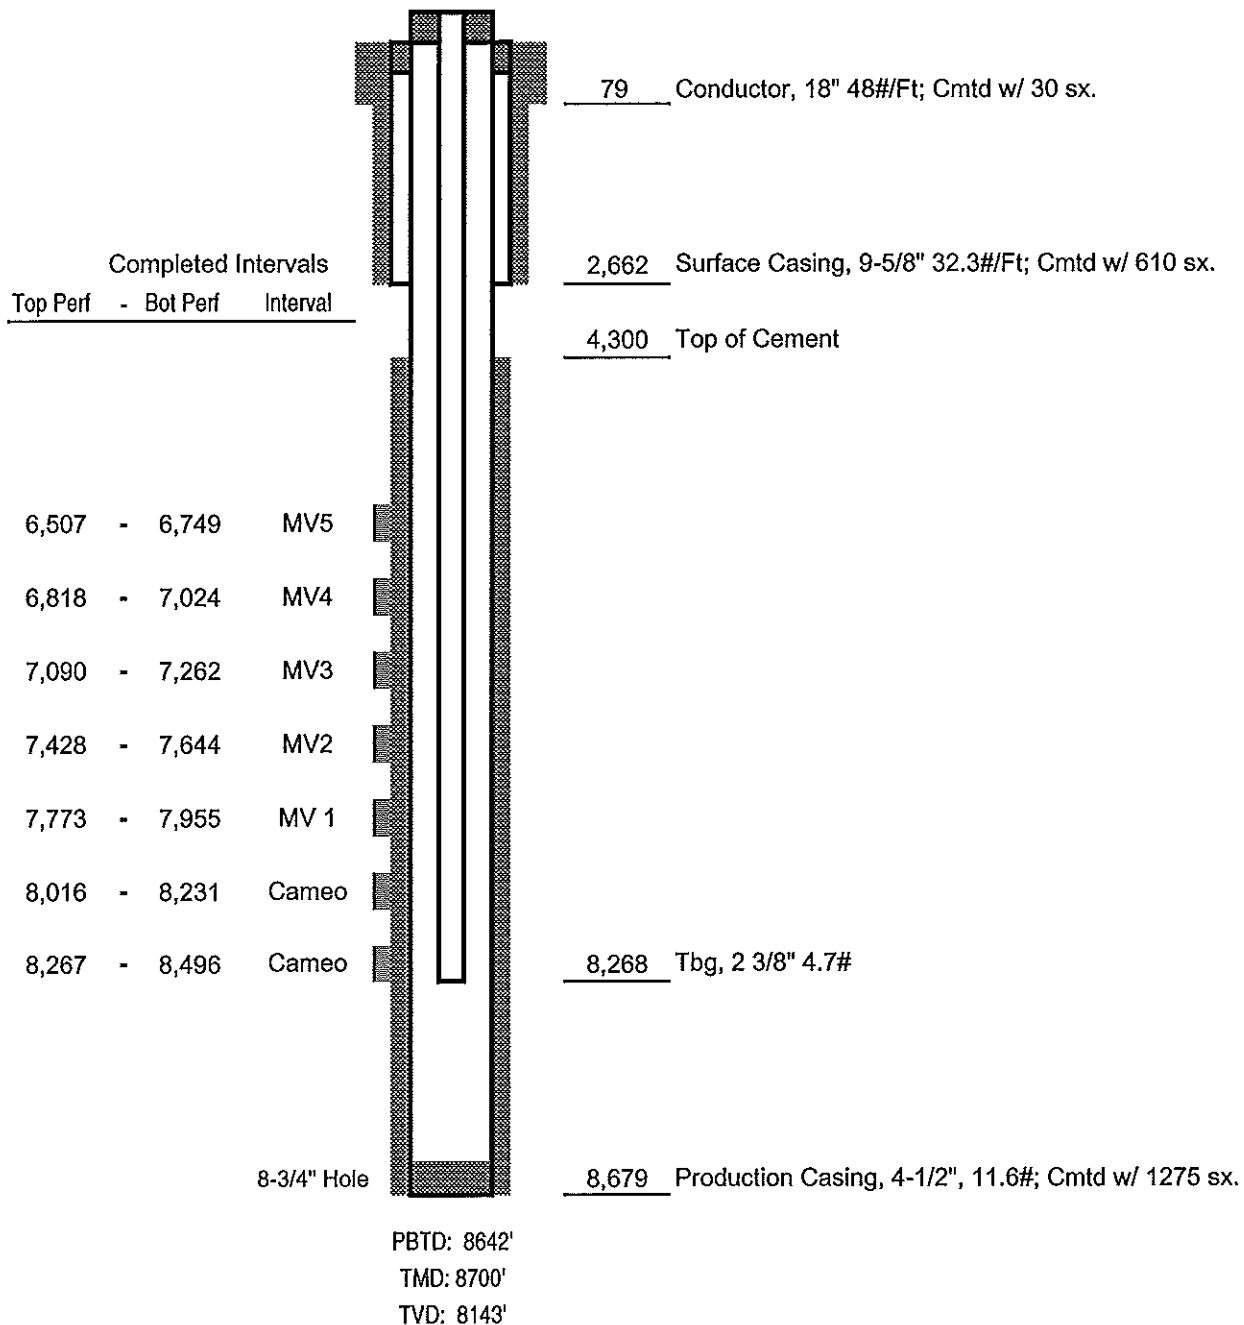

Not to Scale