

OXY USA INC.

Downhole Schematic


Well Name: Sniff Armor Federal 1 API: 05-011-06024

DATE: 05/12/2012 **AUTHOR:** D.Berg/K. Andrews

LOCATION: 1320' FNL & 1400' FEL of Section 17 Township 23S Range 48W, Bent Co., Colorado

GL: 3844'

KB: 3854'

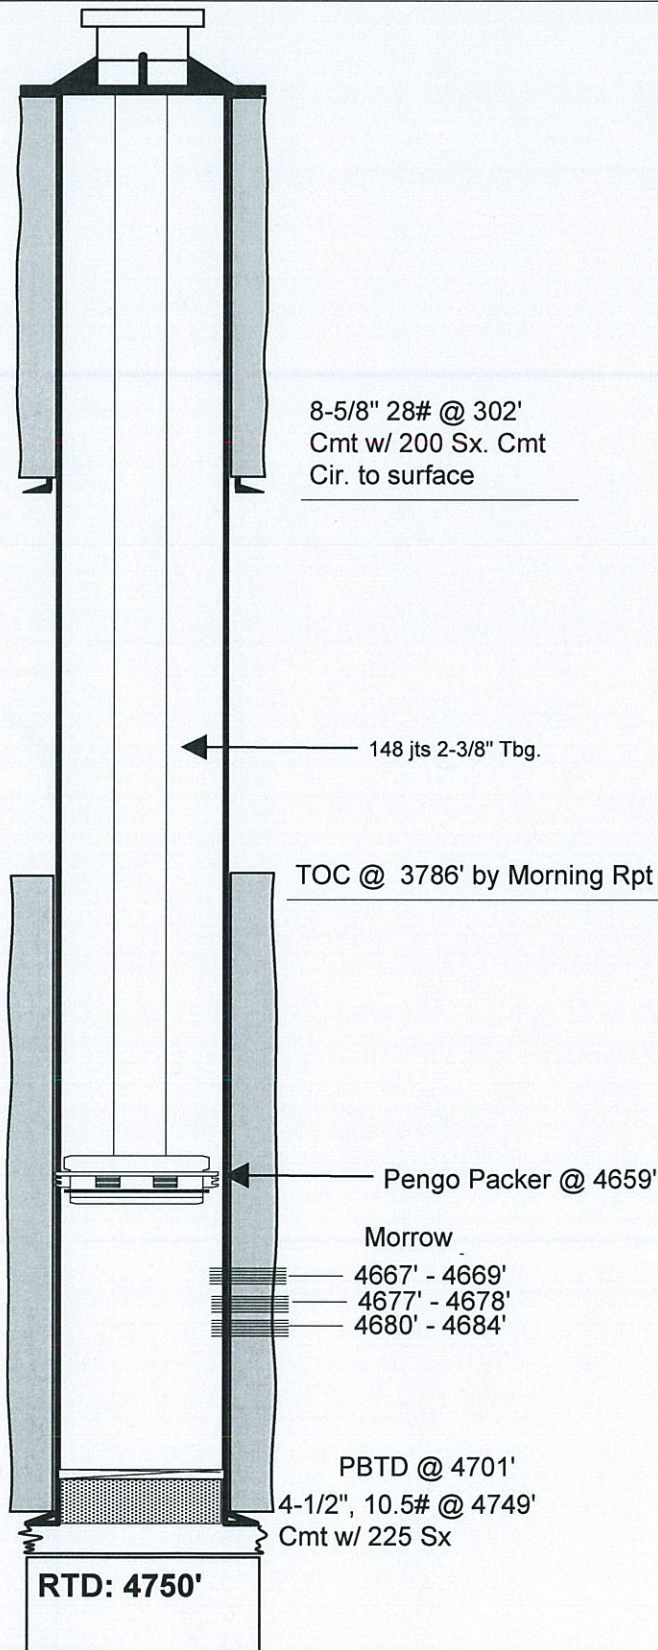

Notes:

Stone Corral: 1670'-1710'.
Suspect hole in tbg @ unknown depth. Suspect hole in csg @ unknown depth.

CURRENT COMPLETION