

WPX Energy Rocky Mountain LLC

FINAL

RWF 433-31


API #05-045-19784-00

397' FSL x 2412' FWL - (SEnw) - SHL

1799' FSL x 1921' FEL - (NWSE) - BHL

Sec. 31-T6S-R94W

Garfield County, Colorado

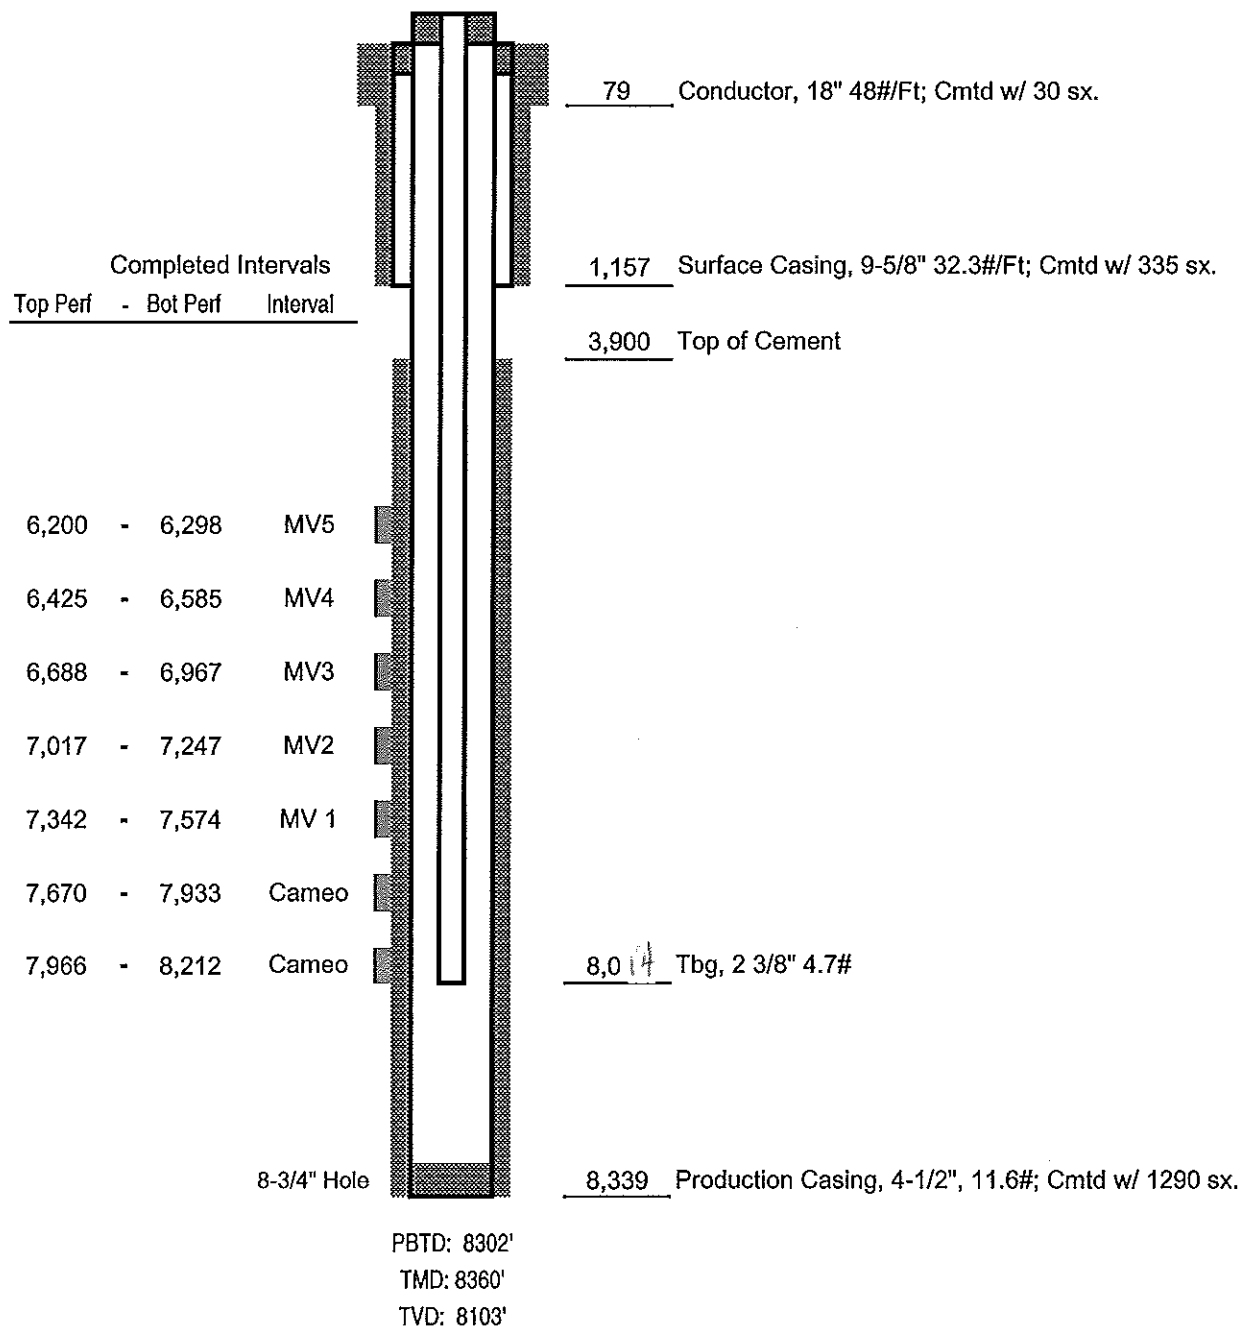

Not to Scale