

Downhole Schematic for SLATER 43-28



Project :DJ Basin

Area : Wattenberg

As Of : 03/13/2012

API # :05123346910000

County :


GL : 4962.0 ft

Surface Location : NWSE Sec 28 T3N - R68W 6th P

BHL :

KB to GL : 13.0 ft

KB : 4975.0 ft

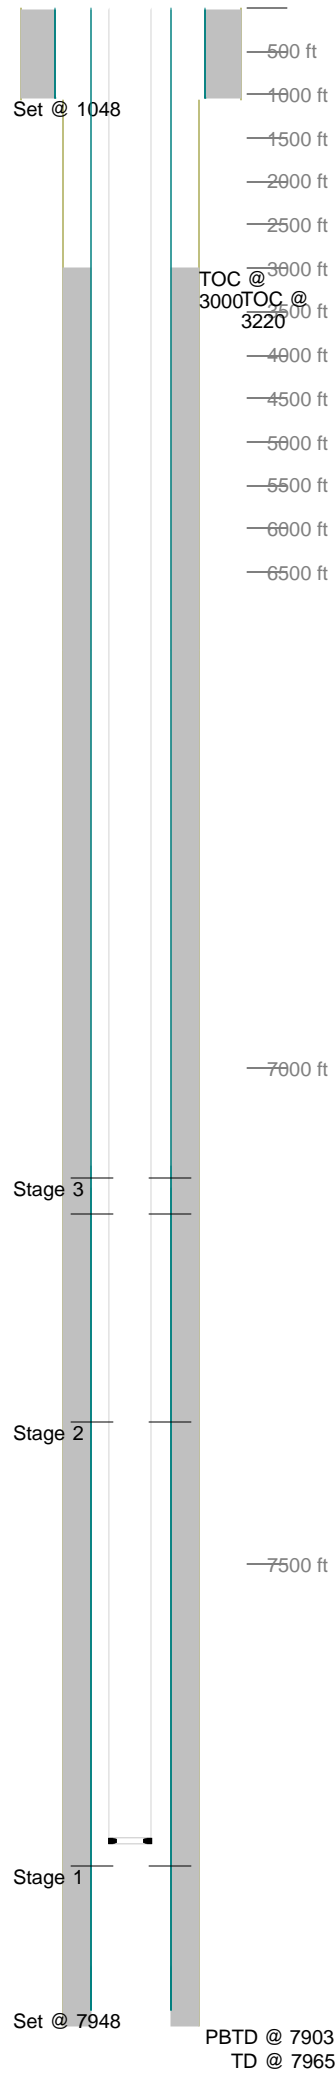

Casing Details									
Section	Hole	Casing	Mass	Set At	Length	Thread	Grade	Description	
Surface	12.750	8.625	0	1,048	1	ST&C		Shoe	
		8.625	24	1,047	41	ST&C	J-55	Casing	
			0	1,006	0	ST&C		Baffle plate	
		8.625`	24	1,006	992	ST&C	J-55	Casing	
			0	15	1			Top Wellhead	
			0	14	1			Running tool	
		8.625	24	13	17	ST&C	J-55	Landing Joint	
Production	7.875	4 1/2"	0	7,948	1			Float Shoe	
		4 1/2"	11.6	7,947	41	LT&C	SB-80	4 1/2" casing	
		4 1/2"	0	7,905	1			Float Collar	
		4 1/2"	11.6	7,904	783	LT&C	SB-80	4 1/2" casing	
		4 1/2"	11.6	7,121	23	LT&C	SB-80	4 1/2" marker jt	
		4 1/2"	11.6	7,098	7,083	LT&C	SB-80	4 1/2" casing	
		4 1/2"	11.6	15	18	LT&C	SB-80	4 1/2" landing jt	
Cement Details									
Section	Sequence		Top	Density	Blend / Additives				
Surface	Lead		15	14.5	Type III Cement / 1.5 % CaCl + .15 #/sk celloflake + .08 #/sk static free				
Production	Lead		3,000	12.5	Premium Lite / 6% Gel + .7% FL-63 + .2% CD32 + .2 ASA 301+6% BWOC bentonite				
					fresh water				
	Tail		6,578	13.5	50:50 / 3% Gel + .6% FL32 + .1% SMS + 20% CF				
Tubing and Downhole Equipment									
O.D.	Length	Depth	Description						
0.000	13.00	13.00	KB						
2.375	7,761.09	7,774.09	236 JTS 4.7# J55 EUE 8RD						
2.375	1.90	7,775.99	Sn w/ Partial Pump Out Sub						
Perforations									
Stage 1	Date	From	To	Shots	Stage 3	02/15/2012	7,355	7,378	46
		7,804	7,829	50		Date	From	To	Shots
Stage 2	Date	From	To	Shots		02/15/2012	7,146	7,168	88
							7,110	7,119	36
Frac Summary									
Stage 1 : 7,804 - 7,829, 50 - 0.420" shots, 3839 bbls of Hybrid pHaserFrac, 249400 lbs of 20/40 Brown									
Report Date: 02/15/2012									
Stage 2 : No Frac									
Stage 3 : 7,110 - 7,168, 124 - 0.420" shots, 2575 bbls of Hybrid pHaserFrac, 101840 lbs of 30/50 Sand									
Report Date: 02/18/2012									
Bridge Plug Details									
Depth	Date Set	Plug Type	Sacks Cement						
7,420.0	02/17/2012		0						
7,220.0	02/19/2012		0						
at 7,420.0 drilled out 03/13/2012									
at 7,220.0 drilled out 03/13/2012									