

N 89°02'04" W T 6 S

**CBC**

**13D-22-692**  
**SURFACE LOCATION**

**1185 FSL**  
**2500 FWL**

**LATITUDE**

**39.508567° N**

**LONGITUDE**

**107.653429° W**

**NORTHING**

**1617325.1**

**EASTING**

**2392466.8**

REBAR AND  
ALUMINUM CAP  
LS 19598

GARFIELD COUNTY  
SURVEYOR BRASS  
CAP 1973

SEE ADDENDUM FOR VISIBLE  
IMPROVEMENTS WITHIN 400'  
OF THIS LOCATION

REBAR AND  
ALUMINUM CAP  
LS 36572

GARFIELD COUNTY  
SURVEYOR BRASS  
CAP 1973

REBAR AND  
ALUMINUM CAP  
LS 38050

REBAR AND  
ALUMINUM CAP  
LS 10732

REBAR AND  
ALUMINUM CAP  
LS 17492

GARFIELD COUNTY  
SURVEYOR BRASS  
CAP 1973

**22**


**BOTTOM HOLE LOCATION**

**2461 FSL, 660 FWL**

**LAT: 39.512016° N**

**LONG: 107.659991° W**

**SURFACE HOLE LOCATION**  
**EXISTING GROUND ELEVATION: 5777.2**  
**PROPOSED PAD ELEVATION: 5778.0**

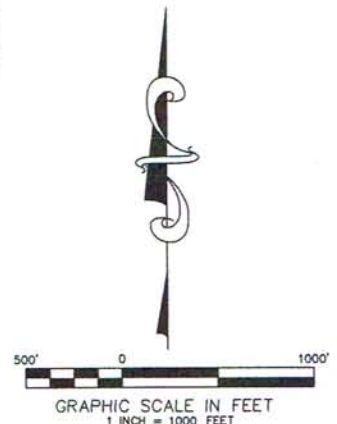

## SURVEYORS STATEMENT:

I, JAMES A. KALMON, A REGISTERED LAND SURVEYOR IN THE STATE OF COLORADO DO HEREBY CERTIFY THAT THE SURVEY SHOWN HEREON WAS PREPARED BY ME OR UNDER MY DIRECT SUPERVISION AND THAT THIS PLAT IS A TRUE REPRESENTATION THEREOF. I ALSO CERTIFY THAT THE LOCATION HAS BEEN STAKED ON THE GROUND AS SHOWN ON THIS PLAT.

*James A. Kalmon*  
1-23-12

JAMES A. KALMON, COLORADO REGISTRATION NO. 38050  
FOR AND ON BEHALF OF ECLIPSE SURVEYING, INC.

## LEGEND:

FIELD LOCATED SECTION  
MONUMENTS AS DESCRIBED

SURFACE HOLE LOCATION

BOTTOM HOLE LOCATION

CALCULATED SECTION  
CORNER LOCATION

## NOTES:

- 1) ELEVATIONS BASED ON N.A.V.D. 1988
- 2) LATITUDES AND LONGITUDES ARE BASE ON NAD 83, COLORADO CENTRAL ZONE.
- 3) WELL MEASURED 90° FROM SECTION LINES.
- 4) THE BASIS OF BEARING IS FROM GPS OBSERVATION RESULTING IN THE BEARING BETWEEN THE FOUND MONUMENTS AS SHOWN.
- 5) ELEVATION MASK SET TO 15°
- 6) PDOP SET TO 6



**ECLIPSE**  
surveying

111 E. THIRD ST., SUITE 208, RIFLE, CO 81650  
(970) 625-3048

REV. DATE:

SURVEY DATE: 01/04/12

RELEASE DATE: 01/23/12

SCALE: 1" = 1000'

SHEET: 1 of 2

PROJECT #: CBC PAD 1

**Bill Barrett Corporation**

SE<sup>1</sup>/<sub>4</sub>SW<sup>1</sup>/<sub>4</sub>, SECTION 22  
T. 6 S., R. 92 W. of the 6th. P.M.  
GARFIELD COUNTY, COLORADO

