

Downhole Schematic for SLATER 6-4-28



Project :DJ Basin

API # :05123346890000

Surface Location : NWSE Sec 28 T3N - R68W 6th P

Area : Wattenberg

County :


BHL :

As Of : 03/16/2012

GL: 0.0 ft

KB to GL : ft

KB : 0.0 ft

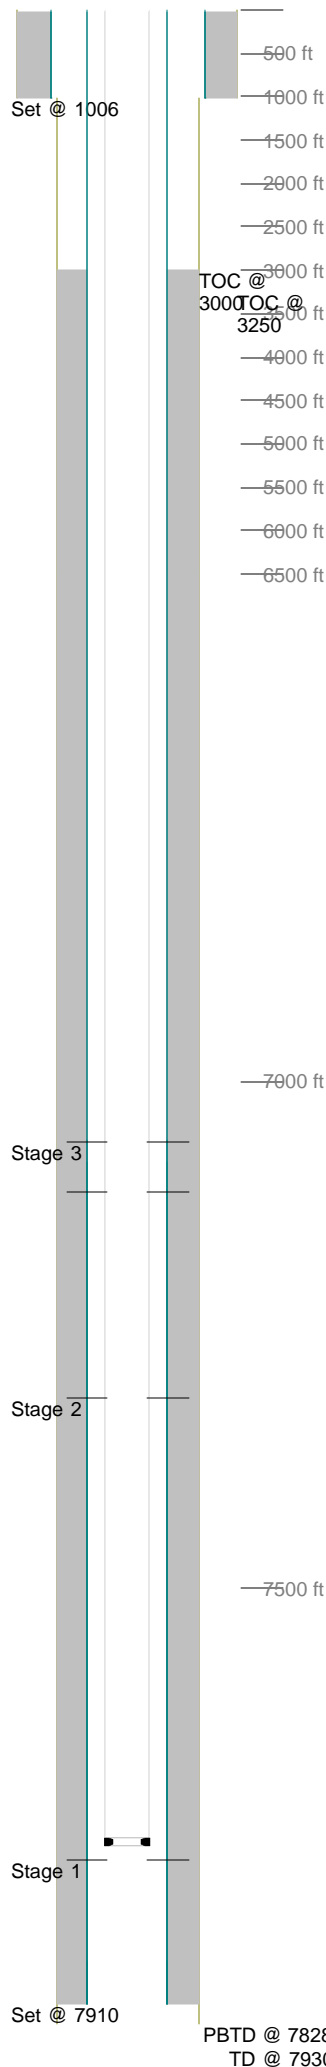

Casing Details								
Section	Hole	Casing	Mass	Set At	Length	Thread	Grade	Description
Surface	12.250	8.625	0	1,006	1	ST&C		TopCo Guide Shoe
		8.625	24	1,005	990	ST&C	J-55	Jts Csg
		8.625	0	15	1			Larkin Well Head
		8.625	24	14	18	ST&C	J-55	Landing jt w/ running tool
Production	7.875	4 1/2"	0	7,910	1			Float Shoe
		4 1/2"	11.6	7,909	41	LT&C	SB-80	4 1/2" casing
		4 1/2"	0	7,867	1			Float Collar
		4 1/2"	11.6	7,866	786	LT&C	SB-80	4 1/2" casing
		4 1/2"	11.6	7,080	21	LT&C	SB-80	4 1/2" marker jt
		4 1/2"	11.6	7,059	7,043	LT&C	SB-80	4 1/2" casing
		4 1/2"	11.6	16	18	LT&C	SB-80	4 1/2" landing jt
Cement Details								
Section	Sequence	Top	Density	Blend / Additives				
Surface	Lead	15	14.5	Type III Cement / 0.08 lbs/sk Static Free + 1.5% bwoc Calcium Chloride +0.15 lbs/sk Cello Flake + 60.5% Fresh Water				
Production	Lead	3,000	12.5	Premium Life Cement / .7% FL-52 +6% Bentonite + 0.2% CD-32 + 3 lbs/sack CSE-2 +0.2 % asa-301 @ 12.5 ppg				
	Tail	6,487	13.5	Poz 50:50 / 0.6% FL-52 + 3% Bentonite + 0.1 % SMS +20 % S-8 @ 13.5 PPG				
Tubing and Downhole Equipment								
O.D.	Length	Depth	Description					
0.000	13.00	13.00	KB					
2.375	7,733.25	7,746.25	235 Jts 4.7# J55 Eue 8Rd					
2.375	1.90	7,748.15						
Perforations								
Stage 1	Date	From	To	Shots	Stage 3	Date	From	To
	02/15/2012	7,768	7,790	44		02/15/2012	7,313	7,333
Stage 2	Date	From	To	Shots				
						02/15/2012	7,110	7,126
							7,060	7,070
								40
								64
								40
Frac Summary								
Stage 1 : 7,768 - 7,790, 44 - 0.420" shots, 3767 bbls of Hybrid pHaserFrac, 251160 lbs of 30/50 Ottawa								
Report Date: 02/17/2012								
Stage 2 : 7,313 - 7,333, 40 - 0.420" shots, 1865 bbls of Hybrid pHaserFrac, 150000 lbs of 30/50 Sand								
Report Date: 02/18/2012								
Stage 3 : 7,060 - 7,126, 104 - 0.420" shots, 2079 bbls of Hybrid pHaserFrac, 150000 lbs of 30/50 Sand								
Report Date: 02/18/2012								
Bridge Plug Details								
Depth	Date Set	Plug Type	Sacks	Cement				
7,400.0	02/17/2012		0					
7,190.0	02/19/2012		0					
at 7,400.0 drilled out 03/16/2012								
at 7,190.0 drilled out 03/16/2012								