


Proposed
 As is

BRUTUS STATE 33-14 1V GL: 6151.0, KB: 18.0
 Sec 14, 14S, 62W El paso County, Colorado

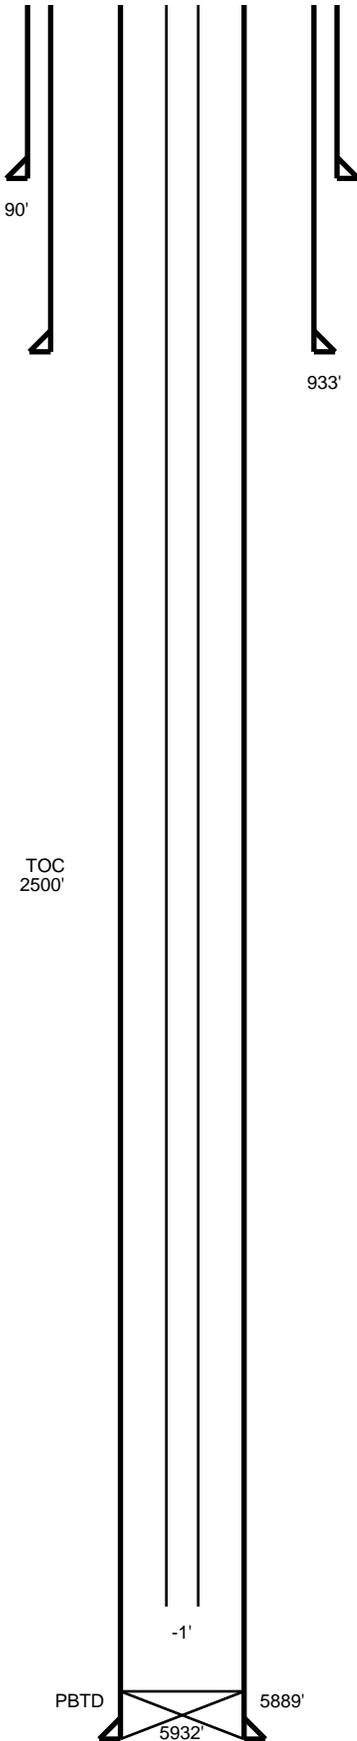

	Size	Weight	Grade	Depth	Sks/Cmt
Conductor	16	65	ARJ-55	90	
Surface	8 5/8	24	J-55	933	400.0
Intermediate					
Production	5 1/2	17	HCP-110	5932	380.0
Liner					
Tubing					
Cement Top				2500	

STAGE	ZONE 1	ZONE 2
1	5674-5684	5700-5710

Stage	Date	Av.Rate	Av.Press	Proppant	CleanFluid	Tracer	Screenout
1							
Totals:				0	0		

Formation or Depth	Top	Sand Type	Amount
		Gross Sand Drilled	
		Gross Sand Logged	
		Net Sand	
		Net Pay	

Log Type	Date	OH/CH	Top	Bottom	Run By
USIT	04/13/2012	Cased	5871	400	SLB
Temperature/GR/CCL	04/14/2012	Cased		5875	SLB

Move In	Spud Date	TD Date	Rig Release	1st Prod	Full Sales
03/26/2012	03/29/2012	04/03/2012	04/09/2012	(Missing)	(Missing)

Tbg Date	Depth	OD	ID	Weight	Grade	Thread	Csg Size	1st Jt	# Joints	Coil

TOC
2500'

PBD 5889'
 5932'