Well Name:	**Weinzenreid 13-23**	**BILL BARRETT CORPORATION**	
SHL:	NWSW Sec. 23 T6N R67W	date updated	**5/22/2012**
		updated by	**Megan Finnegan**
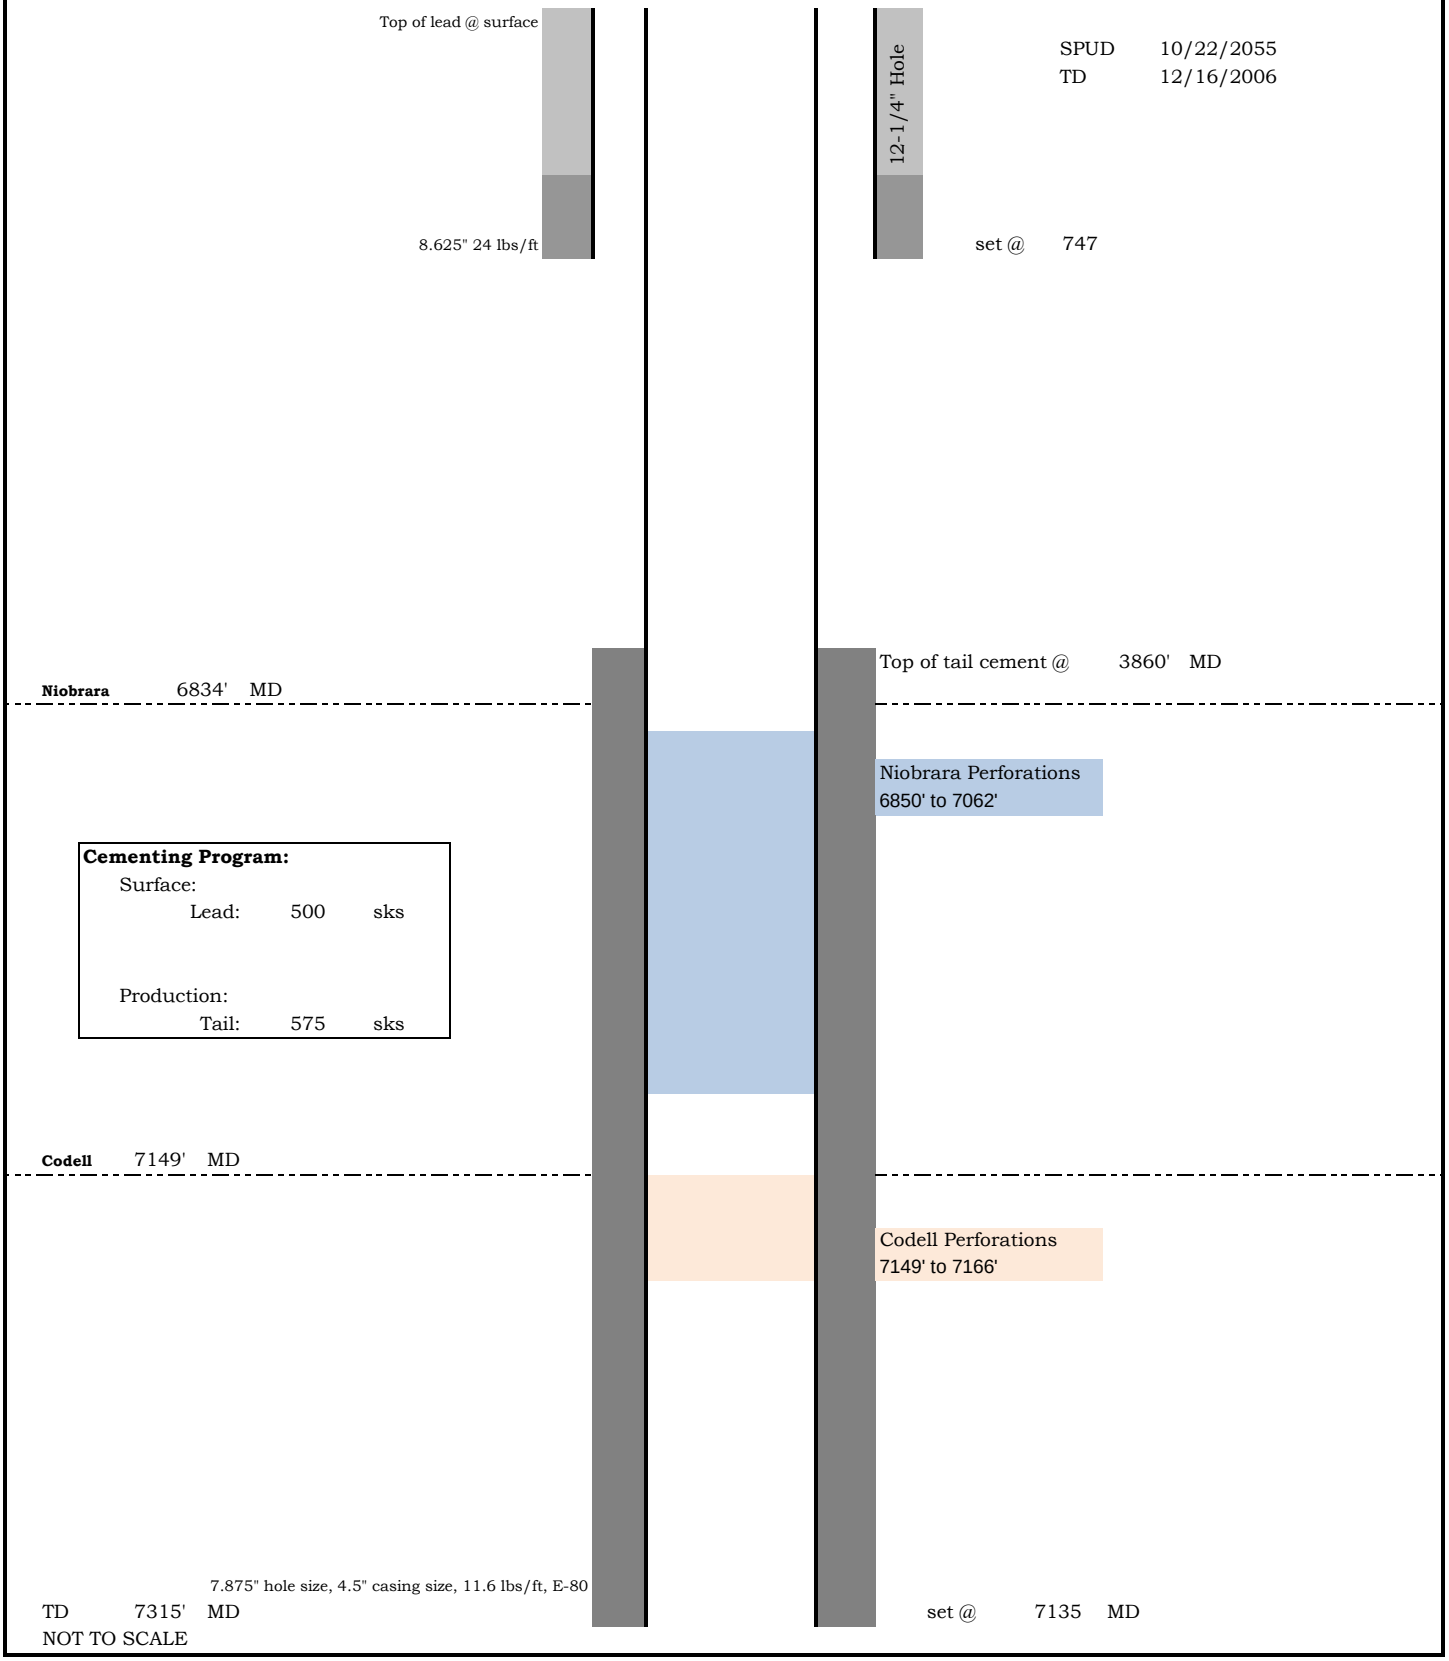
05-123-22795 AS DRILLED