

Job # 12008 Handke #4

Inv # 1818

High Prairie Surveying of Kiowa, Colorado has in accordance with a request from **Robert Anderson, Overland Resources** has determined the location of **Handke #4** to be 615 feet FSL, and 633 feet FEL, (BHL 1286' FSL-1723' FEL), (90° off Section lines) of SECTION **10**, Township **3s**, Range **64w** of the 6th Principal Meridian, **Adams County**, Colorado.

Date: Staked on 5/18/12 drawn on 5/18/12.

Re: Staked by Keith Westfall


Drawn: Drawn by Elijah Frane

## Location Drawing



The Handke #3 well falls approx. 21' North of proposed well pad.

Overland Resources  
SE1/4 Sec. 10-3s-64w  
Handke #4  
Adams Co., Colorado

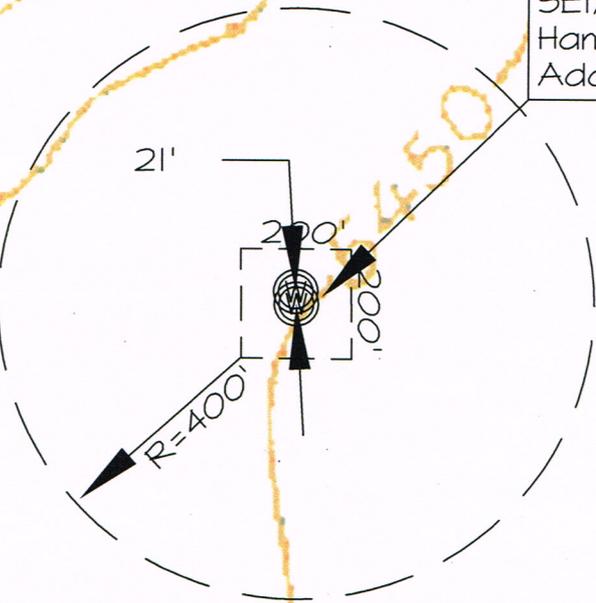

54