


WELL LOCATION CERTIFICATE

THIS MAP DOES NOT REPRESENT A BOUNDARY SURVEY

Weld County Road 6

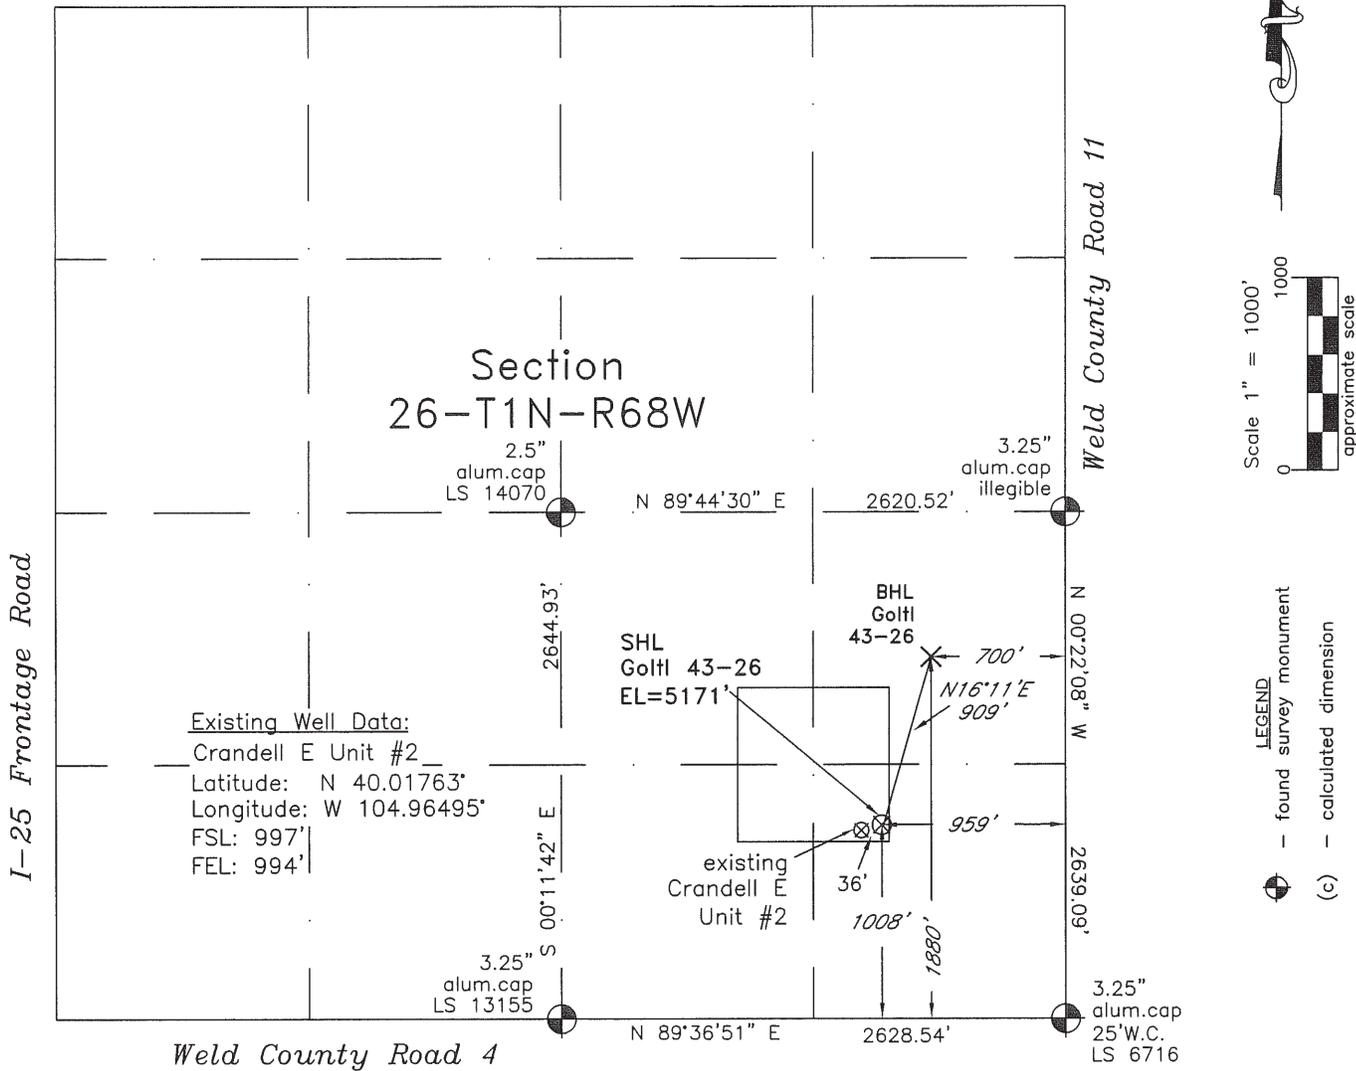

LEGEND
 — — — found survey monument
 (c) — — — calculated dimension

Existing Well Data:
 Crandell E Unit #2
 Latitude: N 40.01763°
 Longitude: W 104.96495°
 FSL: 997'
 FEL: 994'

In accordance with a request from Doug Pearlman of EnCana Oil & Gas (USA) Inc., Frederick Land Surveying, Inc. has determined the location of the Goltl 43-26 well site to be SHL: 1008' FSL and 959' FEL, (BHL: 1880' FSL and 700' FEL) as measured at ninety (90) degrees from the section lines of Section 26, Township 1 North, Range 68 West, 6th Principal Meridian, City and County of Broomfield, CO.

Proposed Surface Hole Data:

Latitude: N 40.01767° (BHL 40.02006°)
 Longitude: W 104.96483° (BHL 104.96390°)
 Nearest: Building 575' northeast Above Ground Utility 924' east
 Public Road 944' east Railroad 4100' northeast
 Property Line 354' west
 PDOP: 2.3

Notes:

- 1) Bearings and distances based upon NAD 83 Colorado North State Plane Coordinates using RTK GPS observations taken on 3/15/2010 by operator Craig Burke.
- 2) Conversion factor to ground (1.000280465).
- 3) Elevations based on NAVD 88 GPS heights and Geoid 2003 corrections.
- 4) See improvement map for visible improvements within 400 feet of pad site.
- 5) The location falls on natural ground.

NOTICE: According to Colorado law you must commence any legal action based upon any defect in this W.L.C. within three years after you first discover such defect. In no event may any action based upon any defect in this W.L.C. be commenced more than ten years from this said date of the certification shown hereon.

I hereby certify that this Well Location Certificate was prepared by me or under my direct supervision on 3/23/10 for and on behalf of EnCana Oil & Gas (USA) Inc. and it is not a Land Survey Plat, nor an Improvement Survey Plat, and that it is to be relied upon for establishment of fences, buildings, or other future improvement lines.

Alex Rondani, Surveyor #34176
 Job #: 09006.008 3-25-2010