



Schematic - Current
Well Name: CROW VALLEY 7-62-22 2H

Qtr/Qtr, Block, Sec, Town, Range SE/SW Sec. 22 T7N R62W	License # 400253489	Field Name WILDCAT FOR UNNAMED FIELD	State/Province COLORADO	Country USA
Well Configuration Type HORIZONTAL	Original KB Elevation (ft) 4,942.00	KB-Ground Distance (ft) 25.00	KB-Casing Flange Distance (ft)	KB-Tubing Head Distance (ft)

Most Recent Job

Job Category DRILLING	Primary Job Type ORIGINAL DRILLING	Secondary Job Type	Start Date 4/29/2012	End Date
--------------------------	---------------------------------------	--------------------	-------------------------	----------

TD: 7,372.0

HORIZONTAL - CROW VALLEY 7-62-22 2H BP 01, 5/14/2012 2:53:51 PM

MD (ftKB)	Incl (°)	TVD (ftKB)	Vertical schematic (actual)	
-117.1	0.5	-117.1		
-112.5	0.5	-112.5		
24.9	0.5	25.0		
28.5	0.5	28.6		
89.9	0.5	89.9		
664.4	0.5	664.4		
665.7	0.5	665.7		
710.0	0.5	710.0		
711.9	0.5	711.9		
5,567.3	0.6	5,567.0		
5,572.5	0.6	5,572.2		
5,720.1	1.2	5,719.8		
6,149.9	13.3	6,144.5		
7,262.1	13.3	7,226.9		
7,360.2	13.3	7,322.4		

Qtr/Qtr, Block, Sec, Town, Range SE/SW Sec. 22 T7N R62W	License # 400253489	Field Name WILDCAT FOR UNNAMED FIELD	State/Province COLORADO	Country USA
Well Configuration Type HORIZONTAL	Original KB Elevation (ft) 4,942.00	KB-Ground Distance (ft) 25.00	KB-Casing Flange Distance (ft)	KB-Tubing Head Distance (ft)


Most Recent Job

Job Category DRILLING	Primary Job Type ORIGINAL DRILLING	Secondary Job Type	Start Date 4/29/2012	End Date
--------------------------	---------------------------------------	--------------------	-------------------------	----------

TD: 7,372.0

HORIZONTAL - CROW VALLEY 7-62-22 2H, 5/14/2012 6:00:00 AM

Directional schematic (actual)

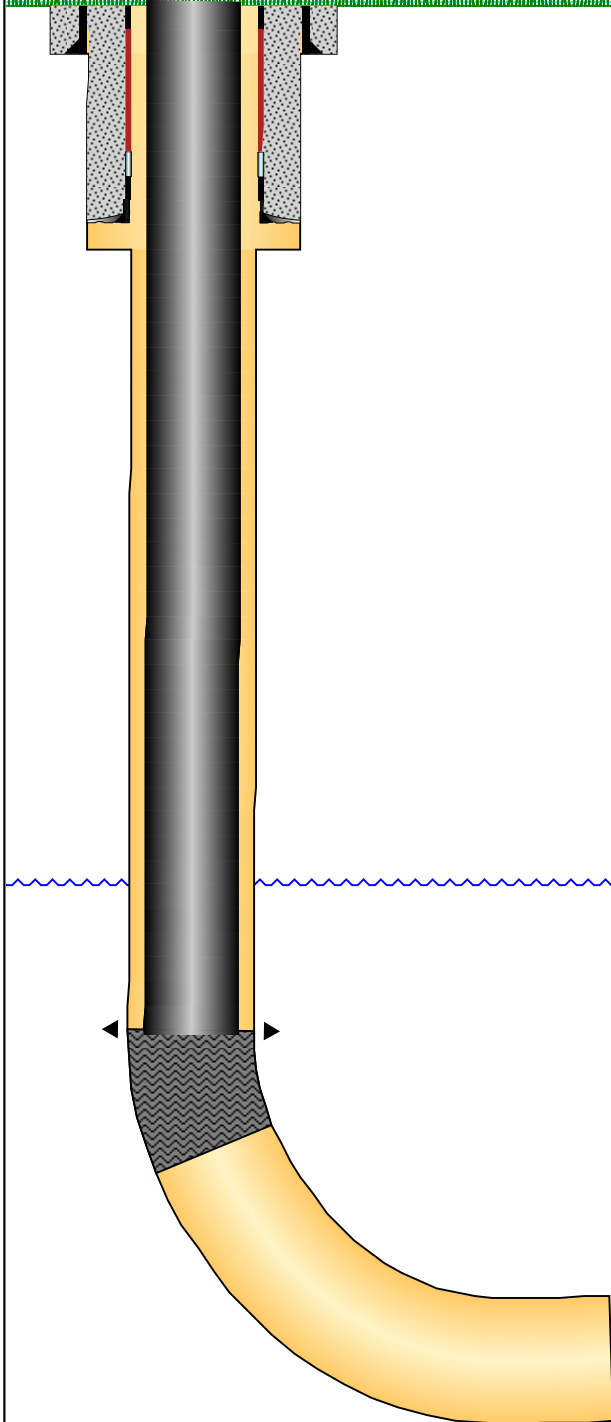

Qtr/Qtr, Block, Sec, Town, Range SE/SW Sec. 22 T7N R62W	License # 400253489	Field Name WILDCAT FOR UNNAMED FIELD	State/Province COLORADO	Country USA
Well Configuration Type HORIZONTAL	Original KB Elevation (ft) 4,942.00	KB-Ground Distance (ft) 25.00	KB-Casing Flange Distance (ft)	KB-Tubing Head Distance (ft)

Most Recent Job

Job Category DRILLING	Primary Job Type ORIGINAL DRILLING	Secondary Job Type	Start Date 4/29/2012	End Date
--------------------------	---------------------------------------	--------------------	-------------------------	----------

TD: 7,372.0

HORIZONTAL - CROW VALLEY 7-62-22 2H BP 01, 5/14/2012 6:00:00 AM

Directional schematic (actual)

Sidetrack 01 directional

