


# WELL LOCATION FOR MERCHANT ENERGY PARTNERS, LLC

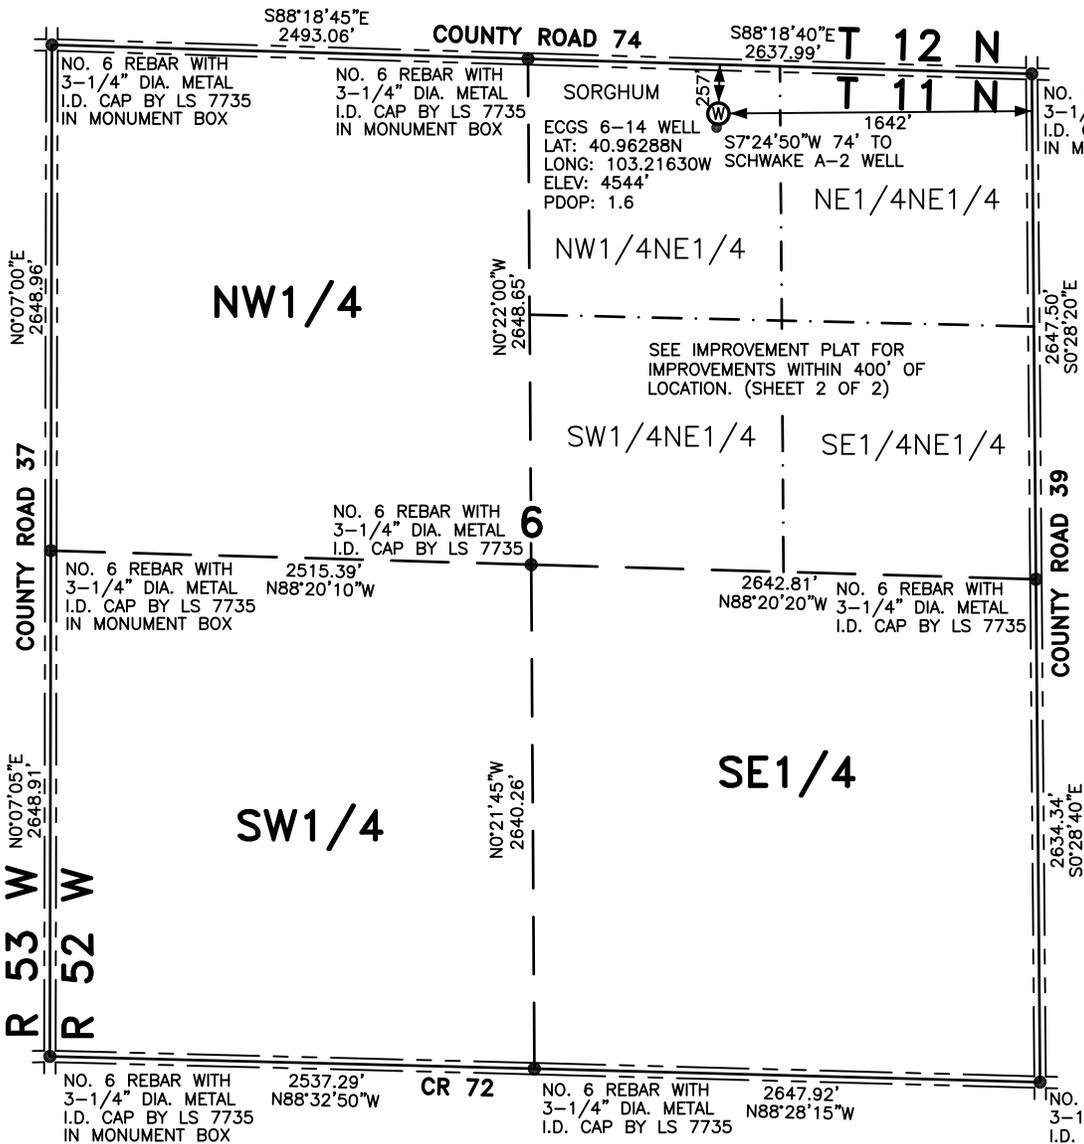

### NOTES

BEARINGS SHOWN HEREON ARE BASED UPON RTK GPS OBSERVATIONS

SEE IMPROVEMENT PLAT FOR IMPROVEMENTS WITHIN 400' OF LOCATION. (SHEET 2)

USGS QUAD MAP: PADRONI NW, COLO.


LAT/LONG VALUES ARE NAD83

ELEVATIONS BASED ON NAVD 1988

ALL DISTANCES TO SECTION LINES ARE MEASURED PERPENDICULAR TO AND ARE AT RIGHT ANGLES TO SAID SECTION LINES.

### LEGEND

- FIELD SURVEYED WELL LOCATION
- ROAD
- FENCE

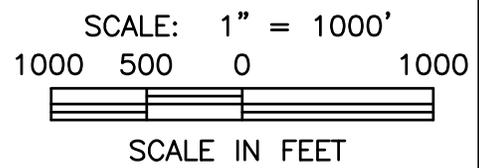

THIS WELL LOCATION PLAT HAS BEEN PREPARED FOR MERCHANT ENERGY PARTNERS, LLC, TO LOCATE THE ECGS 6-14 WELL BEING 1642 FEET FROM THE EAST LINE AND 257 FEET FROM THE NORTH LINE IN THE NW1/4NE1/4 OF SECTION 6, TOWNSHIP 11 NORTH, RANGE 52 WEST OF THE 6TH P.M., LOGAN COUNTY, COLORADO. THE SURFACE ELEVATION AT THIS POINT IS 4544 FEET. THIS IS NOT A LAND SURVEY PLAT.



<b>LEIBERT-McATEE &amp; ASSOCIATES, INC.</b>		
P.O. BOX 442		615 SOUTH TENTH AVENUE
STERLING, CO 80751		970-522-1960
FIELD DATE: 3-28-12	DWG DATE: 4-20-12	GPS OPERATOR: DARREN VEAL
ECGS 6-14	DWG NO. 376-12	SHEET 1 OF 2