


Well Name: Boulder PC G11-20D

Surface Location: Boulder PC G11-20D Pad Sec.11-T4N-R65W
 North American Datum 1983 US State Plane 1983 Colorado Northern Zone
 Ground Elevation: 4683.0

+N/-S	+E/-W	Northing	Easting	Latitude	Longitude	Slot
0.0	0.0	1360974.47	3241057.14	40.321050	-104.635470	
		Original Well Elev	WELL @ 4696.0ft (Original Well Elev)			

NOBLE ENERGY INC WELD COUNTY CO

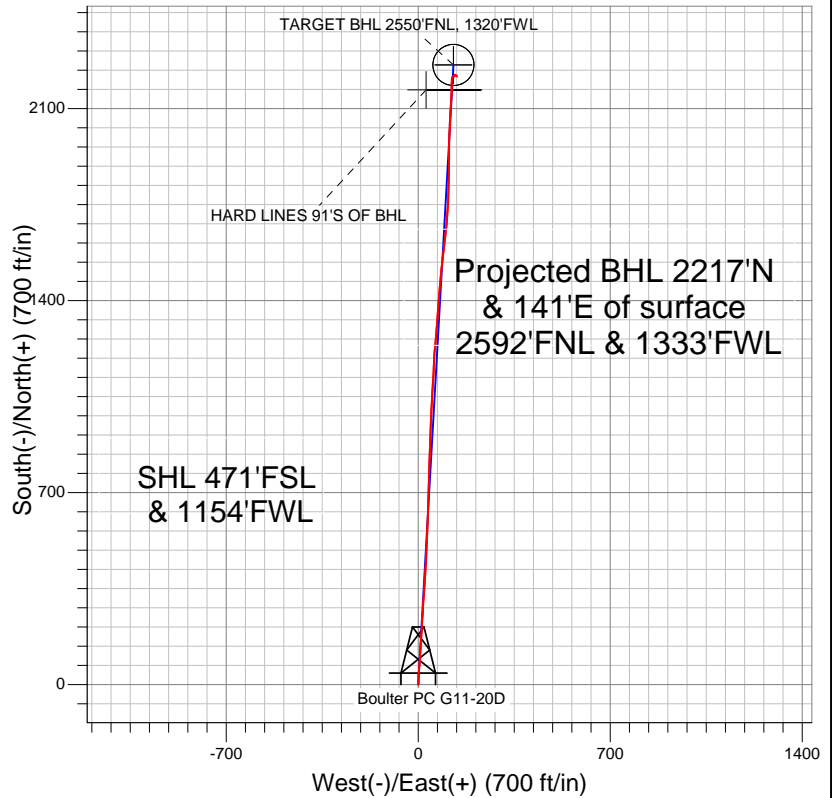


LEGEND

- Survey #1
- + Boulder PC G11-20D, Wellbore #1, Noble Boulder PC G11-20D Plan #1 (1-3-12) R V0
- Wellbore #1

Final Survey Plot

Projected Final Survey -
 7729'MD & 7226'TVD @ 2221'VS
 1.60 deg Inc 134.10 deg AZ

Project: SEC.11-T4N-R65W
 Site: Boulder PC G11-20D Pad Sec.11-T4N-R65W
 Well: Boulder PC G11-20D
 Plan: Wellbore #1

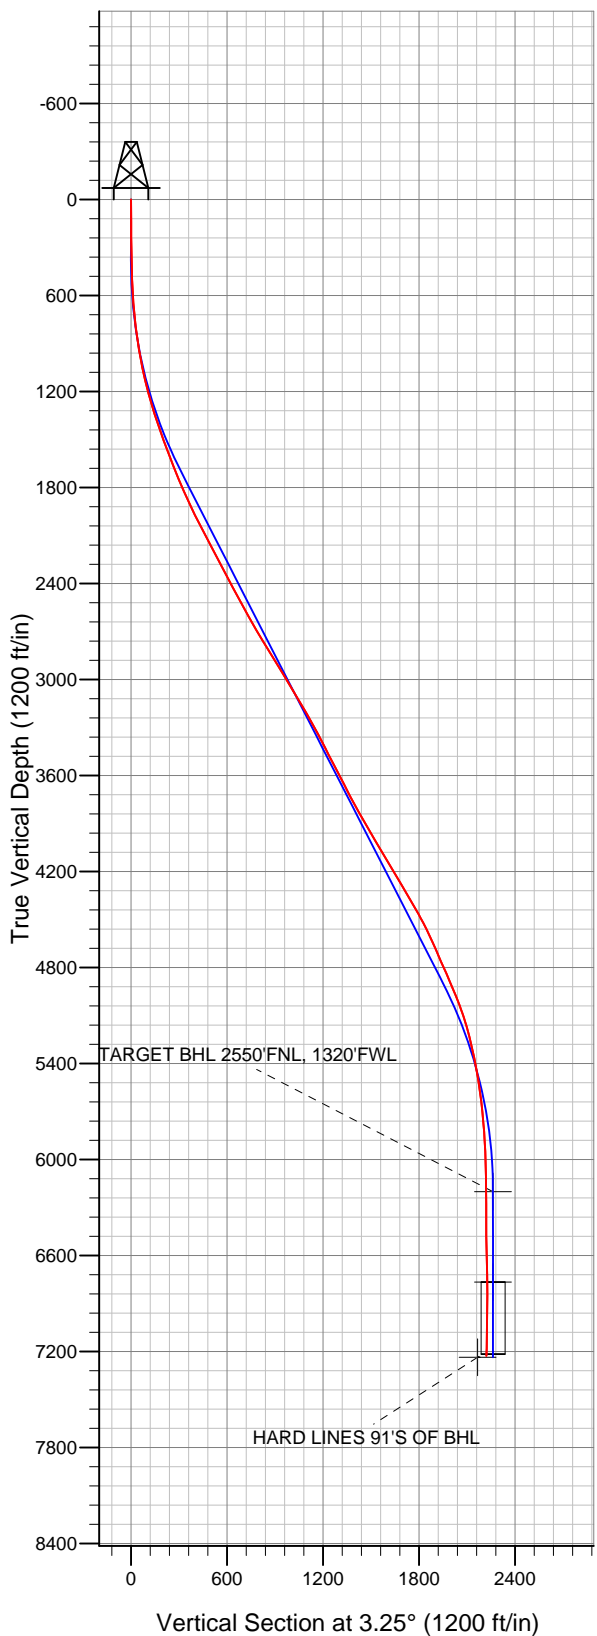



NOBLE ENERGY INC WELD COUNTY CO

SEC.11-T4N-R65W

Boulter PC G11-20D Pad Sec.11-T4N-R65W

Boulter PC G11-20D

Wellbore #1

Survey: Survey #1

Standard Survey Report

09 January, 2012



Company:	NOBLE ENERGY INC WELD COUNTY CO	Local Co-ordinate Reference:	Well Boulter PC G11-20D
Project:	SEC.11-T4N-R65W	TVD Reference:	WELL @ 4696.0ft (Original Well Elev)
Site:	Boulter PC G11-20D Pad Sec.11-T4N-R65W	MD Reference:	WELL @ 4696.0ft (Original Well Elev)
Well:	Boulter PC G11-20D	North Reference:	True
Wellbore:	Wellbore #1	Survey Calculation Method:	Minimum Curvature
Design:	Wellbore #1	Database:	Landmark

Project	SEC.11-T4N-R65W, Weld County, Colorado		
Map System:	US State Plane 1983	System Datum:	Mean Sea Level
Geo Datum:	North American Datum 1983		
Map Zone:	Colorado Northern Zone		Using geodetic scale factor

Site	Boulter PC G11-20D Pad Sec.11-T4N-R65W		
Site Position:		Northing:	1,360,974.49 ft
From:	Lat/Long	Easting:	3,241,057.14 ft
Position Uncertainty:	0.0 ft	Slot Radius:	"
		Latitude:	40.321050
		Longitude:	-104.635470
		Grid Convergence:	0.56 °

Well	Boulter PC G11-20D		
Well Position	+N/-S	0.0 ft	Northing: 1,360,974.47 ft
	+E/-W	0.0 ft	Easting: 3,241,057.14 ft
Position Uncertainty	0.0 ft	Wellhead Elevation:	ft
		Latitude:	40.321050
		Longitude:	-104.635470
		Ground Level:	4,683.0 ft

Wellbore	Wellbore #1				
Magnetics	Model Name	Sample Date	Declination (°)	Dip Angle (°)	Field Strength (nT)
	IGRF200510	1/3/2012	8.67	67.00	53,070

Design	Wellbore #1				
Audit Notes:					
Version:	1.0	Phase:	ACTUAL	Tie On Depth:	0.0
Vertical Section:	Depth From (TVD) (ft)	+N/-S (ft)	+E/-W (ft)	Direction (°)	
	0.0	0.0	0.0	3.25	

Survey Program	Date	1/9/2012			
From (ft)	To (ft)	Survey (Wellbore)	Tool Name	Description	
142.0	7,729.0	Survey #1 (Wellbore #1)	MWD	MWD - Standard	

Survey										
Measured Depth (ft)	Inclination (°)	Azimuth (°)	Vertical Depth (ft)	+N/-S (ft)	+E/-W (ft)	Vertical Section (ft)	Dogleg Rate (°/100ft)	Build Rate (°/100ft)	Turn Rate (°/100ft)	
0.0	0.00	0.00	0.0	0.0	0.0	0.0	0.00	0.00	0.00	
142.0	0.40	36.30	142.0	0.4	0.3	0.4	0.28	0.28	0.00	
237.0	0.60	16.40	237.0	1.1	0.6	1.2	0.28	0.21	-20.95	
332.0	0.80	9.30	332.0	2.3	0.9	2.3	0.23	0.21	-7.47	
427.0	1.40	7.40	427.0	4.1	1.1	4.1	0.63	0.63	-2.00	
522.0	2.40	357.20	521.9	7.2	1.2	7.3	1.11	1.05	-10.74	
617.0	3.80	0.60	616.8	12.4	1.1	12.4	1.49	1.47	3.58	
725.0	5.90	359.70	724.4	21.5	1.1	21.5	1.95	1.94	-0.83	
809.0	6.70	359.70	807.9	30.7	1.1	30.7	0.95	0.95	0.00	
890.0	8.20	4.70	888.2	41.2	1.5	41.2	2.02	1.85	6.17	
972.0	10.20	5.70	969.1	54.2	2.7	54.3	2.45	2.44	1.22	
1,053.0	11.90	5.60	1,048.6	69.7	4.3	69.8	2.10	2.10	-0.12	
1,135.0	13.40	4.50	1,128.6	87.6	5.8	87.8	1.85	1.83	-1.34	

Company:	NOBLE ENERGY INC WELD COUNTY CO	Local Co-ordinate Reference:	Well Boulter PC G11-20D
Project:	SEC.11-T4N-R65W	TVD Reference:	WELL @ 4696.0ft (Original Well Elev)
Site:	Boulter PC G11-20D Pad Sec.11-T4N-R65W	MD Reference:	WELL @ 4696.0ft (Original Well Elev)
Well:	Boulter PC G11-20D	North Reference:	True
Wellbore:	Wellbore #1	Survey Calculation Method:	Minimum Curvature
Design:	Wellbore #1	Database:	Landmark

Survey										
Measured Depth (ft)	Inclination (°)	Azimuth (°)	Vertical Depth (ft)	+N/-S (ft)	+E/-W (ft)	Vertical Section (ft)	Dogleg Rate (°/100ft)	Build Rate (°/100ft)	Turn Rate (°/100ft)	
1,217.0	15.10	3.40	1,208.1	107.7	7.2	107.9	2.10	2.07	-1.34	
1,299.0	16.80	2.10	1,286.9	130.2	8.3	130.5	2.12	2.07	-1.59	
1,380.0	18.20	3.90	1,364.2	154.5	9.6	154.8	1.85	1.73	2.22	
1,462.0	19.30	4.00	1,441.8	180.8	11.4	181.2	1.34	1.34	0.12	
1,544.0	19.70	2.60	1,519.1	208.2	13.0	208.6	0.75	0.49	-1.71	
1,626.0	20.60	3.60	1,596.1	236.4	14.5	236.8	1.18	1.10	1.22	
1,708.0	22.10	3.70	1,672.5	266.2	16.4	266.7	1.83	1.83	0.12	
1,790.0	22.70	2.00	1,748.3	297.4	17.9	297.9	1.08	0.73	-2.07	
1,871.0	23.60	5.70	1,822.8	329.1	20.1	329.7	2.11	1.11	4.57	
1,953.0	25.10	3.60	1,897.5	362.8	22.8	363.5	2.11	1.83	-2.56	
2,035.0	25.60	3.50	1,971.6	397.8	25.0	398.6	0.61	0.61	-0.12	
2,117.0	27.00	2.50	2,045.1	434.1	26.9	435.0	1.79	1.71	-1.22	
2,198.0	28.70	3.70	2,116.7	471.9	28.9	472.8	2.21	2.10	1.48	
2,280.0	28.10	2.80	2,188.9	510.8	31.2	511.8	0.90	-0.73	-1.10	
2,362.0	27.90	1.50	2,261.3	549.3	32.6	550.3	0.78	-0.24	-1.59	
2,444.0	27.40	2.00	2,333.9	587.3	33.8	588.3	0.67	-0.61	0.61	
2,525.0	27.70	2.90	2,405.7	624.8	35.4	625.8	0.63	0.37	1.11	
2,607.0	28.10	1.60	2,478.2	663.1	36.9	664.1	0.89	0.49	-1.59	
2,689.0	27.90	1.30	2,550.6	701.6	37.8	702.6	0.30	-0.24	-0.37	
2,771.0	29.60	1.40	2,622.5	741.0	38.8	742.0	2.07	2.07	0.12	
2,852.0	30.90	2.40	2,692.4	781.8	40.1	782.8	1.72	1.60	1.23	
2,934.0	31.30	1.90	2,762.7	824.1	41.7	825.2	0.58	0.49	-0.61	
3,016.0	32.40	2.10	2,832.3	867.4	43.2	868.4	1.35	1.34	0.24	
3,098.0	30.30	1.20	2,902.3	910.0	44.5	911.1	2.62	-2.56	-1.10	
3,180.0	31.30	2.00	2,972.8	952.0	45.6	953.0	1.32	1.22	0.98	
3,261.0	32.10	1.80	3,041.7	994.5	47.1	995.6	1.00	0.99	-0.25	
3,343.0	31.40	3.00	3,111.4	1,037.6	48.9	1,038.7	1.15	-0.85	1.46	
3,425.0	29.90	4.70	3,181.9	1,079.3	51.6	1,080.5	2.11	-1.83	2.07	
3,507.0	28.10	4.00	3,253.7	1,119.0	54.7	1,120.3	2.23	-2.20	-0.85	
3,589.0	27.60	1.70	3,326.2	1,157.2	56.6	1,158.6	1.45	-0.61	-2.80	
3,670.0	27.60	3.20	3,398.0	1,194.7	58.2	1,196.1	0.86	0.00	1.85	
3,752.0	27.90	5.80	3,470.5	1,232.8	61.2	1,234.3	1.52	0.37	3.17	
3,834.0	27.90	5.00	3,543.0	1,271.0	64.8	1,272.6	0.46	0.00	-0.98	
3,916.0	27.60	5.00	3,615.6	1,309.0	68.1	1,310.8	0.37	-0.37	0.00	
3,997.0	26.50	2.90	3,687.7	1,345.8	70.7	1,347.6	1.80	-1.36	-2.59	
4,079.0	28.70	4.20	3,760.4	1,383.7	73.0	1,385.6	2.78	2.68	1.59	
4,161.0	29.30	5.10	3,832.1	1,423.3	76.3	1,425.3	0.90	0.73	1.10	
4,243.0	29.10	5.70	3,903.7	1,463.1	80.0	1,465.3	0.43	-0.24	0.73	
4,324.0	31.50	5.40	3,973.6	1,503.8	84.0	1,506.1	2.97	2.96	-0.37	
4,406.0	31.50	6.00	4,043.5	1,546.4	88.2	1,548.9	0.38	0.00	0.73	
4,488.0	30.90	7.10	4,113.7	1,588.6	93.1	1,591.3	1.01	-0.73	1.34	
4,570.0	30.00	6.40	4,184.3	1,629.9	98.0	1,632.8	1.18	-1.10	-0.85	
4,651.0	29.50	5.00	4,254.7	1,669.9	102.0	1,673.0	1.06	-0.62	-1.73	
4,733.0	30.60	5.00	4,325.6	1,710.8	105.5	1,714.0	1.34	1.34	0.00	
4,815.0	30.40	3.50	4,396.3	1,752.3	108.6	1,755.6	0.96	-0.24	-1.83	
4,897.0	29.90	1.60	4,467.2	1,793.4	110.5	1,796.8	1.31	-0.61	-2.32	
4,979.0	26.80	1.30	4,539.4	1,832.3	111.5	1,835.7	3.78	-3.78	-0.37	
5,060.0	24.20	359.20	4,612.5	1,867.2	111.6	1,870.5	3.40	-3.21	-2.59	
5,142.0	23.60	0.30	4,687.4	1,900.4	111.5	1,903.7	0.91	-0.73	1.34	
5,224.0	23.90	0.60	4,762.5	1,933.5	111.7	1,936.7	0.39	0.37	0.37	
5,306.0	23.90	1.80	4,837.5	1,966.7	112.4	1,969.9	0.59	0.00	1.46	
5,388.0	23.10	2.00	4,912.7	1,999.3	113.5	2,002.6	0.98	-0.98	0.24	
5,469.0	22.20	2.00	4,987.4	2,030.5	114.6	2,033.7	1.11	-1.11	0.00	
5,551.0	19.90	3.00	5,063.9	2,059.9	115.9	2,063.2	2.84	-2.80	1.22	

Company:	NOBLE ENERGY INC WELD COUNTY CO	Local Co-ordinate Reference:	Well Boulter PC G11-20D
Project:	SEC.11-T4N-R65W	TVD Reference:	WELL @ 4696.0ft (Original Well Elev)
Site:	Boulter PC G11-20D Pad Sec.11-T4N-R65W	MD Reference:	WELL @ 4696.0ft (Original Well Elev)
Well:	Boulter PC G11-20D	North Reference:	True
Wellbore:	Wellbore #1	Survey Calculation Method:	Minimum Curvature
Design:	Wellbore #1	Database:	Landmark

Survey									
Measured Depth (ft)	Inclination (°)	Azimuth (°)	Vertical Depth (ft)	+N/-S (ft)	+E/-W (ft)	Vertical Section (ft)	Dogleg Rate (°/100ft)	Build Rate (°/100ft)	Turn Rate (°/100ft)
5,633.0	16.80	3.20	5,141.8	2,085.7	117.3	2,089.0	3.78	-3.78	0.24
5,714.0	14.70	2.80	5,219.7	2,107.7	118.4	2,111.0	2.60	-2.59	-0.49
5,796.0	12.70	3.40	5,299.4	2,127.1	119.5	2,130.4	2.45	-2.44	0.73
5,878.0	11.50	3.50	5,379.6	2,144.2	120.5	2,147.6	1.46	-1.46	0.12
5,960.0	9.80	3.10	5,460.1	2,159.3	121.4	2,162.8	2.08	-2.07	-0.49
6,042.0	8.20	1.80	5,541.1	2,172.2	121.9	2,175.6	1.97	-1.95	-1.59
6,123.0	7.20	355.20	5,621.4	2,183.0	121.7	2,186.4	1.65	-1.23	-8.15
6,205.0	5.70	4.30	5,702.9	2,192.2	121.6	2,195.5	2.21	-1.83	11.10
6,287.0	4.70	4.20	5,784.5	2,199.6	122.1	2,203.0	1.22	-1.22	-0.12
6,369.0	3.60	6.10	5,866.3	2,205.5	122.6	2,208.9	1.35	-1.34	2.32
6,450.0	2.40	7.90	5,947.2	2,209.7	123.2	2,213.1	1.49	-1.48	2.22
6,532.0	1.70	16.70	6,029.2	2,212.6	123.7	2,216.0	0.93	-0.85	10.73
6,614.0	1.00	24.80	6,111.1	2,214.4	124.4	2,217.9	0.88	-0.85	9.88
6,695.0	0.90	51.40	6,192.1	2,215.4	125.2	2,219.0	0.55	-0.12	32.84
6,703.3	0.90	53.20	6,200.4	2,215.5	125.3	2,219.0	0.35	-0.05	21.81
TARGET BHL 2550'FNL, 1320'FWL									
6,777.0	0.90	69.50	6,274.1	2,216.1	126.3	2,219.6	0.35	0.01	22.10
6,859.0	1.00	73.00	6,356.1	2,216.5	127.6	2,220.2	0.14	0.12	4.27
6,941.0	1.00	102.70	6,438.1	2,216.5	129.0	2,220.3	0.63	0.00	36.22
7,023.0	1.40	58.10	6,520.1	2,216.9	130.5	2,220.7	1.20	0.49	-54.39
7,104.0	1.40	30.50	6,601.0	2,218.3	131.8	2,222.2	0.82	0.00	-34.07
7,186.0	1.50	24.90	6,683.0	2,220.1	132.8	2,224.1	0.21	0.12	-6.83
7,268.0	1.20	25.40	6,765.0	2,221.9	133.6	2,225.9	0.37	-0.37	0.61
7,269.3	1.19	25.88	6,766.3	2,221.9	133.6	2,225.9	1.30	-1.06	36.51
TARGET CIRCLE 2550'FNL & 1320'FWL									
7,349.0	0.70	86.40	6,846.0	2,222.7	134.5	2,226.7	1.30	-0.61	75.95
7,431.0	1.20	136.90	6,928.0	2,222.1	135.6	2,226.2	1.13	0.61	61.59
7,513.0	1.40	128.10	7,010.0	2,220.8	136.9	2,225.0	0.34	0.24	-10.73
7,595.0	1.50	130.90	7,091.9	2,219.5	138.5	2,223.8	0.15	0.12	3.41
7,683.0	1.60	134.10	7,179.9	2,217.9	140.3	2,222.3	0.15	0.11	3.64
7,729.0	1.60	134.10	7,225.9	2,217.0	141.2	2,221.4	0.00	0.00	0.00
HARD LINES 91'S OF BHL									

Checked By: _____ Approved By: _____ Date: _____