



E.L. Minch 24-4
05-123-33658
Sec 4 T3N R68W
Weld County, Colorado
WELLBORE SCHEMATIC
 5/31/2012

Spud Date: 4/3/2012

P xA'd Date 4-30-2012

Surface Casing:

8 5/8" 24# J-55
 Surf to 735', w/520 sx cement
 Circulated 5 bbls of cement to surface

Production Casing:

None Run-Well Dry Hole to be plugged


Tubing: None

Workovers:

Plugged Well 4-30-2012 with
 Western Wellsite Services, LLC
 Harlan Hodge-Supervisor

All Cement Class G Neat, 1.15 yield
 15.7 ppg
 all plugs pumped via 2-3/8" workstring
 Used 235 sxs cement to plug well.

Note: Vertical Well

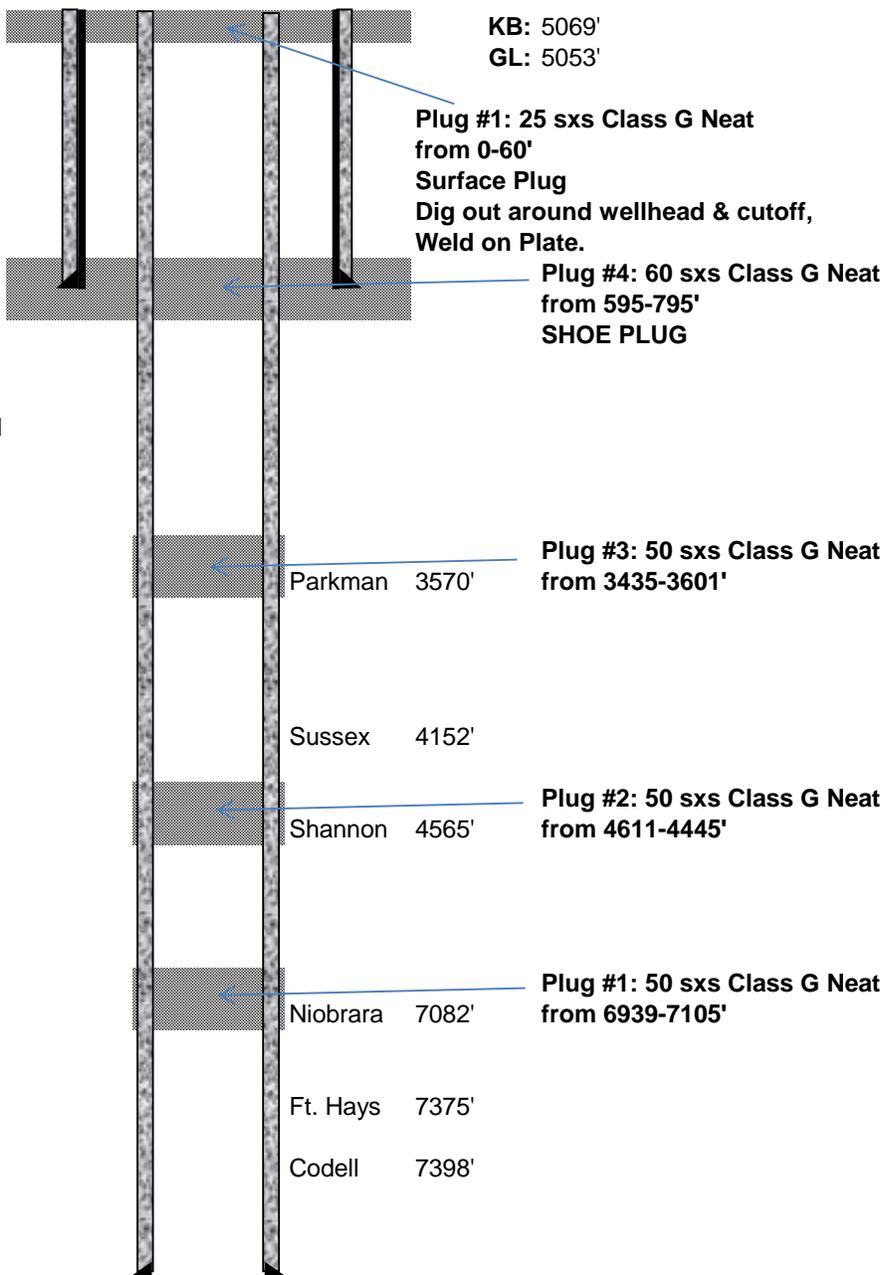

MD: 7548'