

FORM  
**27**  
Rev 6/89

State of Colorado  
Oil and Gas Conservation Commission

1120 Lincoln Street, Suite 801, Denver, Colorado 80203 (303)894-2100 Fax:(303)894-2109



#7065

FOR OGCC USE ONLY

RECEIVED  
6/4/2012

### SITE INVESTIGATION AND REMEDIATION WORKPLAN

This form shall be submitted to the Director for approval prior to the initiation of site investigation and remediation activities. Form 27 is intended to be used whenever possible. Additional documentation will be required when large volumes of soil and groundwater have been impacted or involve large facilities with multiple source areas. See Rule 910. Attach as many pages as needed to fully describe the proposed work.

#### CAUSE OF CONDITION BEING INVESTIGATED AND REMEDIATED

Spill or Release  Plug & Abandon  Central Facility Closure  Site/Facility Closure  Other (describe): Pit Closure

OGCC Operator Number: 100264	Contact Name and Telephone: Jessica Dooling No: 970-675-4122 Fax: 970-675-4150
Name of Operator: XTO Energy Inc.	
Address: PO Box 6501	
City: Englewood	State: CO Zip: 80155
API Number: 05-103-10809-00	County: Rio Blanco
Facility Name: Piceance Creek Unit	Facility Number: Drilling Pit, Facility ID# 284544
Well Name: Piceance Creek Unit	Well Number: 297-15A
Location: (QtrQtr, Sec, Twp, Rng, Meridian): NENW, Sec.15, T2S, R97W, 6thPM	Latitude: 39.880861 Longitude: -108.271292

#### TECHNICAL CONDITIONS

Type of Waste Causing Impact (crude oil, condensate, produced water, etc): Drill Cuttings and Fluids

**Site Conditions:** Is location within a sensitive area (according to Rule 901e)?  Y  N If yes, attach evaluation.

Adjacent land use (cultivated, irrigated, dry land farming, industrial, residential, etc.): non-cropland rangeland

Soil type, if not previously identified on Form 2A or Federal Surface Use Plan: Redcreek-Rentsac complex; 5 - 30% slopes

Potential receptors (water wells within 1/4 mi, surface waters, etc.): no water wells within 1/4 mile,  
nearest surface water is approximately 5,000 feet away.

**Description of Impact** (if previously provided, refer to that form or document):

Impacted Media (check):	Extent of Impact:	How Determined:
<input checked="" type="checkbox"/> Soils	pit contents: TPH, benzene; sub-liner impacts: TPH, arsenic	laboratory analysis
<input type="checkbox"/> Vegetation		
<input type="checkbox"/> Groundwater		
<input type="checkbox"/> Surface Water		

#### REMEDIATION WORKPLAN

**Describe initial action taken** (if previously provided, refer to that form or document):

See Attachment I for details regarding initial action taken.

**Describe how source is to be removed:**

Freshwater contents (de minimis) and Reserve pit contents as well as synthetic liners have been removed and transported to an off-site permitted disposal/recycling facility. Cuttings pits # 1, 2 and 3 synthetic liners have been removed and transported to an off-site permitted disposal/recycling facility. Cuttings pits # 1, 2 and 3 contents were mix/blended to below Table 910-1 concentrations and will be used on-site for fill.

**Describe how remediation of existing impacts is to be accomplished, including removal and disposal at an injection well or licensed facility, land treatment on site, removal of impacted groundwater, insitu bioremediation, burning of oily vegetation, etc.:**

NA

XTO Energy

FORM  
27  
Rev 6/99

Page 2

State of Colorado  
Oil and Gas Conservation Commission  
1120 Lincoln Street, Suite 801, Denver, Colorado 80203  
(303)894-2100 Fax:(303)894-2109



REMEDIATION WORKPLAN (Cont.)

OGCC Employee:

If groundwater has been impacted, describe proposed monitoring plan (# of wells or sample points, sampling schedule, analytical methods, etc.):

Available information indicates that the uppermost groundwater bearing zone is greater than 100 feet below the ground surface. Soil samples were collected for laboratory analysis of sub-liner material to confirm no groundwater impact potential exists (see Tables 1 thru 5).

Describe reclamation plan. Discuss existing and new grade recontouring; method and testing of compaction alleviation; and reseeding program, including location of new seed, seed mix and noxious weed prevention. Attach diagram or drawing. Use additional sheet for description if required.

Please see Attachment II

Attach samples and analytical results taken to verify remediation of impacts. Show locations of samples on an onsite schematic or drawing.

Is further site investigation required?  Y  N If yes, describe:

Based on subliner sample results no additional assessment will be necessary beneath the Freshwater, Reserve, Cuttings #1, Cuttings #2 and Cuttings #3 Pits (see Tables 1 thru 5).

Final disposition of E&P waste (landtreated and disposed onsite, name of licensed disposal facility, recycling, reuse, etc.):

All pit contents and liners from the Freshwater and Reserve Pits were removed and transported to an approved off-site disposal/recycling facility. Cuttings Pit #1, Cuttings #2 and Cuttings #3 synthetic liners were removed and transported to an approved off-site disposal/recycling facility. Cuttings Pit #1, Cuttings #2 and Cuttings #3 material was mix/blended to below Table 910-1 (with the exception of Arsenic) and will be used on-site for fill. Freshwater pit sub-liner impacts were excavated, crushed and mixblend processed to below Table 910-1 concentration levels. This material will also be used on-site for fill.

#### IMPLEMENTATION SCHEDULE

Date Site Investigation Began: 11/4/11	Date Site Investigation Completed: in progress	Date Remediation Plan Submitted: _____
Remediation Start Date: pending approval	Anticipated Completion Date: pending approval	Actual Completion Date: TBD

I hereby certify that the statements made in this form are, to the best of my knowledge, true, correct, and complete.

Print Name: DOLENA JOHNSON

Signed: Dolena Johnson

Title: REGULATORY COMPLIANCE TECHNICIAN

Date: 06/04/2012

OGCC Approved: Chris Canfield

Title: FOR Chris Canfield Date: 06/04/2012

EPS NW Region

## ATTACHMENT I

### **PCU 297-15A Pit Closure Workplan, Form 27 Page 1**

**Describe initial action taken:**

- i. The site consists of a Freshwater Pit, Reserve Pit, Cuttings Pit #1, Cuttings Pit #2 and Cuttings Pit #3 (see Figure 1).
- ii. De minimus Freshwater Pit contents and associated synthetic liners were removed and transported to an off-site permitted disposal/recycling facility.
- iii. Freshwater Pit sub-liner composite samples were collected and analyzed for Table 910-1 parameters. Results indicated that the material was in exceedence of Table 910-1 concentration levels for TPH (1,329 mg/kg), EC (6.55 mmhos/cm), SAR (31.9), pH (9.91), and Arsenic (4.2 mg/kg).
- iv. Reserve Pit contents and associated synthetic liners were removed and transported to an off-site permitted disposal/recycling facility.
- v. Reserve Pit sub-liner composite samples were collected and analyzed for Table 910-1 parameters, results are below Table 910-1 concentrations with the exception of SAR (23.5), pH (9.82) and Arsenic (5.2 mg/kg).
- vi. Cuttings Pit #1 contents were sampled for full Table 910-1 parameters. Results exceeded Table 910-1 concentration levels for TPH (672 mg/kg), EC (5.36 mmhos/cm), SAR (74.2), pH (11.73), and Arsenic (12.2 mg/kg).
- vii. Cuttings Pit #1 contents were subsequently mixblend processed to meet Table 910-1 concentration levels for TPH (see Table 2).
- viii. Cuttings Pit #1 subliner composite samples were collected and analyzed for full Table 910-1 parameters, results are below Table 910-1 concentration levels with the exception of SAR (18.1), pH (10.16) and Arsenic (6.5 mg/kg).
- ix. Cuttings Pit #2 contents were sampled for full Table 910-1 parameters. Results exceeded Table 910-1 concentration levels for TPH (585 mg/kg), Benzene (0.27 mg/kg), EC (6.85 mmhos/cm), SAR (66.2), pH (11.61), and Arsenic (5.4 mg/kg).

- x. Cuttings Pit #2 contents were subsequently mixblend processed to meet Table 910-1 concentration levels for TPH and Benzene (see Table 3).
- xi. Cuttings Pit #2 subliner composite samples were collected and analyzed for full Table 910-1 parameters, results are below Table 910-1 concentration levels with the exception of EC (7.30 mmhos/cm), SAR (28), pH (10.08) and Arsenic (17.1 mg/kg).
- xii. Cuttings Pit #3 contents were sampled for full Table 910-1 parameters. Results exceeded Table 910-1 concentration levels for Benzene (0.346 mg/kg), EC (11.5 mmhos/cm), SAR (385), pH (11.65), and Arsenic (7.2 mg/kg).
- xiii. Cuttings Pit #3 contents were subsequently mixblend processed to meet Table 910-1 concentration levels for Benzene (see Table 3).
- xiv. Cuttings Pit #3 subliner composite samples were collected and analyzed for full Table 910-1 parameters, results are below Table 910-1 concentration levels with the exception of EC (4.62 mmhos/cm), SAR (35.1), pH (10.26) and Arsenic (4.4 mg/kg).
- xv. Cuttings Pits #1, #2 and #3 mixblend material will be used onsite for backfill.
- xvi. Cuttings Pits #1, #2 and #3 synthetic liners were removed and transported to an off-site permitted disposal/recycling facility.
- xvii. Refer to Tables 1 thru 5 for a summary of laboratory results.
- xviii. Elevated arsenic levels above Table 910-1 concentration were detected beneath the Freshwater, Reserve and Cuttings Pits #1, #2 and #3. Please refer to the associated sundry requesting consideration of background Arsenic levels.

## **ATTACHMENT II**

### **PCU 297-15A Pit Closure Workplan, Form 27 Page 2**

#### **REMEDIATION WORKPLAN**

##### **Describe Reclamation Plan:**

###### **1. Fresh Water Pit**

- The Freshwater sub-liner impacted material has been excavated and mix/blend processed to below Table 910 concentration levels. Subsequent sub-liner samples indicate cleanup has been achieved (see Table 4).
- The pit will be backfilled with mix/blended, native on-site material or material transported to the site.

###### **2. Reserve Pit**

- The pit will be backfilled with mix/blended, native on-site material or material transported to the site.

###### **3. Cuttings Pit #1**

- The pit will be backfilled with mix/blended, native on-site material or material transported to the site.

###### **4. Cuttings Pit #2**

- The pit will be backfilled with Mix/blended, native on-site material or material transported to the site.

###### **5. Cuttings Pit #3**

- The pit will be backfilled with Mix/blended, native on-site material or material transported to the site.
- Elevated arsenic levels above the Table 910-1 concentration levels were detected beneath the Freshwater, Reserve, Cuttings Pit #1, Cuttings Pit #2 and Cuttings Pit #3. Please refer to associated sundry requesting consideration of background arsenic levels.
- Please refer to Table 1 thru Table 5 for a summary of laboratory results, analytical reports are attached.

- Any remaining elevated levels of EC, SAR and pH detected beneath the pits or in material used for backfill will be covered with a minimum 3 feet of clean, native soils per COGCC guidance. No additional treatment of these soils will be required.
- Material used to fill the top 3 feet of each pit will be found on-site.
- Reclamation activities will be as specified in the Surface use Plan and BLM Conditions of Approval.

**Table 1**  
**Location: PCU 297-15A**  
**Lab Summary**

Last update 5/24/2012

Analytical Parameter	Fresh Water Pit			Reserve Pit			Cuttings #1		Cuttings #2		Cuttings #3		Background 1/15/10 - 1/18/10						COGCC	Maximum based on Background
(with units)	FW Pit Contents	FW Pit Subliner <sup>6</sup> 1/25/12	RES Pit Contents 11/4/11	RES Pit Subliner <sup>5</sup> 1/11/12	RES Pit Subliner Under Berm 2/16/12	CUT #1 Pit Subliner 11/10/11	CUT #1 Pit Subliner 2/28/12	CUT #2 Pit Subliner 11/10/11	CUT #2 Pit Subliner 2/1/12	CUT #3 Pit Contents <sup>8</sup> 1/11/12	CUT #3 Pit Subliner <sup>5</sup> 3/5/12	Surface B1A (-1')	Deep B1B (-9.5')	Surface B2A (-1')	Deep B2B (-6.5')	Surface B3A (-1')	Deep B3B (-12')	Table 910-1 Concentration Levels		
Accutest Job #	D31355	D29209	D30989	D32020	D29400	D32299	D29407	D31568	D30988	D32442		D10497						-	-	
Sample type (Composite/Discrete)	C	C	C	C	C	C	C	C	C	D	D	D	D	D	D	D	D	-	-	
TPH (GRO) (mg/Kg)	8.79	295	ND	ND	43.7	24.1	53.5	11.1	24.9	ND	-	-	-	-	-	-	-	-	-	
TPH (DRO) (mg/Kg)	1320	2720	300	102	628	247	531	116	464	50.8	-	-	-	-	-	-	-	-	-	
TPH (GRO + DRO) (mg/Kg)	1329	3015	300	102	672	271	585	127	489	50.8	-	-	-	-	-	-	-	500	-	
Benzene (mg/Kg)	ND	0.461	ND	ND	0.12	0.0747	0.27	0.0457	0.346	ND	-	-	-	-	-	-	-	0.170	-	
Toluene (mg/Kg)	ND	3.8	ND	-	0.933	0.170	1.47	0.118	1.35	ND	-	-	-	-	-	-	-	85	-	
Ethylbenzene (mg/Kg)	ND	1.22	ND	-	0.259	ND	0.283	ND	0.202	ND	-	-	-	-	-	-	-	100	-	
Xylenes (total) (mg/Kg)	ND	25.4	ND	-	1.2	0.225	1.76	0.170	1.62	ND	-	-	-	-	-	-	-	175	-	
Acenaphthene (ng/Kg)	ND	ND	ND	-	ND	ND	ND	ND	ND	ND	-	-	-	-	-	-	-	1000	-	
Anthracene (mg/Kg)	ND	ND	ND	-	ND	ND	ND	ND	ND	ND	-	-	-	-	-	-	-	1000	-	
Benz(a)anthracene (mg/Kg)	ND	ND	ND	-	ND	ND	ND	ND	ND	ND	-	-	-	-	-	-	-	0.22	-	
Benz(a)pyrene (mg/Kg)	ND	ND	ND	-	ND	ND	ND	ND	ND	ND	-	-	-	-	-	-	-	0.22	-	
Benz(b)fluoranthene (mg/Kg)	ND	ND	ND	-	ND	ND	ND	ND	ND	ND	-	-	-	-	-	-	-	2.2	-	
Benz(k)fluoranthene (mg/Kg)	ND	ND	ND	-	ND	ND	ND	ND	ND	ND	-	-	-	-	-	-	-	0.022	-	
Chrysene (mg/Kg)	ND	ND	ND	-	ND	ND	ND	0.0130	0.0428	ND	-	-	-	-	-	-	-	22	-	
Dibenzo(A,H)anthracene (mg/Kg)	ND	ND	ND	-	ND	ND	ND	ND	ND	ND	-	-	-	-	-	-	-	0.022	-	
Fluoranthene (mg/Kg)	ND	ND	ND	-	ND	ND	ND	ND	ND	ND	-	-	-	-	-	-	-	1000	-	
Fluorene (mg/Kg)	ND	0.0744	-	ND	ND	ND	0.0212	0.0813	ND	-	-	-	-	-	-	-	-	1000	-	
Indeno(1,2,3,C,D)pyrene (mg/Kg)	ND	ND	ND	-	ND	ND	ND	ND	ND	-	-	-	-	-	-	-	-	0.22	-	
Naphthalene (mg/Kg)	ND	0.554	ND	-	0.462	0.0903	0.407	0.0926	0.334	0.0195	-	-	-	-	-	-	-	23	-	
Pyrene (mg/Kg)	ND	ND	ND	-	ND	ND	ND	0.0082	ND	ND	-	-	-	-	-	-	-	1000	-	
Electrical Conductivity (mmhos/cm)	6.55	0.739	2.41	-	5.36	3.120	6.85	7.300	11.5	4.620	-	-	-	-	-	-	-	4	-	
Sodium Adsorption Ratio (SAR)	31.9	8.57	23.5	-	74.2	18.1	66.2	28.0	385	35.1	-	-	-	-	-	-	-	12	-	
pH	9.91	10.48	9.82	-	11.73	10.16	11.61	10.08	11.65	10.26	-	-	-	-	-	-	-	6.9	-	
Arsenic (mg/kg)	4.2	5.7	5.2	-	12.2	6.5	5.4	17.1	7.2	4.4	7.1	12.2	5.9	8.7	5.9	6.4	0.39	13.4		
Elevation in Feet (approximate)	6607	-	6606	-	6605	-	6604	-	6605	6602	6592.5	6598	6591.5	6630	6618	-	-	-	-	
Barium (mg/kg)	1180	19200	896	-	4250	3170	10.7	3050	7460	2130	-	-	-	-	-	-	-	15000	-	
Cadmium (mg/kg)	<1.1	<2.5	<1.1	-	<1.5	<1.2	<1.5	<1.0	<1.3	<1.2	-	-	-	-	-	-	-	70	-	
Chromium (III) (mg/Kg)	52.6	17.8	34.9	-	15.5	31.6	11.8	34.1	11.6	32.5	-	-	-	-	-	-	-	120000	-	
Chromium (VI) (mg/Kg)	0.75	1.9	<0.44	-	<0.59	<1.0	<0.56	<0.45	<0.54	1.0	-	-	-	-	-	-	-	23	-	
Copper (mg/kg)	11.7	54.2	12.8	-	31.2	15.9	37.6	20.0	36.3	11.7	-	-	-	-	-	-	-	3100	-	
Lead (inorganic) (mg/kg)	10.8	19.5	11.9	-	23.5	17.5	16.7	27.4	20.3	15.8	-	-	-	-	-	-	-	400	-	
Mercury (mg/kg)	<0.11	<0.25	<0.11	-	<0.14	<0.13	<0.15	<0.11	<0.13	<0.12	-	-	-	-	-	-	-	23	-	
Nickel (mg/kg)	21.9	13.6	15.1	-	15.4	16.2	12	17.6	11.7	14.4	-	-	-	-	-	-	-	1600	-	
Selenium (mg/kg)	<5.7	<130	<5.6	-	<7.3	<6.0	<74	<5.2	<6.5	<6.2	-	-	-	-	-	-	-	390	-	
Silver (mg/kg)	<3.4	<7.6	<3.3	-	<4.4	<3.6	<4.4	<3.1	<3.9	<3.7	-	-	-	-	-	-	-	390	-	
Zinc (mg/kg)	38.2	59.1	41.2	-	59	46.7	57.4	72.6	49.9	43.4	-	-	-	-	-	-	-	23000	-	
% Solids	-	88.3	37.0	89.9	87.3	66.5	79.4	69.4	89.6	74.2	82.9	91.3	92.4	88.0	88.4	89.6	86.8	-	-	

## Notes:

1) ND = not detectable to the laboratory detection limit.

2) Results highlighted in yellow exceed Table 910-1 concentration levels. Results highlighted in Gray exceed Table 910-1, but are below background levels.

3) "—" indicates no analysis.

4) See site map for sample locations.

5) Elevation data obtained by interpolating between adjacent pits.

6) See Table 4 and Table 5 for assessment and confirmation information.

7) See Table 2 for mixblend details.

8) See Table 3 for mixblend details.

**Table 2**  
**Location: PCU 297-15A**  
**Lab Summary - Cuttings #1 Mix/Blend**

Analytical Parameter	Cuttings #1																			Last update	5/24/2012		
	CUT #1 Pit Contents (11/10/11)	Mixblend Day 1 (1/19) (1/19/12)	Mixblend Day 2 (2/1) (2/2/12)	Mixblend Day 3 (2/2) (2/2/12)	Mixblend Day 4 (2/3) (2/6/12)	Mixblend Day 5 (2/6) (2/10/12)	Mixblend Day 6 (2/7) (2/10/12)	Mixblend Day 7 (2/8) (2/10/12)	Mixblend Day 8 (2/9) (2/10/12)	Mixblend Day 9 (2/10) (2/14/12)	Mixblend Day 10 (2/14) (2/16/12)	Mixblend Day 11 (2/14) (2/16/12)	Mixblend Day 12 (2/16) (2/21/12)	Mixblend Day 13 (2/17) (2/21/12)	Mixblend Day 14 (2/20) (2/21/12)	Mixblend Day 15 (2/21) (2/23/12)	Mixblend Day 16 (2/22) (2/23/12)	Mixblend Day 17 (2/23) (2/23/12)	Mixblend Day 18 (2/24) (2/27/12)	Mixblend Day 19 (2/27) (2/29/12)	COGCC		
Accutest Job #	D29400	D31207	D31353	D31610	D31663	D31807	D31901	D32019	D32157	D32209	D32262	D32370	-	-	-	-	-	-	-	-			
Sample type (Composite/Discrete)	C	C	C	C	C	C	C	C	C	C	C	C	C	C	C	C	C	C	C	-			
TPH (GRO) (mg/Kg)	43.7	23.5	8.29	10.7	12.9	6.66	9.63	14.2	19.4	18.4	8.57	8.31	37.9	47.0	17.3	28.0	19.8	12.2	15.1	7.3	8.71	12.1	
TPH (DRO) (mg/Kg)	628	529	307	162	242	199	210	342	374	341	183	177	297	272	317	278	331	341	326	245	221	274	
TPH (GRO + DRO) (mg/Kg)	672	553	315	173	255	206	220	356	393	359	192	185	335	319	334	306	351	353	341	252	230	286	500
Benzene (mg/Kg)	0.12	0.238	ND	-	-	-	-	-	-	-	-	-	-	-	-	-	-	-	-	-	-	0.170	
Toluene (mg/Kg)	0.933	0.661	0.11	-	-	-	-	-	-	-	-	-	-	-	-	-	-	-	-	-	-	85	
Ethylbenzene (mg/Kg)	0.259	0.132	0.035	-	-	-	-	-	-	-	-	-	-	-	-	-	-	-	-	-	-	100	
Xylenes (total) (mg/Kg)	1.2	0.741	0.189	-	-	-	-	-	-	-	-	-	-	-	-	-	-	-	-	-	-	175	
Acenaphthene (mg/Kg)	ND	-	-	-	-	-	-	-	-	-	-	-	-	-	-	-	-	-	-	-	-	1000	
Anthracene (mg/Kg)	ND	-	-	-	-	-	-	-	-	-	-	-	-	-	-	-	-	-	-	-	-	1000	
Benzo(A)anthracene (mg/Kg)	ND	-	-	-	-	-	-	-	-	-	-	-	-	-	-	-	-	-	-	-	-	0.22	
Benzo(A)pyrene (mg/Kg)	ND	-	-	-	-	-	-	-	-	-	-	-	-	-	-	-	-	-	-	-	-	0.22	
Benzo(B)fluoranthene (mg/Kg)	ND	-	-	-	-	-	-	-	-	-	-	-	-	-	-	-	-	-	-	-	-	2.2	
Benzo(K)fluoranthene (mg/Kg)	ND	-	-	-	-	-	-	-	-	-	-	-	-	-	-	-	-	-	-	-	-	0.022	
Chrysene (mg/Kg)	ND	-	-	-	-	-	-	-	-	-	-	-	-	-	-	-	-	-	-	-	-	22	
Dibenzo(A,H)anthracene (mg/Kg)	ND	-	-	-	-	-	-	-	-	-	-	-	-	-	-	-	-	-	-	-	-	0.022	
Fluoranthene (mg/Kg)	ND	-	-	-	-	-	-	-	-	-	-	-	-	-	-	-	-	-	-	-	-	1000	
Fluorene (mg/Kg)	ND	-	-	-	-	-	-	-	-	-	-	-	-	-	-	-	-	-	-	-	-	1000	
Indeno(1,2,3,C,D)pyrene (mg/Kg)	ND	-	-	-	-	-	-	-	-	-	-	-	-	-	-	-	-	-	-	-	-	0.22	
Naphthalene (mg/Kg)	0.462	-	-	-	-	-	-	-	-	-	-	-	-	-	-	-	-	-	-	-	-	23	
Pyrene (mg/Kg)	ND	-	-	-	-	-	-	-	-	-	-	-	-	-	-	-	-	-	-	-	-	1000	
Electrical Conductivity (mmhos/cm)	5.36	-	-	-	-	-	-	-	-	-	-	-	-	-	-	-	-	-	-	-	-	4	
Sodium Adsorption Ratio (SAR)	74.2	-	-	-	-	-	-	-	-	-	-	-	-	-	-	-	-	-	-	-	-	12	
pH	11.73	-	-	-	-	-	-	-	-	-	-	-	-	-	-	-	-	-	-	-	-	6.9	
Arsenic (mg/kg)	12.2	-	-	-	-	-	-	-	-	-	-	-	-	-	-	-	-	-	-	-	-	0.39	
Barium (mg/kg)	4250	-	-	-	-	-	-	-	-	-	-	-	-	-	-	-	-	-	-	-	-	15000	
Cadmium (mg/kg)	<1.5	-	-	-	-	-	-	-	-	-	-	-	-	-	-	-	-	-	-	-	-	70	
Chromium (III) (mg/Kg)	15.5	-	-	-	-	-	-	-	-	-	-	-	-	-	-	-	-	-	-	-	-	120000	
Chromium (VI) (mg/Kg)	<0.59	-	-	-	-	-	-	-	-	-	-	-	-	-	-	-	-	-	-	-	-	23	
Copper (mg/kg)	31.2	-	-	-	-	-	-	-	-	-	-	-	-	-	-	-	-	-	-	-	-	3100	
Lead (inorganic) (mg/kg)	23.5	-	-	-	-	-	-	-	-	-	-	-	-	-	-	-	-	-	-	-	-	400	
Mercury (mg/kg)	<0.14	-	-	-	-	-	-	-	-	-	-	-	-	-	-	-	-	-	-	-	-	23	
Nickel (mg/kg)	15.4	-	-	-	-	-	-	-	-	-	-	-	-	-	-	-	-	-	-	-	-	1600	
Selenium (mg/kg)	<7.3	-	-	-	-	-	-	-	-	-	-	-	-	-	-	-	-	-	-	-	-	390	
Silver (mg/kg)	<4.4	-	-	-	-	-	-	-	-	-	-	-	-	-	-	-	-	-	-	-	-	390	
Zinc (mg/kg)	59	-	-	-	-	-	-	-	-	-	-	-	-	-	-	-	-	-	-	-	-	23000	
% Solids	66.5	82.2	84.2	83.2	79.9	86.2	83.0	81.5	79.6	80.3	82.9	84.2	80.9	79.7	79.2	74.5	80.5	78.0	78.0	87.5	86.4	80.7	

Notes:

1) ND = not detectable to the laboratory detection limit.  
 2) Results highlighted in yellow exceed Table 910-1 concentration levels. Results highlighted in Gray exceed Table 910-1, but are below background levels.

3) "-" indicates no analysis.

4) See site map for sample locations.

**Table 3**  
**Location: PCU 297-15A**

Analytical Parameter		Cuttings #2												Cuttings #3												Last update	
(with units)		CUT #2 Pit Contents 11/10/11	MixBlend Day 1 (1/19)	Day 1 (1/19) Resample (2/1/12)	MixBlend Day 2 (1/20)	Day 2 (1/20) Resample (2/1/12)	MixBlend Day 3 (1/23)	MixBlend Day 4 (1/24)	MixBlend Day 5 (1/25)	MixBlend Day 6 (1/26)	MixBlend Day 6 (1/26/12)	CUT #3 Pit Contents 1/11/12	MixBlend Day 1 (1/27/12)	Day 1 Resample (3/5/12)	MixBlend Day 2 (1/30/12)	MixBlend Day 2 Resample (3/5/12)	MixBlend Day 3 (2/27)	MixBlend Day 4 (2/28)	MixBlend Day 4 Remix (3/13/12)	MixBlend Day 4 Remix (3/28/12)	MixBlend Day 5 (2/29)	MixBlend Day 5 (3/1)	MixBlend Day 6 (3/5/12)	MixBlend Day 7 (3/2)	MixBlend Day 8 (3/5)	MixBlend Day 8 (3/5/12)	Table 910-1 Concentration Levels
Accutest Job #	D29407	D31207	D31567	D31353	D31567	D31353	D31414	D31610	D31414	D30988	D31466	D32507	D31466	D32507	D32370	D32704	D32704	D33249	D32507								-
Sample type (Composite/Discrete)	C	C	C	C	C	C	C	C	C	C	C	C	C	C	C	C	C	C	C	C	C	C	C	C	C	-	
TPH (GRO) (mg/Kg)	53.5	29.4	-	10.7	-	10.3	8.3	27.1	-	22.7	24.9	-	-	-	-	-	-	-	-	-	-	-	-	-	-	-	
TPH (DRO) (mg/Kg)	531	272	-	421	-	125	118	239	-	468	464	-	-	-	-	-	-	-	-	-	-	-	-	-	-	-	
TPH (GRO + DRO) (mg/Kg)	585	301	-	432	-	135	126	266	-	491	489	-	-	-	-	-	-	-	-	-	-	-	-	-	-	500	
Benzene (mg/Kg)	0.27	0.511	0.0534	0.184	0.0473	0.141	0.0985	0.189	0.0568	0.0919	0.346	0.171	0.0621	0.272	0.0799	0.212	0.163	0.241	0.173	ND	0.0623	0.0543	0.0376	0.131	0.170		
Toluene (mg/Kg)	1.47	1.35	-	0.511	-	0.412	0.283	0.557	0.176	0.3	1.35	0.637	-	0.957	-	-	-	-	-	-	-	-	-	-	-	85	
Ethylbenzene (mg/Kg)	0.283	0.153	-	0.0615	-	0.0544	ND	0.0681	ND	0.0432	0.202	0.115	-	0.188	-	-	-	-	-	-	-	-	-	-	-	100	
Xylenes (total) (mg/Kg)	1.76	1.28	-	0.567	-	0.493	0.331	0.646	0.211	0.373	1.62	0.68	-	1.09	-	-	-	-	-	-	-	-	-	-	-	175	
Acenaphthene (mg/Kg)	ND	-	-	-	-	-	-	-	-	-	ND	-	-	-	-	-	-	-	-	-	-	-	-	-	-	1000	
Anthracene (mg/Kg)	ND	-	-	-	-	-	-	-	-	-	ND	-	-	-	-	-	-	-	-	-	-	-	-	-	-	1000	
Benzo(A)anthracene (mg/Kg)	ND	-	-	-	-	-	-	-	-	-	ND	-	-	-	-	-	-	-	-	-	-	-	-	-	-	0.22	
Benzo(A)pyrene (mg/Kg)	ND	-	-	-	-	-	-	-	-	-	ND	-	-	-	-	-	-	-	-	-	-	-	-	-	-	0.22	
Benzo(B)fluoranthene (mg/Kg)	ND	-	-	-	-	-	-	-	-	-	ND	-	-	-	-	-	-	-	-	-	-	-	-	-	-	2.2	
Benzo(K)fluoranthene (mg/Kg)	ND	-	-	-	-	-	-	-	-	-	ND	-	-	-	-	-	-	-	-	-	-	-	-	-	-	0.022	
Chrysene (mg/Kg)	ND	-	-	-	-	-	-	-	-	-	0.0428	-	-	-	-	-	-	-	-	-	-	-	-	-	-	22	
Dibenzo(A,H)anthracene (mg/Kg)	ND	-	-	-	-	-	-	-	-	-	ND	-	-	-	-	-	-	-	-	-	-	-	-	-	-	0.022	
Fluoranthene (mg/Kg)	ND	-	-	-	-	-	-	-	-	-	ND	-	-	-	-	-	-	-	-	-	-	-	-	-	-	1000	
Fluorene (mg/Kg)	ND	-	-	-	-	-	-	-	-	-	0.0813	-	-	-	-	-	-	-	-	-	-	-	-	-	-	1000	
Indeno(1,2,3,C,D)pyrene (mg/Kg)	ND	-	-	-	-	-	-	-	-	-	ND	-	-	-	-	-	-	-	-	-	-	-	-	-	-	0.22	
Naphthalene (mg/Kg)	0.407	-	-	-	-	-	-	-	-	-	0.334	-	-	-	-	-	-	-	-	-	-	-	-	-	-	23	
Pyrene (mg/Kg)	ND	-	-	-	-	-	-	-	-	-	ND	-	-	-	-	-	-	-	-	-	-	-	-	-	-	1000	
Electrical Conductivity (mmhos/cm)	6.85	-	-	-	-	-	-	-	-	-	11.5	-	-	-	-	-	-	-	-	-	-	-	-	-	-	4	
Sodium Adsorption Ratio (SAR)	66.2	-	-	-	-	-	-	-	-	-	385	-	-	-	-	-	-	-	-	-	-	-	-	-	-	12	
pH	11.61	-	-	-	-	-	-	-	-	-	11.65	-	-	-	-	-	-	-	-	-	-	-	-	-	-	6-9	
Arsenic (mg/kg)	5.4	-	-	-	-	-	-	-	-	-	7.2	-	-	-	-	-	-	-	-	-	-	-	-	-	-	0.39	
Barium (mg/kg)	10.7	-	-	-	-	-	-	-	-	-	7460	-	-	-	-	-	-	-	-	-	-	-	-	-	-	15000	
Cadmium (mg/kg)	<1.5	-	-	-	-	-	-	-	-	-	<1.3	-	-	-	-	-	-	-	-	-	-	-	-	-	-	70	
Chromium (III) (mg/Kg)	11.8	-	-	-	-	-	-	-	-	-	11.6	-	-	-	-	-	-	-	-	-	-	-	-	-	-	120000	
Chromium (VI) (mg/Kg)	<0.56	-	-	-	-	-	-	-	-	-	<0.54	-	-	-	-	-	-	-	-	-	-	-	-	-	-	23	
Copper (mg/kg)	37.6	-	-	-	-	-	-	-	-	-	36.3	-	-	-	-	-	-	-	-	-	-	-	-	-	-	3100	
Lead (inorganic) (mg/kg)	16.7	-	-	-	-	-	-	-	-	-	20.3	-	-	-	-	-	-	-	-	-	-	-	-	-	-	400	
Mercury (mg/kg)	<0.15	-	-	-	-	-	-	-	-	-	<0.13	-	-	-	-	-	-	-	-	-	-	-	-	-	-	23	
Nickel (mg/kg)	12	-	-	-	-	-	-	-	-	-	11.7	-	-	-	-	-	-	-	-	-	-	-	-	-	-	1600	
Selenium (mg/kg)	<74	-	-	-	-	-	-	-	-	-	<6.5	-	-	-	-	-	-	-	-	-	-	-	-	-	-	390	
Silver (mg/kg)	<4.4	-	-	-	-	-	-	-	-	-	<3.9	-	-	-	-	-	-	-	-	-	-	-	-	-	-	390	
Zinc (mg/kg)	57.4	-	-	-	-	-	-	-	-	-	49.9	-	-	-	-	-	-	-	-	-	-	-	-	-	-	23000	
% Solids	69.4	78.1	82.0	81.2	82.0	80.8	83.4	80.5	82.0	79.9	74.2	86.2	83.5	83.9	81.5	82.1	83.2	78.3	82.1	86.5	79.4	80.6	82.1	81.9	-		

## Notes

- 1) ND = not detectable to the laboratory detection limit.
  - 2) Results highlighted in yellow exceed Table 910-1 concentration levels. Results highlighted in Gray exceed Table 910-1, but are below background levels.
  - 3) "-" indicates no analysis.
  - 4) See site map for sample locations.

**Table 4**  
**Location: PCU 297-15A**  
**Lab Summary - Freshwater Pit Subliner Assessment**

Analytical Parameter (with units)	FW Subliner			Test Pit 1			Test Pit 2			Test Pit 3			Test Pit 4			Test Pit 5			Last update	5/24/2012
	FW Pit Subliner 1/25/12	FW Pit Subliner (-1') 2/2/12	FW Pit Subliner (-4') 2/2/12	FW TP-1 (0') - (-2') 2/16/12	FW TP-1 (-2') - (- 4') 2/16/12	FW TP-1 (-4') - (- 6') 2/21/12	FW TP-2 (0') - (-2') 2/17/12	FW TP-2 (-2') - (- 4') 2/17/12	FW TP-2 (-4') - (- 6') 2/17/12	FW TP-3 (0') - (-2') 2/17/12	FW TP-3 (-2') - (- 4') 2/17/12	FW TP-3 (-4') - (- 6') 2/17/12	FW TP-4 (0') - (-2') 2/21/12	FW TP-4 (-4') - (- 6') 2/21/12	FW TP-4 (- 8') - (-10') 2/21/12	FW TP-5 (0') - (-2') 2/16/12	FW TP-5 (-4') - (- 6') 2/16/12	FW TP-5 (-8') - (-10') 2/21/12	Table 910-1 Concentration Levels	
Accutest Job #	D31355	D31612	D31613	D32070	D32157	D32070	D32070	D32070	D32070	D32157	D32157	D32157	D32157	D32157	D32157	D32157	-			
Sample type (Composite/Discrete)	C	C	C	C	C	C	C	C	C	C	C	C	C	C	C	C	C			
TPH (GRO) (mg/Kg)	8.79	ND	11	ND	ND	ND	ND	ND	ND	ND	ND	ND	ND	ND	ND	ND	ND			
TPH (DRO) (mg/Kg)	1320	515	815	10.8	93.3	24.0	215	35.5	31.9	681	99.7	299	213	492	628	145	691	84.9		
TPH (GRO + DRO) (mg/Kg)	1329	515	826	10.8	93.3	24.0	215	35.5	31.9	689	99.7	299	213	492	628	145	698	84.9		
Benzene (mg/Kg)	ND	-	-	-	-	-	-	-	-	-	-	-	-	-	-	-	-	0.170		
Toluene (mg/Kg)	ND	-	-	-	-	-	-	-	-	-	-	-	-	-	-	-	-	85		
Ethylbenzene (mg/Kg)	ND	-	-	-	-	-	-	-	-	-	-	-	-	-	-	-	-	100		
Xylenes (total) (mg/Kg)	ND	-	-	-	-	-	-	-	-	-	-	-	-	-	-	-	-	175		
Acenaphthene (mg/Kg)	ND	-	-	-	-	-	-	-	-	-	-	-	-	-	-	-	-	1000		
Anthracene (mg/Kg)	ND	-	-	-	-	-	-	-	-	-	-	-	-	-	-	-	-	1000		
Benzo(A)anthracene (mg/Kg)	ND	-	-	-	-	-	-	-	-	-	-	-	-	-	-	-	-	0.22		
Benzo(A)pyrene (mg/Kg)	ND	-	-	-	-	-	-	-	-	-	-	-	-	-	-	-	-	0.22		
Benzo(B)fluoranthene (mg/Kg)	ND	-	-	-	-	-	-	-	-	-	-	-	-	-	-	-	-	2.2		
Benzo(K)fluoranthene (mg/Kg)	ND	-	-	-	-	-	-	-	-	-	-	-	-	-	-	-	-	0.022		
Chrysene (mg/Kg)	ND	-	-	-	-	-	-	-	-	-	-	-	-	-	-	-	-	22		
Dibenzo(A,H)anthracene (mg/Kg)	ND	-	-	-	-	-	-	-	-	-	-	-	-	-	-	-	-	0.022		
Fluoranthene (mg/Kg)	ND	-	-	-	-	-	-	-	-	-	-	-	-	-	-	-	-	1000		
Fluorene (mg/Kg)	ND	-	-	-	-	-	-	-	-	-	-	-	-	-	-	-	-	1000		
Indeno(1,2,3,C,D)pyrene (mg/Kg)	ND	-	-	-	-	-	-	-	-	-	-	-	-	-	-	-	-	0.22		
Naphthalene (mg/Kg)	ND	-	-	-	-	-	-	-	-	-	-	-	-	-	-	-	-	23		
Pyrene (mg/Kg)	ND	-	-	-	-	-	-	-	-	-	-	-	-	-	-	-	-	1000		
Electrical Conductivity (mmhos/cm)	6.55	-	-	-	-	-	-	-	-	-	-	-	-	-	-	-	-	4		
Sodium Adsorption Ratio (SAR)	31.9	-	-	-	-	-	-	-	-	-	-	-	-	-	-	-	-	12		
pH	9.91	-	-	-	-	-	-	-	-	-	-	-	-	-	-	-	-	6-9		
Arsenic (mg/kg)	4.2	-	-	-	-	-	-	-	-	-	-	-	-	-	-	-	-	0.39		
Barium (mg/kg)	1180	-	-	-	-	-	-	-	-	-	-	-	-	-	-	-	-	15000		
Cadmium (mg/kg)	<1.1	-	-	-	-	-	-	-	-	-	-	-	-	-	-	-	-	70		
Chromium (III) (mg/Kg)	52.6	-	-	-	-	-	-	-	-	-	-	-	-	-	-	-	-	120000		
Chromium (VI) (mg/Kg)	0.75	-	-	-	-	-	-	-	-	-	-	-	-	-	-	-	-	23		
Copper (mg/kg)	11.7	-	-	-	-	-	-	-	-	-	-	-	-	-	-	-	-	3100		
Lead (inorganic) (mg/kg)	10.8	-	-	-	-	-	-	-	-	-	-	-	-	-	-	-	-	400		
Mercury (mg/kg)	<0.11	-	-	-	-	-	-	-	-	-	-	-	-	-	-	-	-	23		
Nickel (mg/kg)	21.9	-	-	-	-	-	-	-	-	-	-	-	-	-	-	-	-	1600		
Selenium (mg/kg)	<5.7	-	-	-	-	-	-	-	-	-	-	-	-	-	-	-	-	390		
Silver (mg/kg)	<3.4	-	-	-	-	-	-	-	-	-	-	-	-	-	-	-	-	390		
Zinc (mg/kg)	38.2	-	-	-	-	-	-	-	-	-	-	-	-	-	-	-	-	23000		
% Solids	88.3	85.4	84.4	86.8	85.6	85.7	86.8	86.8	85.0	87.2	87.9	84.6	86.0	84.7	83.4	84.7	83.1	85.5		

Notes:

- 1) ND = not detectable to the laboratory detection limit.
- 2) Results highlighted in yellow exceed Table 910-1 concentration levels. Results highlighted in Gray exceed Table 910-1, but are below background levels.
- 3) " " indicates no analysis.
- 4) See site map for sample locations.

**Table 5**  
**Location: PCU 297-15A**  
**Lab Summary - Freshwater Excavation Confirmation**

Last update 5/24/2012

Analytical Parameter	Initial	FW Subliner Post Excavation								FW Excavated Material				COGCC
(with units)	FW Pit Subliner 1/25/12	FW -2' Excavation Bottom 3/29/12	FW -8' Excavation Bottom 3/29/12	FW -11' Excavation Bottom 3/29/12	FW SW Excavation Sidewall 3/29/12	FW NW Excavation Sidewall 3/29/12	FW NE Excavation Sidewall 3/29/12	FW SE Excavation Sidewall 3/29/12	FW Excavation Crushed NW 4/24/12	FW Excavation Crushed NE 4/24/12	FW Excavation Crushed SE 4/24/12	FW Excavation Crushed SW 4/24/12	Table 910-1 Concentration Levels	
Accutest Job #	D31355	D33283								D33964				-
Sample type (Composite/Discrete)	C	C	C	C	C	C	C	C	C	C	C	C	C	-
TPH (GRO) (mg/Kg)	8.79	ND	ND	ND	ND	ND	ND	ND	ND	ND	ND	ND	ND	-
TPH (DRO) (mg/Kg)	1320	ND	12.0	192	131	93.5	ND	30.2	308	255	198	148	-	-
TPH (GRO + DRO) (mg/Kg)	1329	ND	12.0	192	131	93.5	ND	30.2	308	255	198	148	500	-
Benzene (mg/Kg)	ND	-	-	-	-	-	-	-	-	-	-	-	0.170	-
Toluene (mg/Kg)	ND	-	-	-	-	-	-	-	-	-	-	-	85	-
Ethylbenzene (mg/Kg)	ND	-	-	-	-	-	-	-	-	-	-	-	100	-
Xylenes (total) (mg/Kg)	ND	-	-	-	-	-	-	-	-	-	-	-	175	-
Acenaphthene (mg/Kg)	ND	-	-	-	-	-	-	-	-	-	-	-	1000	-
Anthracene (mg/Kg)	ND	-	-	-	-	-	-	-	-	-	-	-	1000	-
Benzo(A)anthracene (mg/Kg)	ND	-	-	-	-	-	-	-	-	-	-	-	0.22	-
Benzo(A)pyrene (mg/Kg)	ND	-	-	-	-	-	-	-	-	-	-	-	0.22	-
Benzo(B)fluoranthene (mg/Kg)	ND	-	-	-	-	-	-	-	-	-	-	-	2.2	-
Benzo(K)fluoranthene (mg/Kg)	ND	-	-	-	-	-	-	-	-	-	-	-	0.022	-
Chrysene (mg/Kg)	ND	-	-	-	-	-	-	-	-	-	-	-	22	-
Dibenzo(A,H)anthracene (mg/Kg)	ND	-	-	-	-	-	-	-	-	-	-	-	0.022	-
Fluoranthene (mg/Kg)	ND	-	-	-	-	-	-	-	-	-	-	-	1000	-
Fluorene (mg/Kg)	ND	-	-	-	-	-	-	-	-	-	-	-	1000	-
Indeno(1,2,3,C,D)pyrene (mg/Kg)	ND	-	-	-	-	-	-	-	-	-	-	-	0.22	-
Naphthalene (mg/Kg)	ND	-	-	-	-	-	-	-	-	-	-	-	23	-
Pyrene (mg/Kg)	ND	-	-	-	-	-	-	-	-	-	-	-	1000	-
Electrical Conductivity (mmhos/cm)	6.55	-	-	-	-	-	-	-	-	-	-	-	4	-
Sodium Adsorption Ratio (SAR)	31.9	-	-	-	-	-	-	-	-	-	-	-	12	-
pH	9.91	-	-	-	-	-	-	-	-	-	-	-	6-9	-
Arsenic (mg/kg)	4.2	-	-	-	-	-	-	-	-	-	-	-	0.39	-
Barium (mg/kg)	1180	-	-	-	-	-	-	-	-	-	-	-	15000	-
Cadmium (mg/kg)	<1.1	-	-	-	-	-	-	-	-	-	-	-	70	-
Chromium (III) (mg/Kg)	52.6	-	-	-	-	-	-	-	-	-	-	-	120000	-
Chromium (VI) (mg/Kg)	0.75	-	-	-	-	-	-	-	-	-	-	-	23	-
Copper (mg/kg)	11.7	-	-	-	-	-	-	-	-	-	-	-	3100	-
Lead (inorganic) (mg/kg)	10.8	-	-	-	-	-	-	-	-	-	-	-	400	-
Mercury (mg/kg)	<0.11	-	-	-	-	-	-	-	-	-	-	-	23	-
Nickel (mg/kg)	21.9	-	-	-	-	-	-	-	-	-	-	-	1600	-
Selenium (mg/kg)	<5.7	-	-	-	-	-	-	-	-	-	-	-	390	-
Silver (mg/kg)	<3.4	-	-	-	-	-	-	-	-	-	-	-	390	-
Zinc (mg/kg)	38.2	-	-	-	-	-	-	-	-	-	-	-	23000	-
% Solids	88.3	86.9	85.6	85.8	92.1	88.6	88.1	88.6	89.8	91.1	90.7	91.4	-	-

Notes:

- 1) ND = not detectable to the laboratory detection limit.
- 2) Results highlighted in yellow exceed Table 910-1 concentration levels. Results highlighted in Gray exceed Table 910-1, but are below background levels.
- 3) "-" indicates no analysis.
- 4) See site map for sample locations.



ARSENIC  
SURFACE (-1'): 5.9 mg/kg  
DEEP (-6.5'): 8.7 mg/kg

⊗ B-2

ARSENIC  
SURFACE (-1'): 7.1 mg/kg  
DEEP (-9.5'): 12.2 mg/kg

⊗ B-1

CUTTINGS TRENCH #3 SUBLINER  
TPH: 50.8 mg/kg  
BENZENE: ND  
ARSENIC: 4.4 mg/kg

RESERVE PIT SUBLINER  
TPH: 300 mg/kg  
BENZENE: ND  
ARSENIC: 5.2 mg/kg

CUTTINGS TRENCH #1 SUBLINER  
TPH: 271 mg/kg  
BENZENE: 0.0747 mg/kg  
ARSENIC: 6.5 mg/kg

CUTTINGS TRENCH #2 SUBLINER  
TPH: 127 mg/kg  
BENZENE: 0.0457 mg/kg  
ARSENIC: 17.1 mg/kg

⊗ B-3  
ARSENIC  
SURFACE (-1'): 5.9 mg/kg  
DEEP (-12'): 6.4 mg/kg

FRESHWATER PIT SUBLINER ●  
TPH: <500 mg/kg  
BENZENE: ND  
● ARSENIC: 4.2 mg/kg  
(SEE FIGURES 2, 2A, 2B)

NOTE:

BACKGROUND ARSENIC RESULTS ARE FROM  
DISCRETE SAMPLES.


LEGEND			
-----	EDGE OF PAD		
- - - - -	PIT / TRENCH		
⊗ B-4	BACKGROUND SAMPLE LOCATION (8/30/11)		
●	SUBLINER COMPOSITE TEST LOCATION		


0 50 100  
SCALE IN FEET  
1"=100'


DESIGNED:	CHECKED:	FIGURE	NOTES:
-	DK		
DATE:	DRAWN:		
5/9/12	DRF	1	
FILE NAME:	SHEET NO.		
sample.ars	1 of 4		
PROJECT NO.	SCALE:		
1108-02A	1"=100'		

KRW CONSULTING, INC.  
8000 W. 14TH AVENUE, SUITE 200  
LAKEWOOD, COLORADO  
(303) 239-9011

FIGURE 1  
PICEANCE CREEK  
PCU 297-15A  
SAMPLE LOCATIONS WITH  
ARSENIC LEVELS  
PREPARED FOR XTO ENERGY

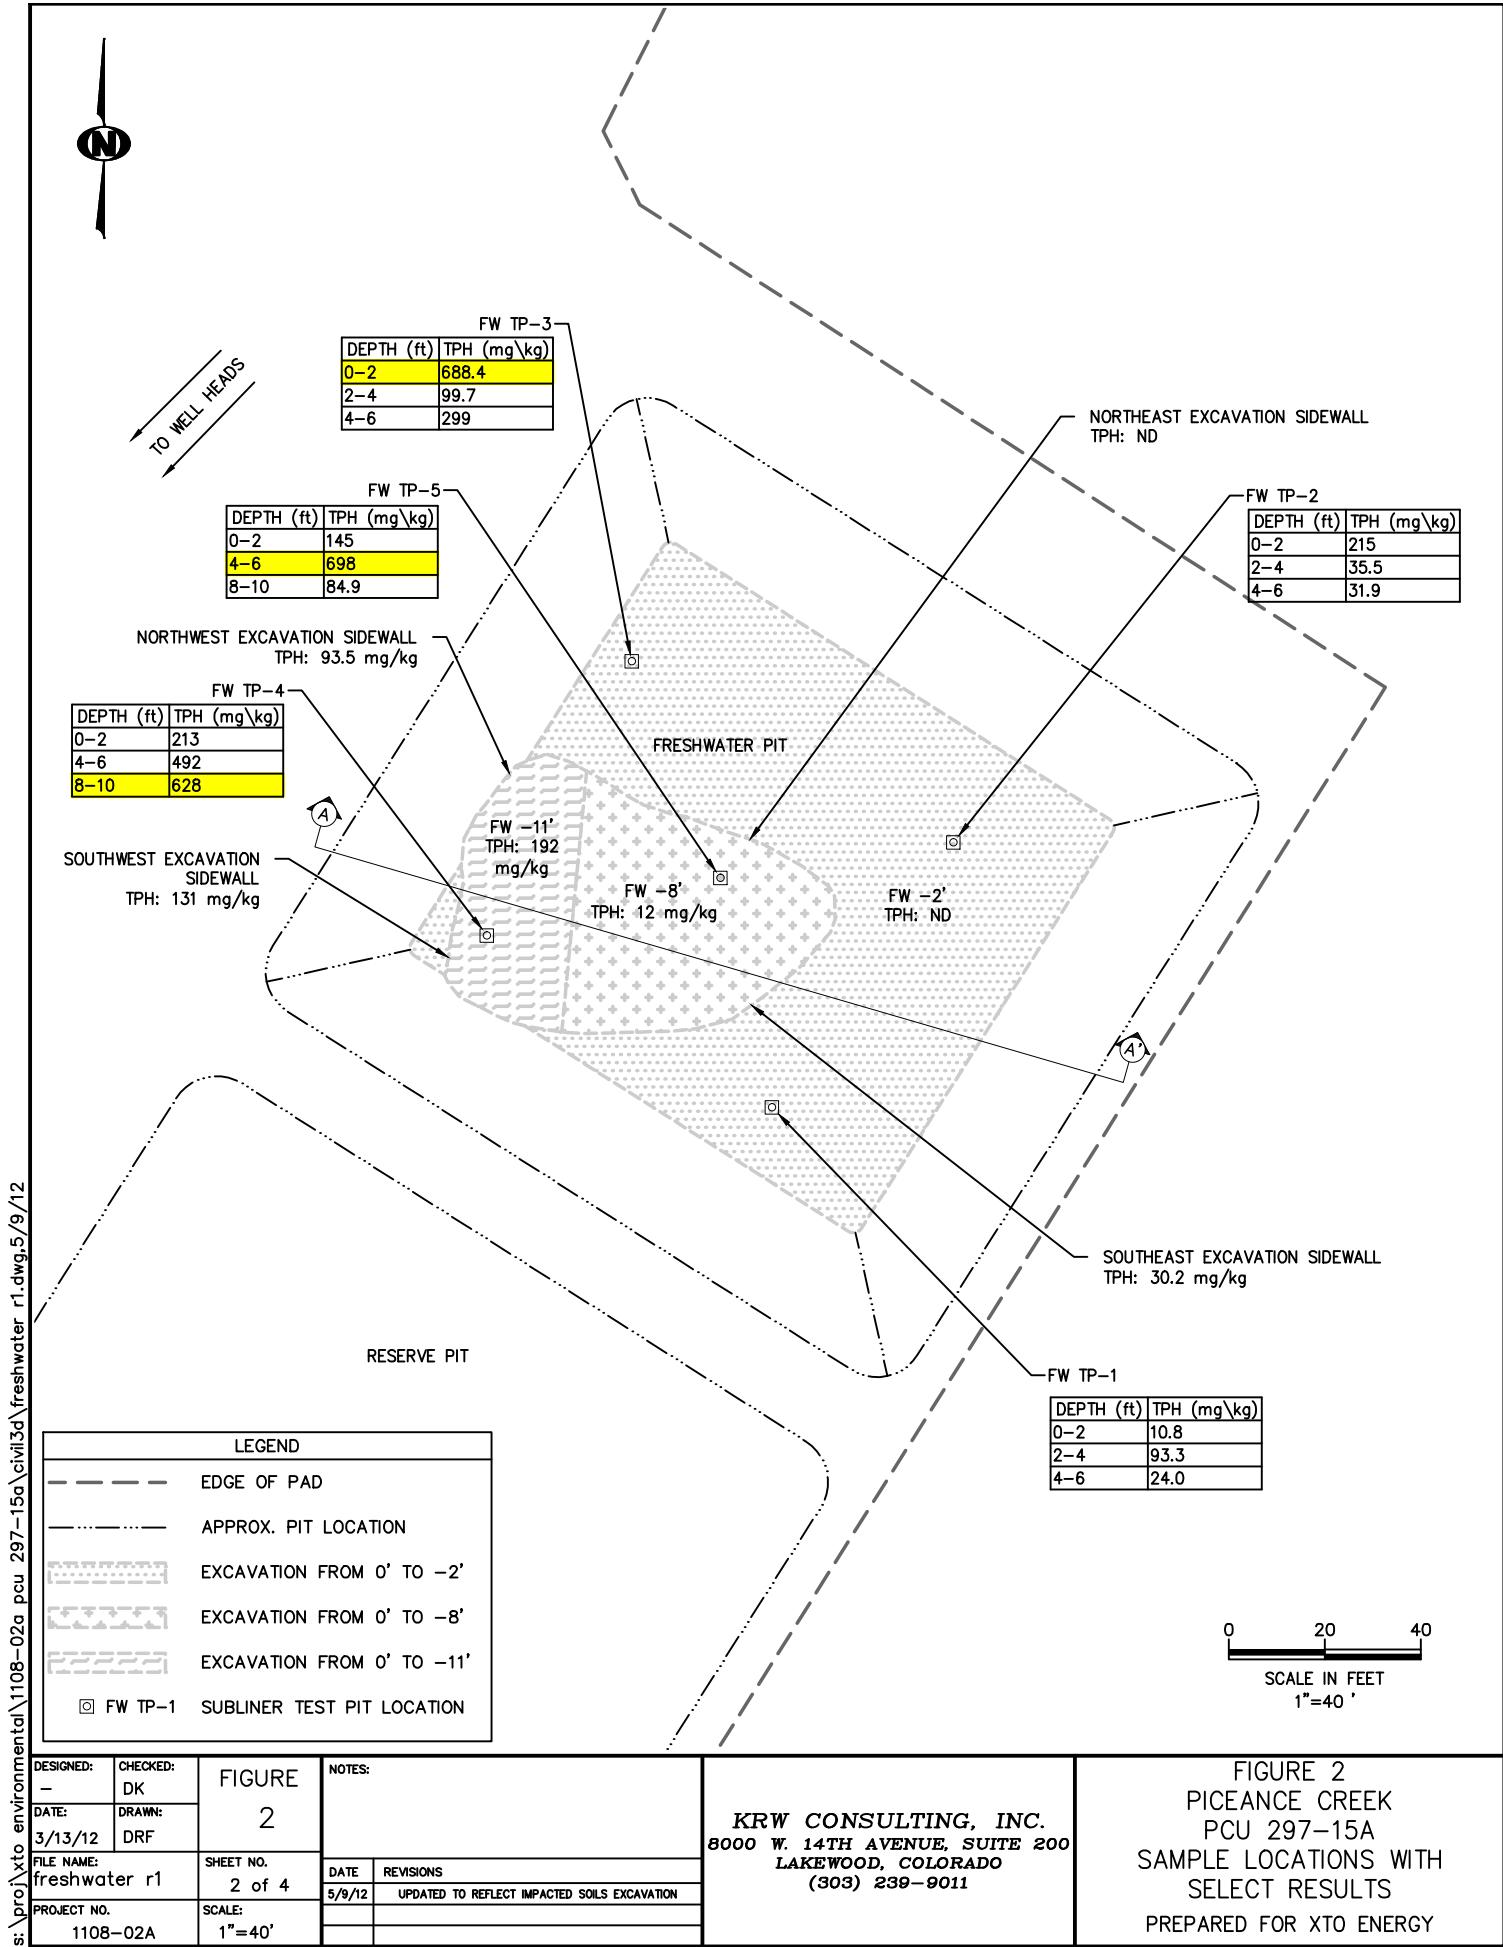

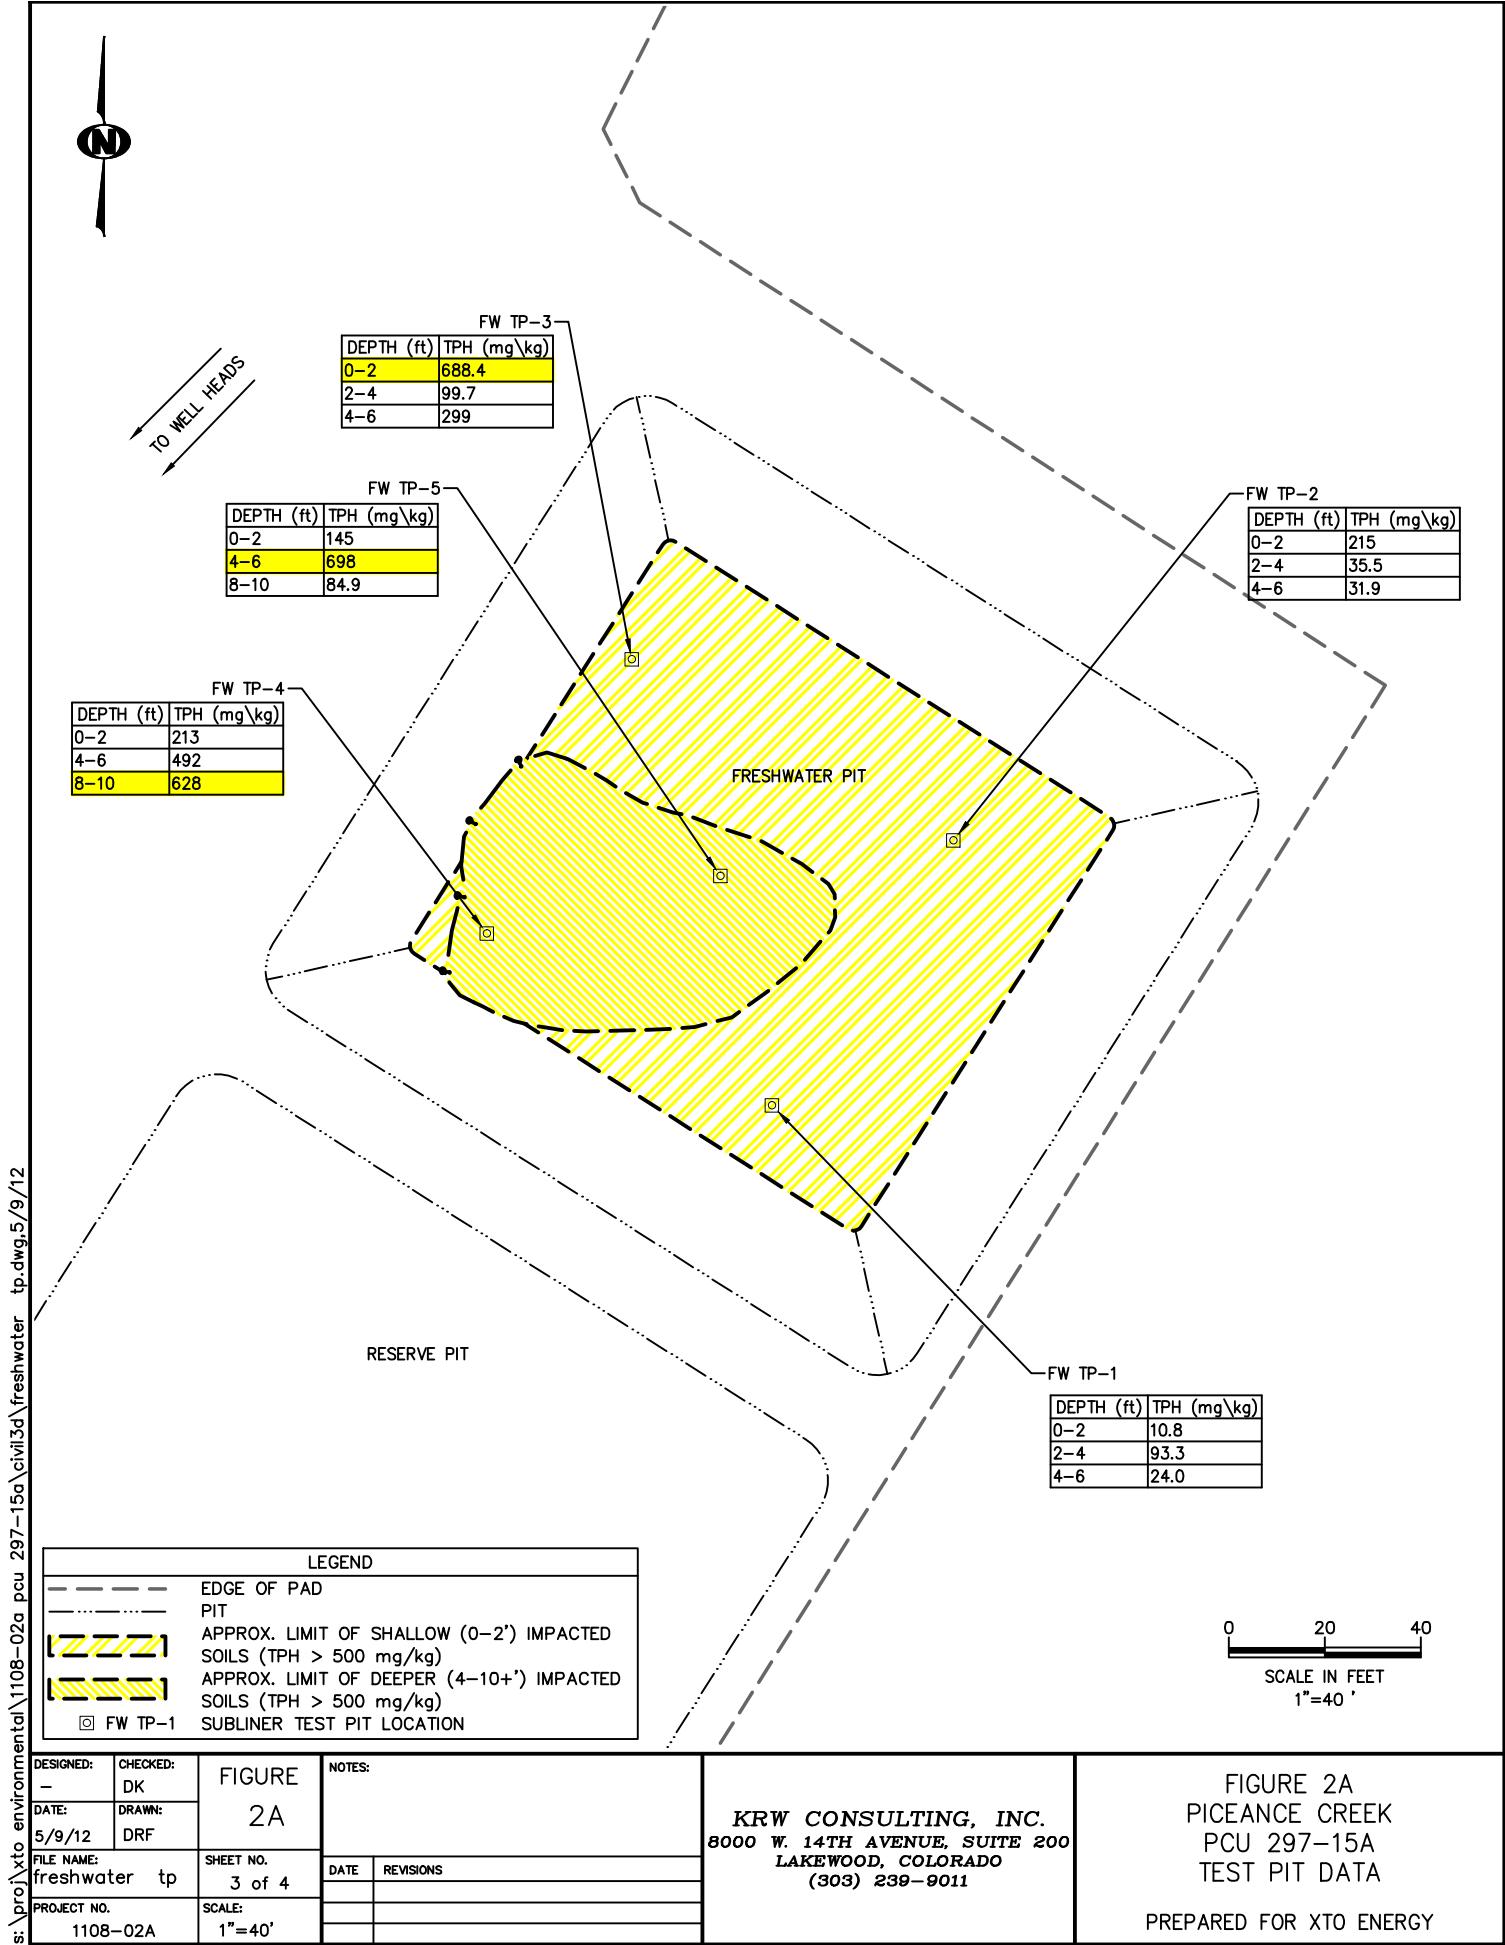

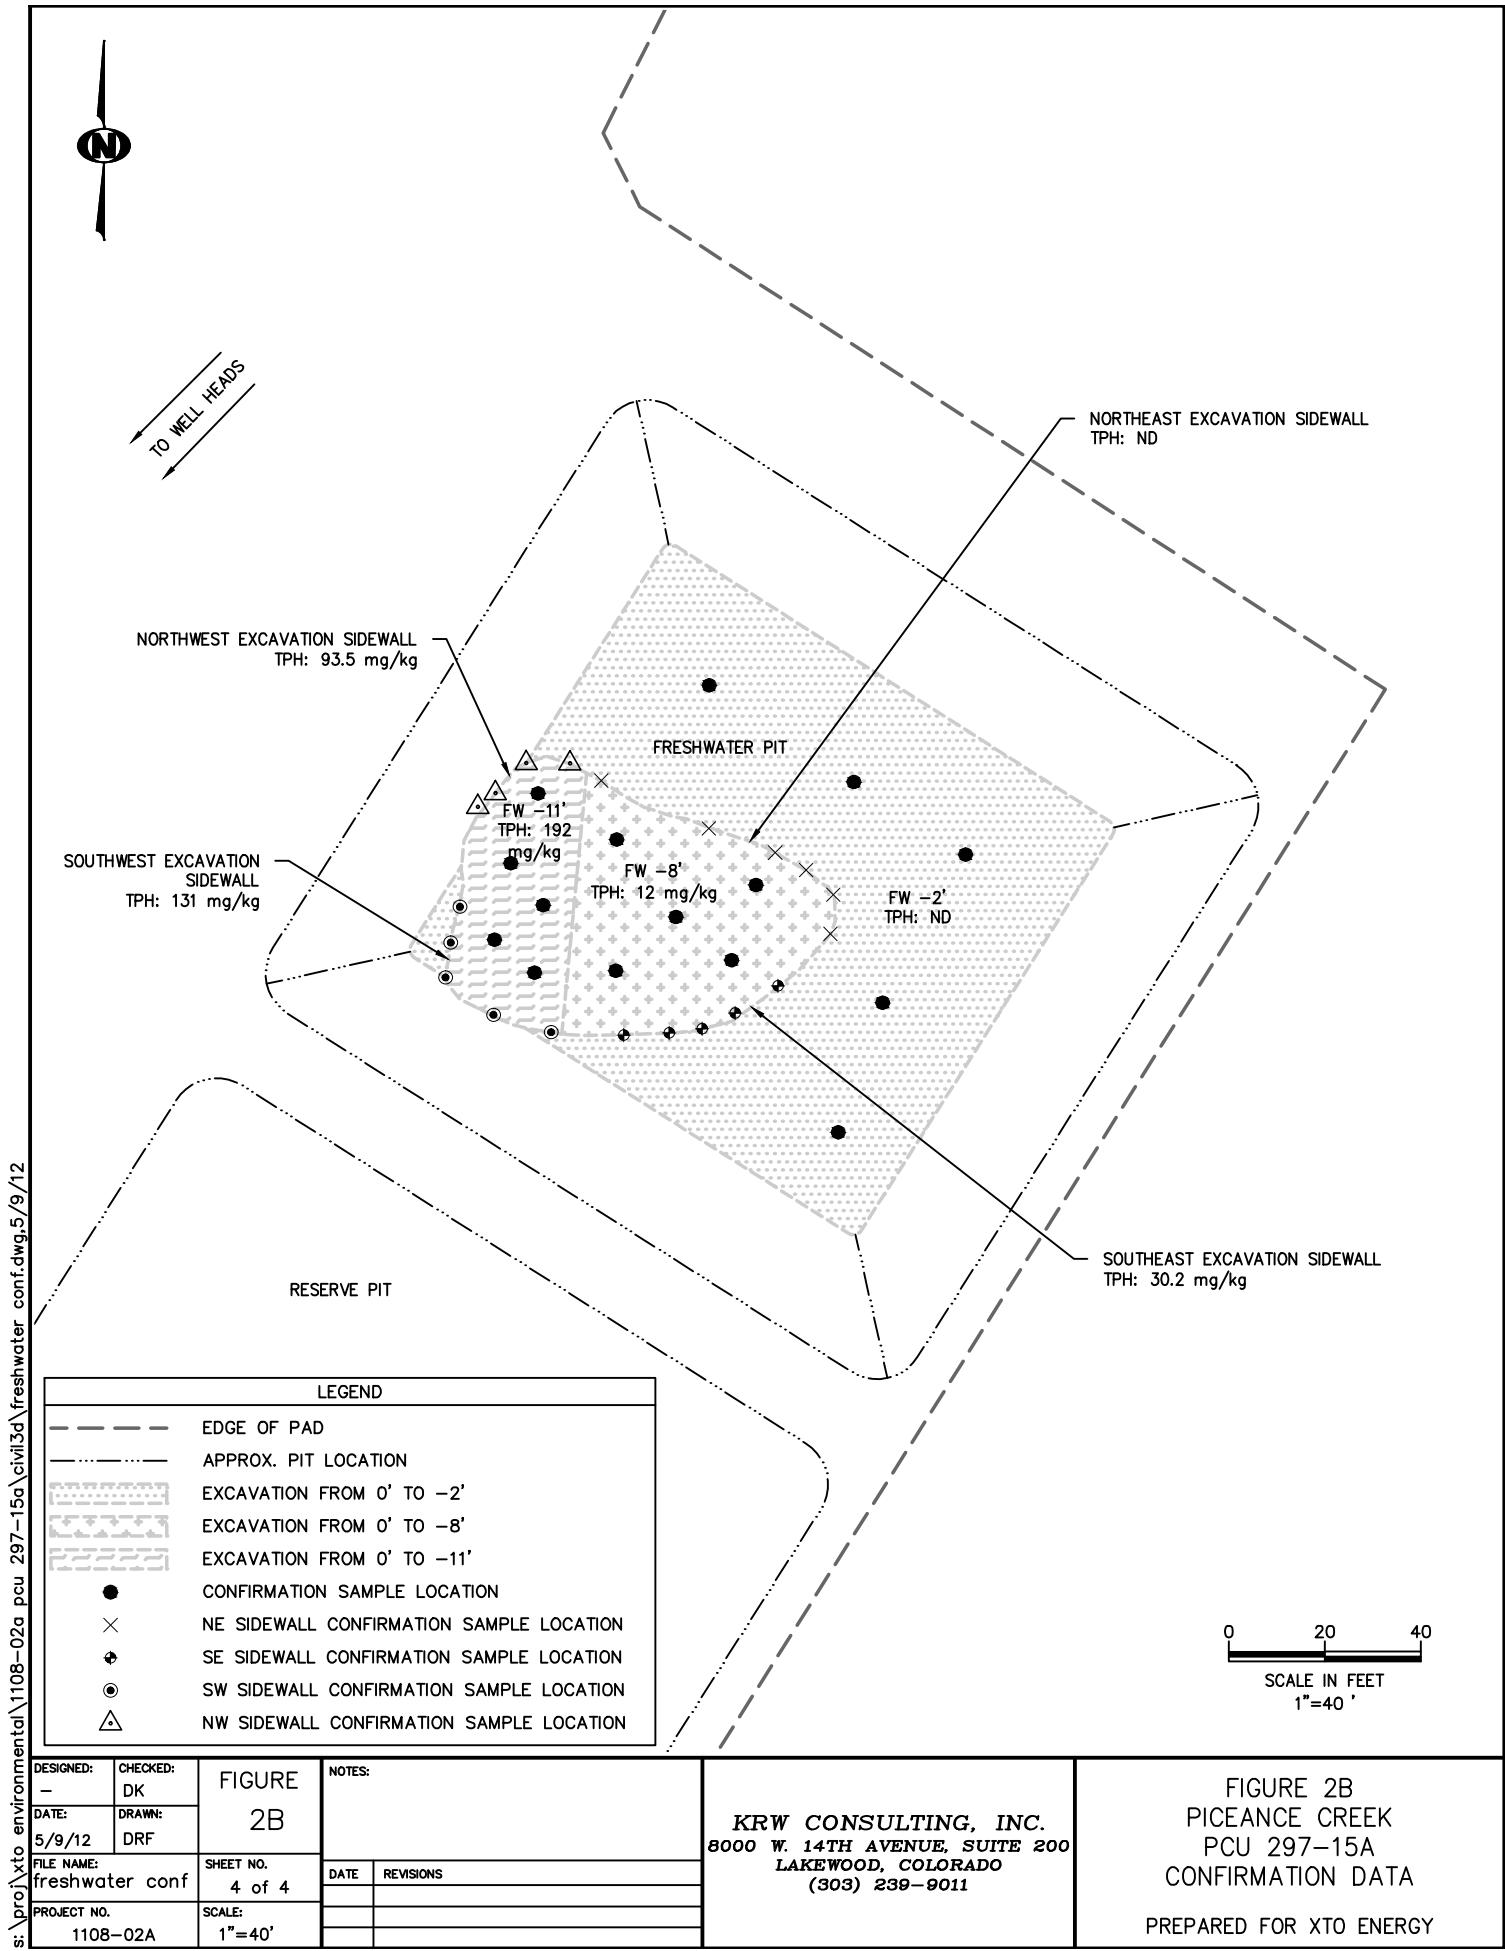

DESIGNED:	CHECKED:	FIGURE	NOTES:
-	DK	2B	
DATE: 5/9/12	DRAWN: DRF		
FILE NAME: freshwater conf	SHEET NO. 4 of 4		
PROJECT NO. 1108-02A	SCALE: 1"=40'		

KRW CONSULTING, INC.  
8000 W. 14TH AVENUE, SUITE 200  
LAKEWOOD, COLORADO  
(303) 239-9011

FIGURE 2B  
PICEANCE CREEK  
PCU 297-15A  
CONFIRMATION DATA  
PREPARED FOR XTO ENERGY