



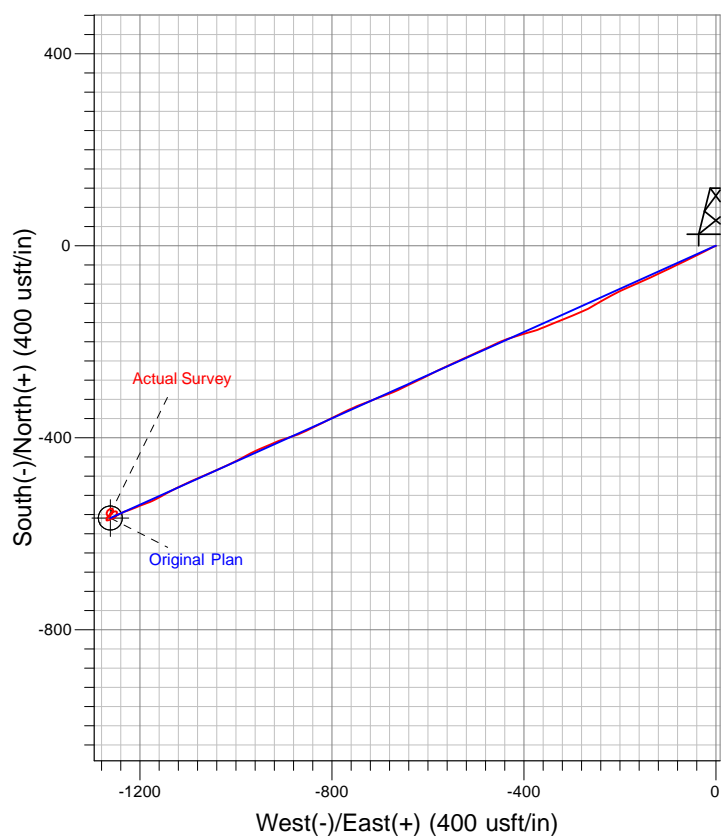

+N/-S	+E/-W	Northing	Easting	Latitude	Longitude	Slot

KELLY BUSHING @ 6799.0usft (Cyclone 29 (21' RKB) jjb)

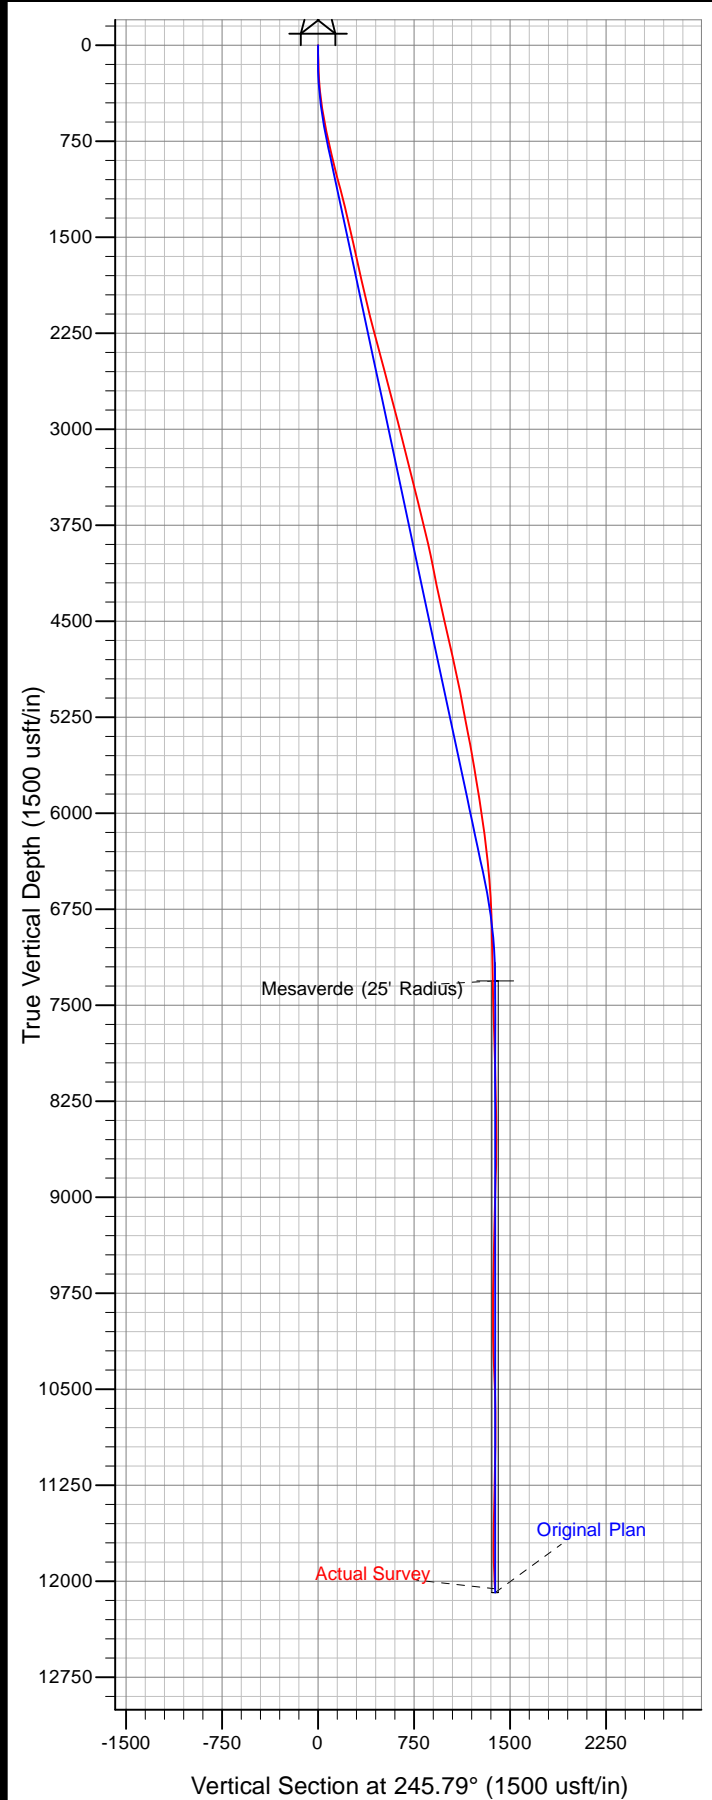

Azimuths to True North
Magnetic North: 10.55°

Magnetic Field
Strength: 52406.0snT
Dip Angle: 66.01°
Date: 8/23/2011
Model: IGRF2010