

Wellbore Diagram (Post Abandonment)
Texaco Starner #26-32

Location: SW/NE 26-9S-94W
Field:
County: Mesa, CO
API: 05-077-08444

Spud: 10/28/1981
RR:
Completed: 01/20/1982

KB: 7379' (13')
GL: 7366'

Date Drawn: 06/06/2012 (RSV)


Surface Casing: 8-5/8", 24#, K-55 in 12-1/4" hole
 Set at 369' KB
 Cemented to surface w/175 sx cement plus 12 sx bulk

Formation Tops:

Ohio Creek	4120
Mesa Verde	4164
Cameo	6646
Rollins	7010
Mancos	7310
Cozzette	7520
Corcoran	7680

Cement Top: 5275' (CBL log)

Production Casing: 4-1/2", 10.5 & 11.6#, K-55 in 7-7/8" hole set at 7814' KB.
 Cemented w/785 sx.

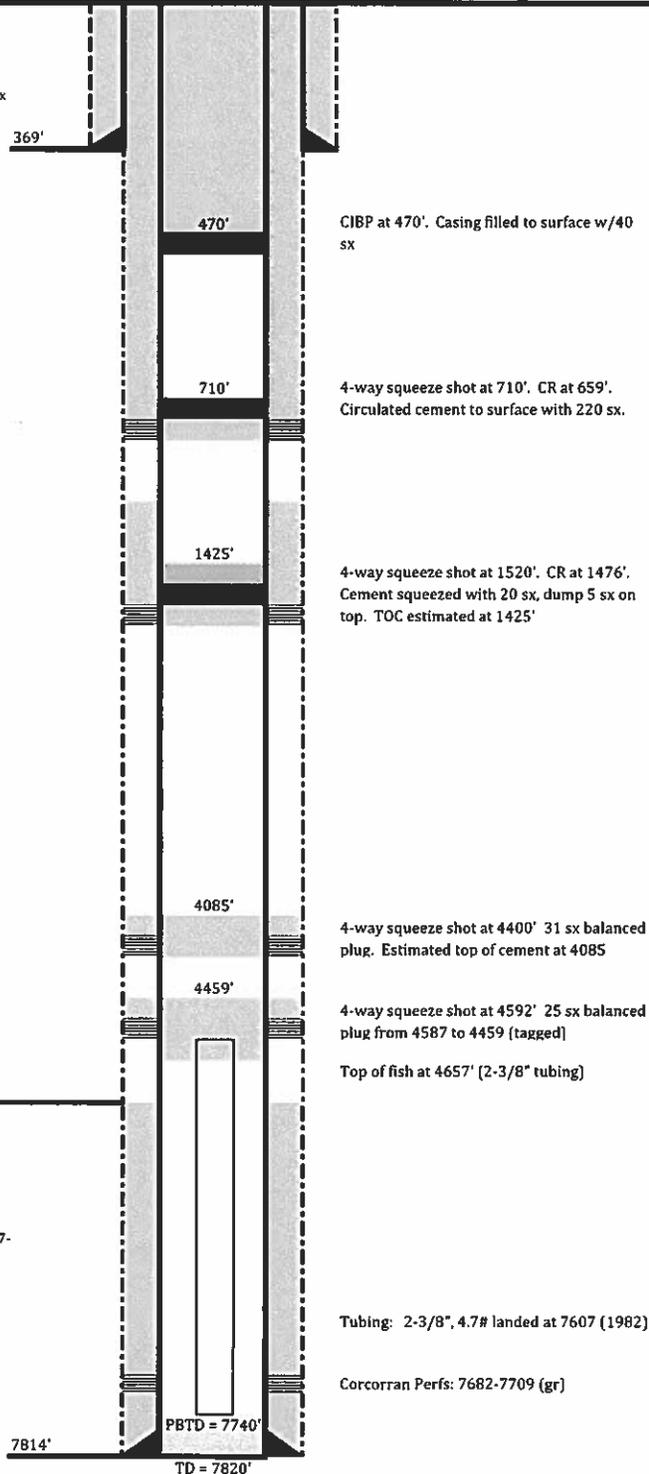

CIBP at 470'. Casing filled to surface w/40 sx

4-way squeeze shot at 710'. CR at 659'. Circulated cement to surface with 220 sx.

4-way squeeze shot at 1520'. CR at 1476'. Cement squeezed with 20 sx, dump 5 sx on top. TOC estimated at 1425'

4-way squeeze shot at 4400' 31 sx balanced plug. Estimated top of cement at 4085'

4-way squeeze shot at 4592' 25 sx balanced plug from 4587 to 4459 (tagged)

Top of fish at 4657' (2-3/8" tubing)

Tubing: 2-3/8", 4.7# landed at 7607 (1982)

Corcoran Perfs: 7682-7709 (gr)

PBTD = 7740'
 TD = 7820'