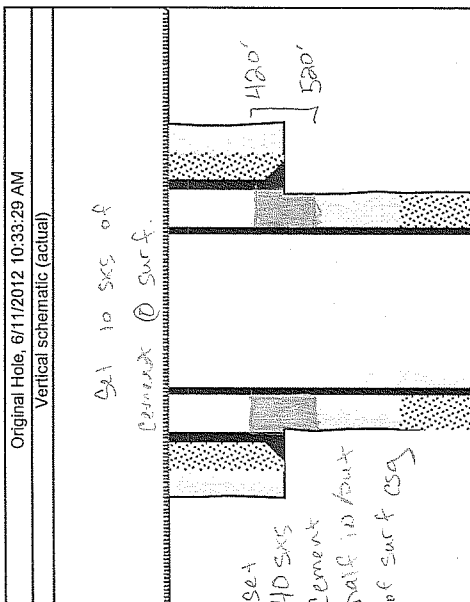


Well Name: BLEDSOE 06-32-04-43

API/UVI 05125090100000	Surface Legal Location SE NW Sec 32, T 4N, R 43W	Field Name NIOBRARA	License #	State/Province CO	Well Configuration Type
Original KB Elevation (ft) 3,719.00	KB-Tubing Head Distance (ft) 4/27/2005 00:00	Spud Date 4/27/2005 00:00	Rig Release Date 4/29/2005 00:00	PBTD (All) (ftKB) Original Hole - 2,419.0	Total Depth All (TVD) (ftKB)

Type

Des	Make	Model	WP (psi)	Service	WP Top (psi)	Top Ring Gasket	Bore Min (in)

Original Hole, 6/11/2012 10:33:29 AM									
Vertical schematic (actual)									
									
Casing Strings									
Csg Des	OD (in)	Wt/Len (lb/ft)	Grade	Top Thread	Set Depth (ftKB)				
Surface	7	20.00	H-40		461.0				
Production	4 1/2	10.50	J-55		2,503.0				
Perforations									
Date	Top (ftKB)	Blm (ftKB)	Zone						
6/1/2005	2,254.0	2,284.0							
Tubing Strings									
Tubing Description	Run Date	String Length (ft)	Set Depth (ftKB)						
Item Des	Jts	Make	Model	OD (in)	Wt (lb/ft)	Grade	Len (ft)		
Rod Strings									
Rod Description	Run Date	String Length (ft)	Set Depth (ftKB)						
Item Des	Jts	Make	Model	OD (in)	Wt (lb/ft)	Grade	Len (ft)		