


**Chevron 032-596**  
**Well Location**

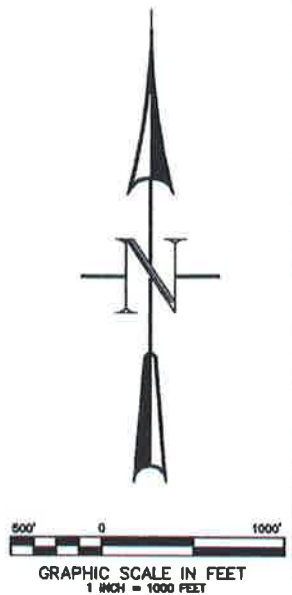

SECTION CORNER LOCATION  
BASED ON GLO RECORD  
INFORMATION

FIELD SURVEYED SECTION  
CORNER LOCATIONS

FIELD SURVEYED WELL  
LOCATION

CALCULATED BOTTOM  
HOLE LOCATION

CONSTRUCTION SURVEYS, INC.  
0012 SUNRISE BLVD.  
SILT, CO 81652  
(970) 876-5753

SURVEYED: 06
DRAFTED: 03
CHECKED: 03

SURVEYED: 06/19/06	SCALE: 1" = 1000'
DRAFTED: 03/22/10	DWG: BERRY\ LATHAM 032-596
CHECKED: 03/24/10	SHEET: 1 of 11