


MULTI-WELL PLAN

LATHAM 41-1 PAD

THIS MAP DOES NOT REPRESENT A BOUNDARY SURVEY

SECTION: 1
TOWNSHIP: 4N
RANGE: 63W

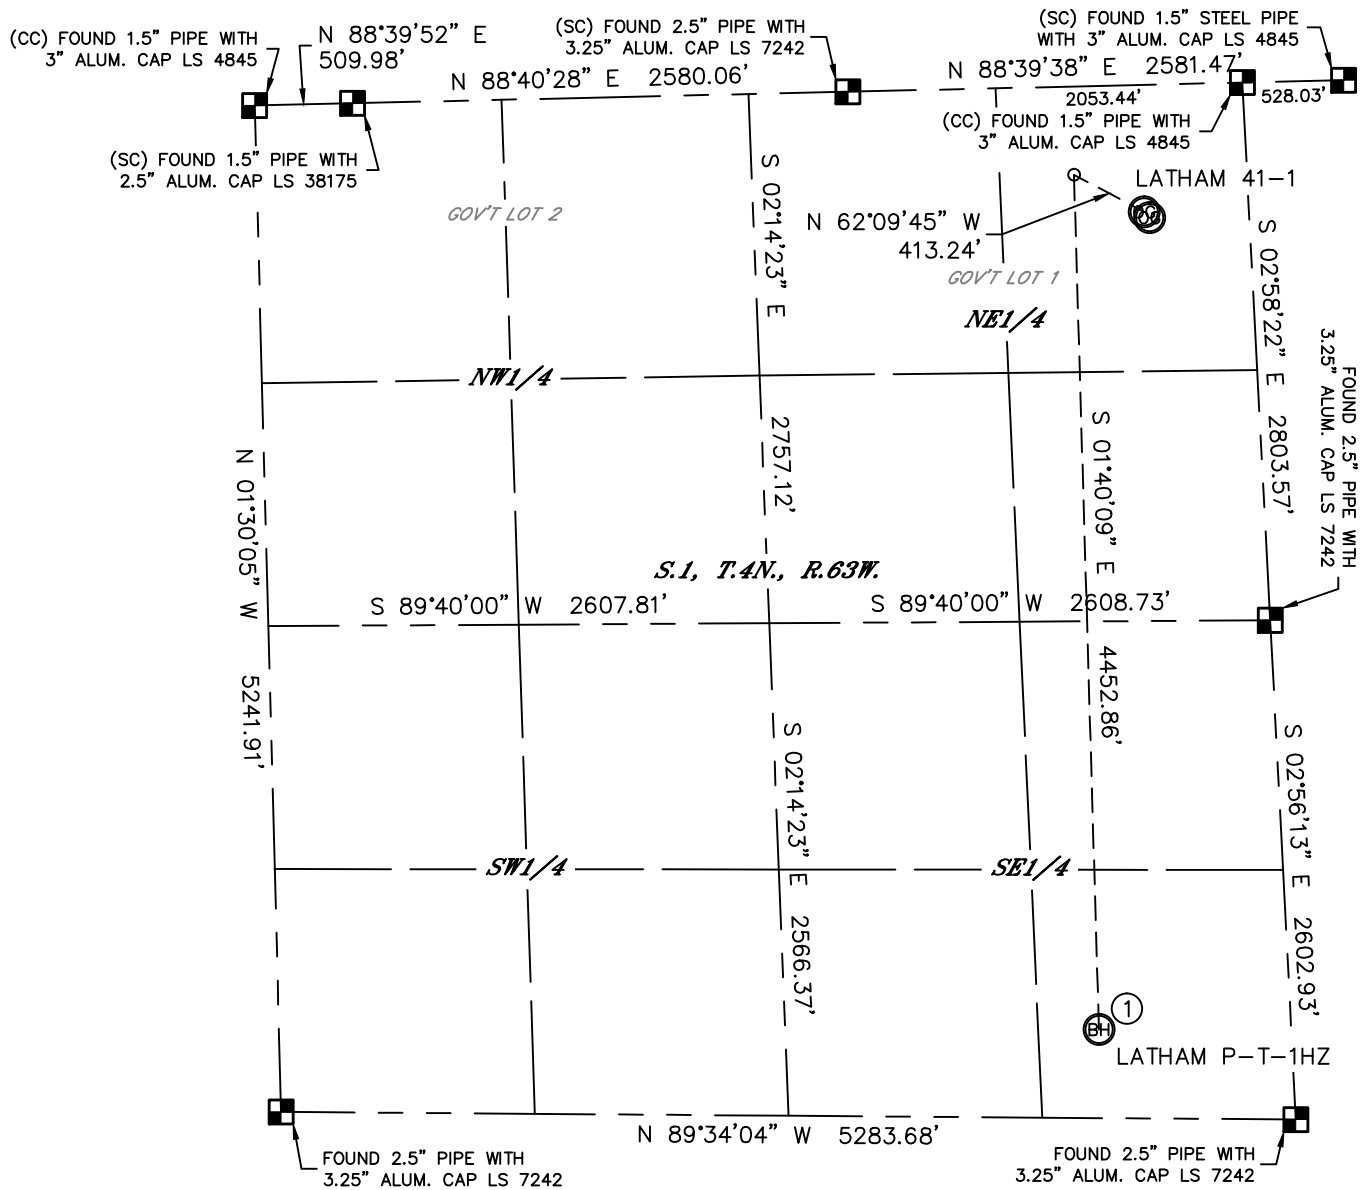

①

-BOTTOM HOLE-
LATHAM P-T-1HZ
460' FSL
1000' FEL
LAT-40.33558°N
LONG-104.38044°W




LEGEND



= ALIQUOT MONUMENT AS DESCRIBED



= CALCULATED POSITION

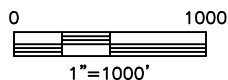

DATE: rev 6/20/2012
PROJECT#: 2011338



Lat40°, Inc. 1635 Foxtrail Drive, Suite 325 Loveland, CO 970-776-3321

MULTI-WELL PLAN

LATHAM 41-1 PAD

SECTION: 1
TOWNSHIP: 4N
RANGE: 63W

W

W

W

W

W

W

W

W

W

W

LATHAM P-T-1HZ
LATHAM 41-1
40'

