



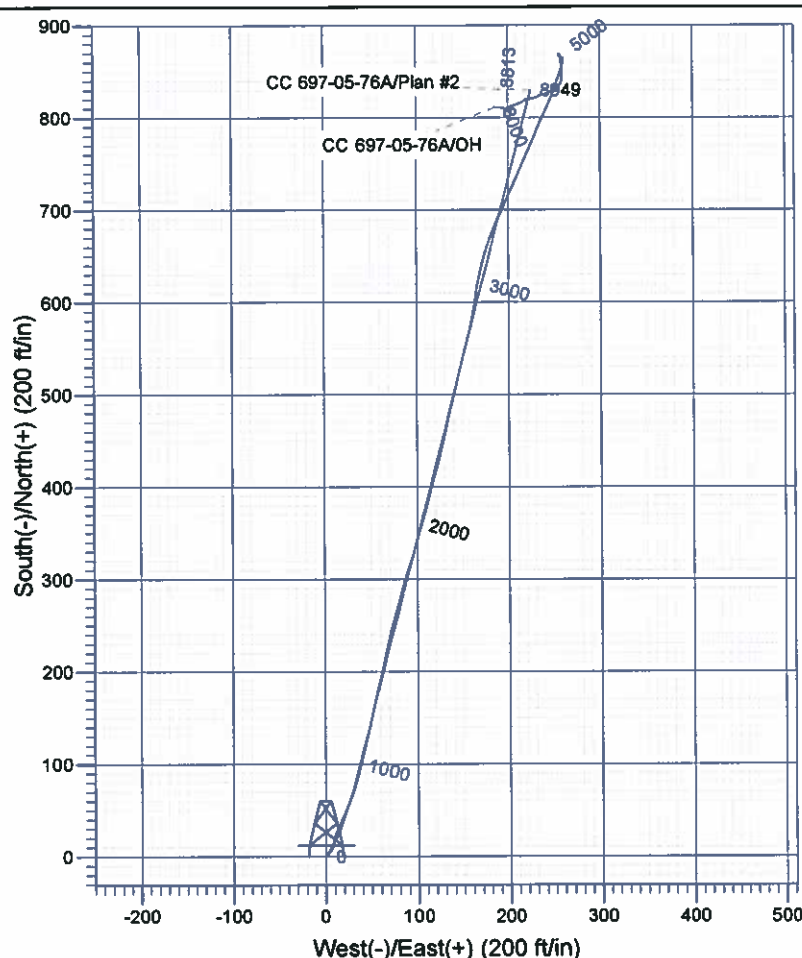

Scientific Drilling

Company: OXY USA RMAT
 Project: Garfield County, CO NAD27
 Site: Cascade Creek 697-08A Pad
 Well: CC 697-05-76A
 Wellbore: OH
 Design: OH

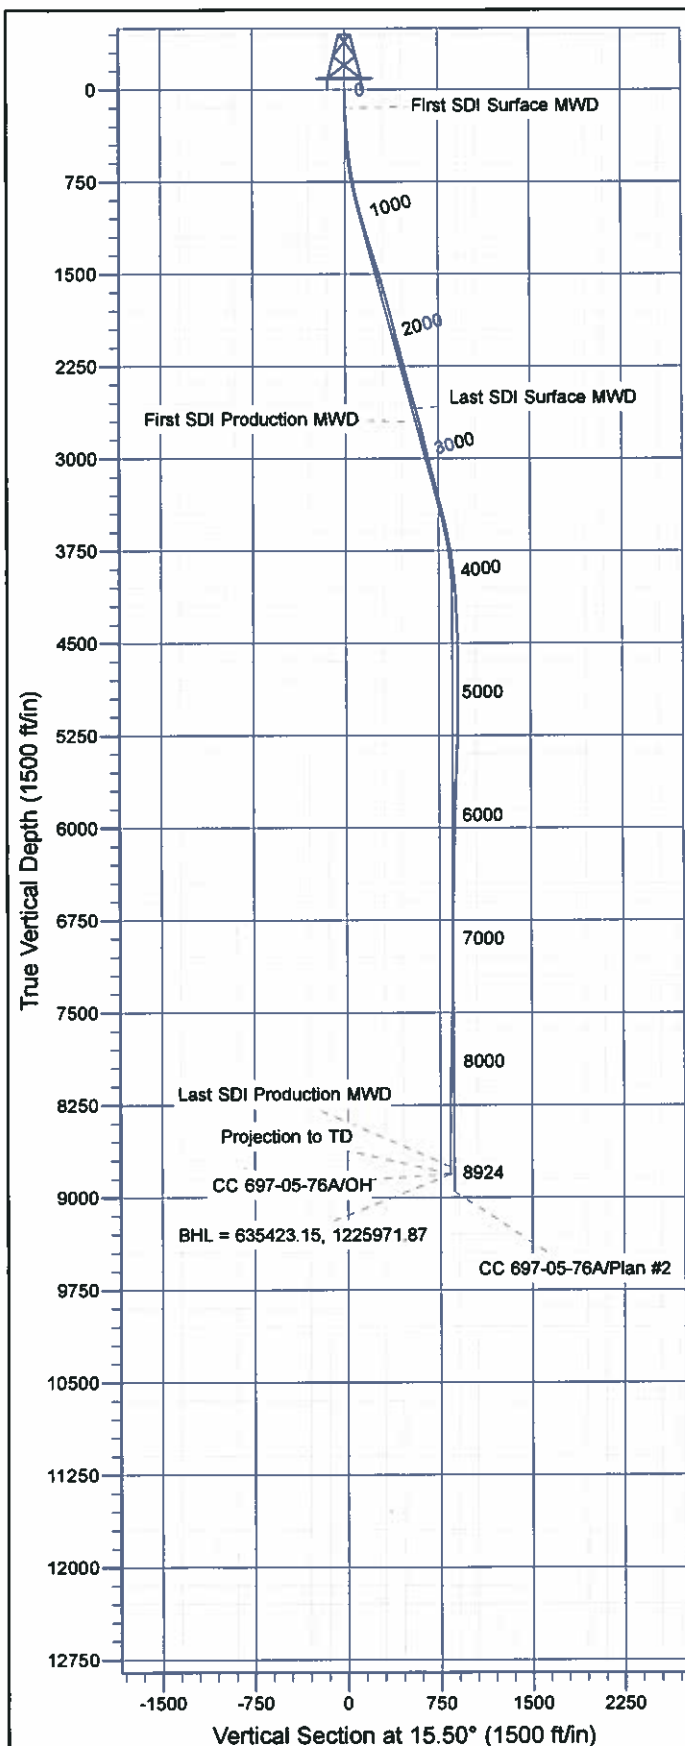

Well Details: CC 697-05-76A

+N/-S	+E/-W	Northing	Easting	Latitude	Longitude	Slot
0.00	0.00	634618.12	1225761.82	39° 32' 37.401 N	108° 14' 44.820 W	K

REFERENCE INFORMATION

Co-ordinate (NE) Reference: Well CC 697-05-76A - Slot K, True North
 Vertical (TVD) Reference: GL 8401' & RKB 30' @ 8431.00ft (H&P Rig)
 Section (VS) Reference: Slot - K(0.00N, 0.00E)
 Measured Depth Reference: GL 8401' & RKB 30' @ 8431.00ft (H&P Rig)
 Calculation Method: Minimum Curvature

PROJECT DETAILS: Garfield County, CO NAD27

Geodetic System: US State Plane 1927 (Exact solution)
 Datum: NAD 1927 (NADCON CONUS)
 Ellipsoid: Clarke 1866
 Zone: Colorado Central 502

System Datum: Mean Sea Level

Plan: OH

10:13, May 30 2012
 Created By: Janie Collins

OXY USA RMAT

**Garfield County, CO NAD27
Cascade Creek 697-08A Pad
CC 697-05-76A - Slot K**

OH

Design: OH

Standard Survey Report

30 May, 2012

Scientific Drilling International

Survey Report

Company:	OXY USA RMAT	Local Co-ordinate Reference:	Well CC 697-05-76A - Slot K
Project:	Garfield County, CO NAD27	TVD Reference:	GL 8401' & RKB 30' @ 8431.00ft (H&P Rig)
Site:	Cascade Creek 697-08A Pad	MD Reference:	GL 8401' & RKB 30' @ 8431.00ft (H&P Rig)
Well:	CC 697-05-76A	North Reference:	True
Wellbore:	OH	Survey Calculation Method:	Minimum Curvature
Design:	OH	Database:	Rockies Compass Server

Project	Garfield County, CO NAD27		
Map System:	US State Plane 1927 (Exact solution)	System Datum:	Mean Sea Level
Geo Datum:	NAD 1927 (NADCON CONUS)		
Map Zone:	Colorado Central 502		

Site		Cascade Creek 697-08A Pad, Sec 8 T6S R97W			
Site Position:		Northing:	635,765.16 usft	Latitude:	39° 32' 48.728 N
From:	Lat/Long	Easting:	1,225,748.33 usft	Longitude:	108° 14' 45.434 W
Position Uncertainty:	0.00 ft	Slot Radius:	13.200 in	Grid Convergence:	-1.73 °

Well	CC 697-05-76A - Slot K, 334' FNL & 1802' FWL					
Well Position	+N/-S	0.00 ft	Northing:	634,618.12 usft	Latitude:	39° 32' 37.401 N
	+E/-W	0.00 ft	Easting:	1,225,761.81 usft	Longitude:	108° 14' 44.820 W
Position Uncertainty		0.00 ft	Wellhead Elevation:	ft	Ground Level:	8,401.00 ft

Wellbore	OH				
Magnetics	Model Name	Sample Date	Declination (°)	Dip Angle (°)	Field Strength (nT)
	IGRF2005-10	2008/12/22	10.77	65.81	52,498

Design	OH				
Audit Notes:					
Version:	1.0	Phase:	ACTUAL	Tie On Depth:	0.00
Vertical Section:	Depth From (TVD) (ft)	+N/-S (ft)	+E/-W (ft)	Direction (°)	
	0.00	0.00	0.00	15.50	

Survey Program	Date	2012/05/30			
From (ft)	To (ft)	Survey (Wellbore)	Tool Name	Description	
145.00	2,666.00	Survey #1 - Surface MWD (OH)	MWD-SDI	MWD - Standard SCWSA	
2,772.00	8,924.00	Survey #2 - Production MWD (OH)	MWD-SDI	MWD - Standard SCWSA	

Survey									
Measured Depth (ft)	Inclination (°)	Azimuth (°)	Vertical Depth (ft)	+N/-S (ft)	+E/-W (ft)	Vertical Section (ft)	Dogleg Rate (°/100ft)	Build Rate (°/100ft)	Turn Rate (°/100ft)
0.00	0.00	0.00	0.00	0.00	0.00	0.00	0.00	0.00	0.00
145.00	1.75	45.94	144.98	1.54	1.59	1.91	1.21	1.21	0.00
First SDI Surface MWD									
235.00	3.48	41.57	234.88	4.54	4.39	5.55	1.93	1.92	-4.86
327.00	4.68	14.78	326.65	10.26	7.20	11.81	2.41	1.30	-29.12
419.00	4.92	10.27	418.33	17.77	8.86	19.49	0.49	0.26	-4.90
511.00	6.42	23.54	509.88	26.37	11.62	28.51	2.16	1.63	14.42
601.00	7.44	25.22	599.22	36.25	16.11	39.24	1.16	1.13	1.87
691.00	9.19	22.51	688.27	48.16	21.35	52.12	1.99	1.94	-3.01
783.00	10.48	20.91	778.92	62.77	27.15	67.74	1.43	1.40	-1.74

Scientific Drilling International

Survey Report

Company:	OXY USA RMAT	Local Co-ordinate Reference:	Well CC 697-05-76A - Slot K
Project:	Garfield County, CO NAD27	TVD Reference:	GL 8401' & RKB 30' @ 8431.00ft (H&P Rig)
Site:	Cascade Creek 697-08A Pad	MD Reference:	GL 8401' & RKB 30' @ 8431.00ft (H&P Rig)
Well:	CC 697-05-76A	North Reference:	True
Wellbore:	OH	Survey Calculation Method:	Minimum Curvature
Design:	OH	Database:	Rockies Compass Server

Survey									
Measured Depth (ft)	Inclination (°)	Azimuth (°)	Vertical Depth (ft)	+N/-S (ft)	+E/-W (ft)	Vertical Section (ft)	Dogleg Rate (°/100ft)	Build Rate (°/100ft)	Turn Rate (°/100ft)
873.00	12.93	17.30	867.04	80.03	33.06	85.96	2.84	2.72	-4.01
964.00	14.86	12.91	955.38	101.13	38.70	107.79	2.42	2.12	-4.82
1,058.00	15.92	12.56	1,046.01	125.46	44.20	132.71	1.13	1.13	-0.37
1,153.00	16.71	13.35	1,137.18	151.47	50.18	159.37	0.86	0.83	0.83
1,247.00	16.80	12.73	1,227.19	177.87	56.30	186.44	0.21	0.10	-0.66
1,342.00	17.32	12.56	1,318.01	205.06	62.40	214.28	0.55	0.55	-0.18
1,437.00	17.06	12.65	1,408.77	232.46	68.52	242.32	0.28	-0.27	0.09
1,531.00	17.32	15.46	1,498.57	259.40	75.27	270.08	0.93	0.28	2.99
1,626.00	15.65	15.28	1,589.66	285.39	82.42	297.04	1.76	-1.76	-0.19
1,720.00	16.00	17.39	1,680.10	309.99	89.63	322.66	0.72	0.37	2.24
1,815.00	13.72	17.92	1,771.92	333.20	97.01	347.01	2.40	-2.40	0.56
1,909.00	13.98	15.46	1,863.18	354.75	103.47	369.50	0.68	0.28	-2.62
2,004.00	14.95	14.93	1,955.17	377.65	109.69	393.23	1.03	1.02	-0.56
2,099.00	15.30	14.58	2,046.88	401.62	116.00	418.02	0.38	0.37	-0.37
2,193.00	14.07	15.55	2,137.81	424.64	122.18	441.84	1.33	-1.31	1.03
2,287.00	14.86	12.65	2,228.83	447.40	127.89	465.31	1.14	0.84	-3.09
2,382.00	14.51	13.17	2,320.72	470.88	133.27	489.37	0.39	-0.37	0.55
2,477.00	15.04	13.61	2,412.58	494.45	138.88	513.58	0.57	0.56	0.46
2,571.00	16.18	13.17	2,503.11	519.05	144.73	538.85	1.22	1.21	-0.47
2,666.00	15.74	14.58	2,594.45	544.41	150.99	564.96	0.62	-0.46	1.48
Last SDI Surface MWD									
2,772.00	15.26	13.33	2,696.60	571.90	157.83	593.28	0.55	-0.45	-1.18
First SDI Production MWD									
2,867.00	13.81	8.43	2,788.56	595.28	162.37	617.03	2.00	-1.53	-5.16
2,961.00	13.72	10.10	2,879.86	617.36	165.97	639.26	0.43	-0.10	1.78
3,056.00	13.81	13.44	2,972.13	639.48	170.58	661.81	0.84	0.09	3.52
3,150.00	13.28	18.01	3,063.52	660.66	176.53	683.80	1.27	-0.56	4.86
3,245.00	14.33	23.54	3,155.78	681.81	184.60	706.35	1.77	1.11	5.82
3,339.00	15.65	25.13	3,246.58	703.96	194.63	730.37	1.47	1.40	1.69
3,434.00	15.12	23.72	3,338.17	726.90	205.06	755.26	0.68	-0.56	-1.48
3,529.00	13.63	23.98	3,430.20	748.47	214.59	778.60	1.57	-1.57	0.27
3,623.00	13.37	23.72	3,521.60	768.54	223.46	800.31	0.28	-0.28	-0.28
3,717.00	11.70	23.81	3,613.36	787.21	231.68	820.50	1.78	-1.78	0.10
3,812.00	10.46	23.11	3,706.58	803.96	238.96	838.58	1.31	-1.31	-0.74
3,906.00	9.23	24.86	3,799.20	818.65	245.48	854.47	1.35	-1.31	1.86
4,001.00	7.03	18.53	3,893.24	831.07	250.53	867.80	2.50	-2.32	-6.66
4,095.00	4.48	19.94	3,986.76	839.98	253.61	877.21	2.72	-2.71	1.50
4,189.00	3.87	17.30	4,080.51	846.46	255.80	884.04	0.68	-0.65	-2.81
4,284.00	3.69	20.03	4,175.30	852.39	257.80	890.29	0.27	-0.19	2.87
4,378.00	3.69	13.70	4,269.11	858.17	259.56	896.33	0.43	0.00	-6.73
4,473.00	2.11	2.80	4,363.98	862.89	260.36	901.09	1.75	-1.66	-11.47
4,567.00	0.26	264.89	4,457.96	864.60	260.24	902.70	2.30	-1.97	-104.16
4,662.00	0.88	258.83	4,552.96	864.44	259.31	902.30	0.65	0.65	-6.38

Scientific Drilling International

Survey Report

Company:	OXY USA RMAT	Local Co-ordinate Reference:	Well CC 697-05-76A - Slot K
Project:	Garfield County, CO NAD27	TVD Reference:	GL 8401' & RKB 30' @ 8431.00ft (H&P Rig)
Site:	Cascade Creek 697-08A Pad	MD Reference:	GL 8401' & RKB 30' @ 8431.00ft (H&P Rig)
Well:	CC 697-05-76A	North Reference:	True
Wellbore:	OH	Survey Calculation Method:	Minimum Curvature
Design:	OH	Database:	Rockies Compass Server

Survey

Measured Depth (ft)	Inclination (°)	Azimuth (°)	Vertical Depth (ft)	+N/-S (ft)	+E/-W (ft)	Vertical Section (ft)	Dogleg Rate (°/100ft)	Build Rate (°/100ft)	Turn Rate (°/100ft)
4,756.00	0.88	275.97	4,646.94	864.38	257.88	901.86	0.28	0.00	18.23
4,851.00	1.67	325.54	4,741.92	865.59	256.37	902.62	1.36	0.83	52.18
4,945.00	1.49	345.84	4,835.89	867.91	255.30	904.57	0.62	-0.19	21.60
5,040.00	0.26	57.38	4,930.88	869.22	255.18	905.80	1.50	-1.29	75.31
5,134.00	1.14	148.00	5,024.87	868.54	255.85	905.33	1.25	0.94	96.40
5,229.00	0.79	133.23	5,119.86	867.29	256.83	904.39	0.45	-0.37	-15.55
5,323.00	1.85	176.91	5,213.83	865.33	257.38	902.65	1.48	1.13	46.47
5,418.00	2.20	172.96	5,308.77	861.99	257.69	899.51	0.40	0.37	-4.16
5,512.00	2.46	170.06	5,402.69	858.22	258.26	896.02	0.30	0.28	-3.09
5,607.00	2.46	181.40	5,497.61	854.17	258.56	892.20	0.51	0.00	11.94
5,702.00	2.02	184.03	5,592.54	850.46	258.39	888.58	0.48	-0.46	2.77
5,796.00	1.93	182.89	5,686.48	847.23	258.20	885.42	0.10	-0.10	-1.21
5,891.00	2.02	177.53	5,781.42	843.96	258.19	882.26	0.22	0.09	-5.64
5,985.00	1.76	182.89	5,875.37	840.86	258.19	879.28	0.33	-0.28	5.70
6,080.00	1.67	192.91	5,970.33	838.05	257.81	876.47	0.33	-0.09	10.55
6,175.00	1.67	218.05	6,065.29	835.61	256.64	873.81	0.77	0.00	26.46
6,269.00	1.58	224.20	6,159.25	833.61	254.90	871.41	0.21	-0.10	6.54
6,363.00	1.49	235.89	6,253.22	831.99	252.98	869.34	0.35	-0.10	12.44
6,458.00	2.11	240.28	6,348.17	830.43	250.44	867.16	0.67	0.65	4.62
6,553.00	1.14	237.65	6,443.13	829.06	248.12	865.22	1.02	-1.02	-2.77
6,647.00	1.23	233.25	6,537.11	827.96	246.52	863.72	0.14	0.10	-4.68
6,742.00	1.32	250.04	6,632.09	826.97	244.68	862.28	0.40	0.09	17.67
6,837.00	1.06	252.41	6,727.07	826.33	242.81	861.17	0.28	-0.27	2.49
6,931.00	1.58	245.29	6,821.04	825.53	240.80	859.86	0.58	0.55	-7.57
7,025.00	2.02	262.96	6,915.00	824.78	237.98	858.39	0.75	0.47	18.80
7,120.00	1.23	244.59	7,009.96	824.14	235.40	857.08	0.99	-0.83	-19.34
7,215.00	0.79	210.40	7,104.95	823.14	234.15	855.78	0.77	-0.46	-35.99
7,309.00	1.14	259.53	7,198.93	822.41	232.90	854.74	0.92	0.37	52.27
7,404.00	1.67	249.86	7,293.90	821.76	230.67	853.52	0.61	0.56	-10.18
7,498.00	1.85	252.32	7,387.86	820.83	227.94	851.89	0.21	0.19	2.62
7,593.00	2.02	262.61	7,482.81	820.15	224.82	850.40	0.41	0.18	10.83
7,687.00	1.41	265.42	7,576.76	819.84	222.02	849.36	0.65	-0.65	2.99
7,782.00	1.14	243.01	7,671.74	819.32	220.02	848.32	0.59	-0.28	-23.59
7,877.00	2.37	238.53	7,766.69	817.87	217.50	846.24	1.30	1.29	-4.72
7,971.00	2.64	246.79	7,860.60	816.00	213.85	843.47	0.48	0.29	8.79
8,012.61	2.79	248.27	7,902.17	815.25	212.03	842.26	0.40	0.37	3.56
CC 697-05-76A Target									
8,066.00	2.99	249.95	7,955.49	814.29	209.51	840.66	0.40	0.37	3.14
8,160.00	4.22	248.02	8,049.30	812.15	204.00	837.13	1.31	1.31	-2.05
8,255.00	2.46	243.18	8,144.14	809.92	198.94	833.63	1.87	-1.85	-5.09
8,349.00	0.35	269.41	8,238.10	809.11	196.87	832.29	2.37	-2.24	49.18
8,444.00	0.35	327.03	8,333.10	809.45	196.44	832.50	0.24	0.00	39.60
8,539.00	0.97	308.84	8,428.10	810.20	195.65	833.02	0.68	0.65	-19.15
8,633.00	1.06	270.52	8,522.08	810.70	194.16	833.11	0.71	0.10	-40.77

Scientific Drilling International

Survey Report

Company:	OXY USA RMAT	Local Co-ordinate Reference:	Well CC 697-05-76A - Slot K
Project:	Garfield County, CO NAD27	TVD Reference:	GL 8401' & RKB 30' @ 8431.00ft (H&P Rig)
Site:	Cascade Creek 697-08A Pad	MD Reference:	GL 8401' & RKB 30' @ 8431.00ft (H&P Rig)
Well:	CC 697-05-76A	North Reference:	True
Wellbore:	OH	Survey Calculation Method:	Minimum Curvature
Design:	OH	Database:	Rockies Compass Server

Survey

Measured Depth (ft)	Inclination (°)	Azimuth (°)	Vertical Depth (ft)	+N/-S (ft)	+E/-W (ft)	Vertical Section (ft)	Dogleg Rate (°/100ft)	Build Rate (°/100ft)	Turn Rate (°/100ft)
8,727.00	1.58	270.25	8,616.06	810.72	192.00	832.54	0.55	0.55	-0.29
8,822.00	1.85	272.54	8,711.01	810.79	189.16	831.85	0.29	0.28	2.41
8,864.00	2.02	273.86	8,752.99	810.87	187.74	831.55	0.42	0.40	3.14
Last SDI Production MWD									
8,924.00	2.02	273.86	8,812.95	811.01	185.63	831.12	0.00	0.00	0.00
Projection to TD - BHL = 635423.15, 1225971.87									

Design Annotations

Measured Depth (ft)	Vertical Depth (ft)	Local Coordinates		Comment
		+N/-S (ft)	+E/-W (ft)	
145.00	144.98	1.54	1.59	First SDI Surface MWD
2,666.00	2,594.45	544.41	150.99	Last SDI Surface MWD
2,772.00	2,696.60	571.90	157.83	First SDI Production MWD
8,864.00	8,752.99	810.87	187.74	Last SDI Production MWD
8,924.00	8,812.95	811.01	185.63	Projection to TD
8,924.00	8,812.95	811.01	185.63	BHL = 635423.15, 1225971.87

Checked By: _____ Approved By: _____ Date: _____