High Prairie Survey Co.

Physical Address: 345 Comanche St.
Mail to: Box 384 Kiowa, CO 80117
Ph. 303-621-8672 - Fax 303-621-2717
www.highprairiesurvey.com

Job # 12116-Baker "A" #1 OWWO

TOPO MAP

High Prairie Surveying of Kiowa, Colorado has in accordance with a request from **Tanins Tritt, Mull Drilling Company** has determined the location of **Baker "A" #1 OWWO (Capped Well)** to be 2043 feet FNL, and 733 feet FEL, (90° off Section lines) **of** SECTION **6**, Township **12s**, Range **48w** of the 6th Principal Meridian, **Cheyenne County**, Colorado.

Date: Staked on 6-26-12 drawn on 6-29-12.

Re: Staked by Keith Westfall
Drawn: Drawn by Elijah Frane

Basis of Elevation Spot: USGS BM = GOETZCKE, PID = AB3996, H-Order = GPS OBS, V-Order = GPS OBS, Stability = D, P-DOP = 2.6, Sats = 7 US NAD 83 CO-C, Lat. = 39.02801, Long. = 102.79866, Elevation = 4801.00 gr. (us FT).

Notes: There are no apparent improvements within 400 ft of proposed well pad..
The ground elevation at staked location = 4824.66' gr.
This drawing does not represent a monumented survey or Land Survey Plat.
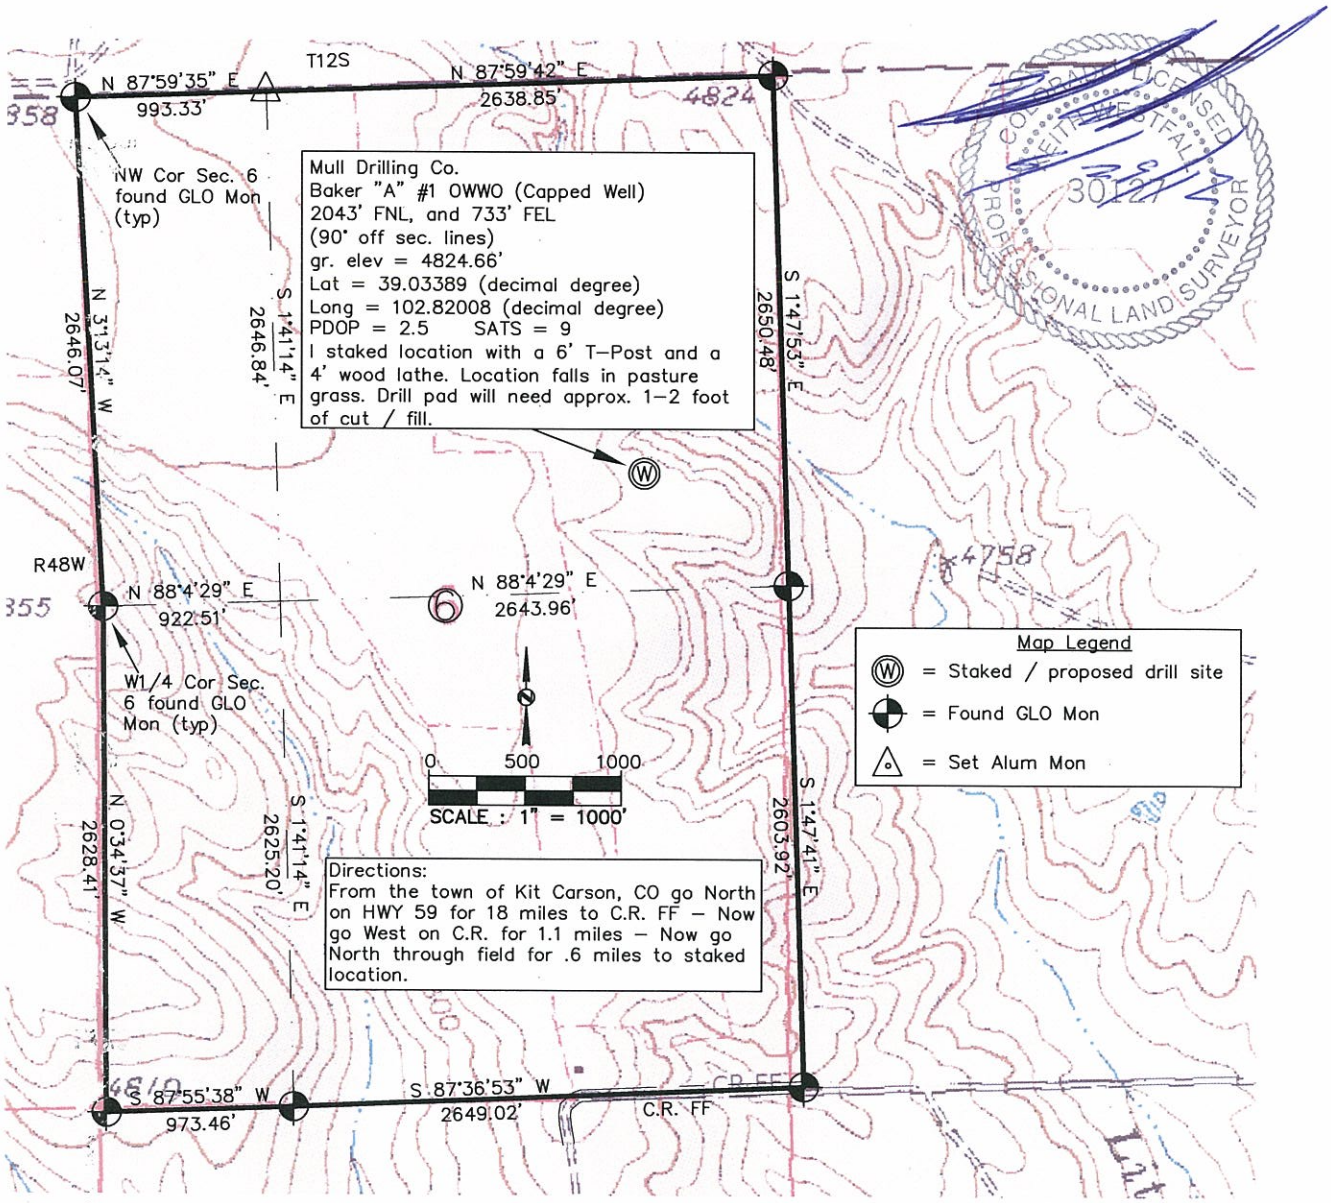
Basis of Bearing: Bearings were determined based on the North line of the Northeast 1/4 of Section 6 to bear N 87°59'42" E with all other bearings contained herein relative thereto.