



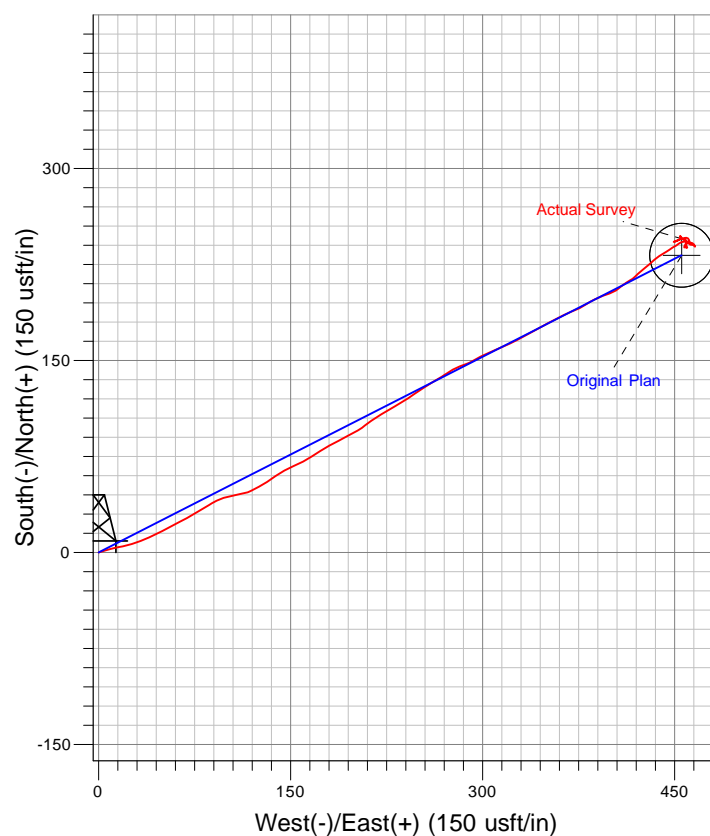

+N/-S	+E/-W	Northing	Easting	Latitude	Longitude	Slot
0.0	0.0	1775419.20	2201844.60	39° 55' 40.850 N	108° 20' 46.542 W	B7

KELLY BUSHING @ 6707.0usft (Frontier 10 (22' RKB) kjs)

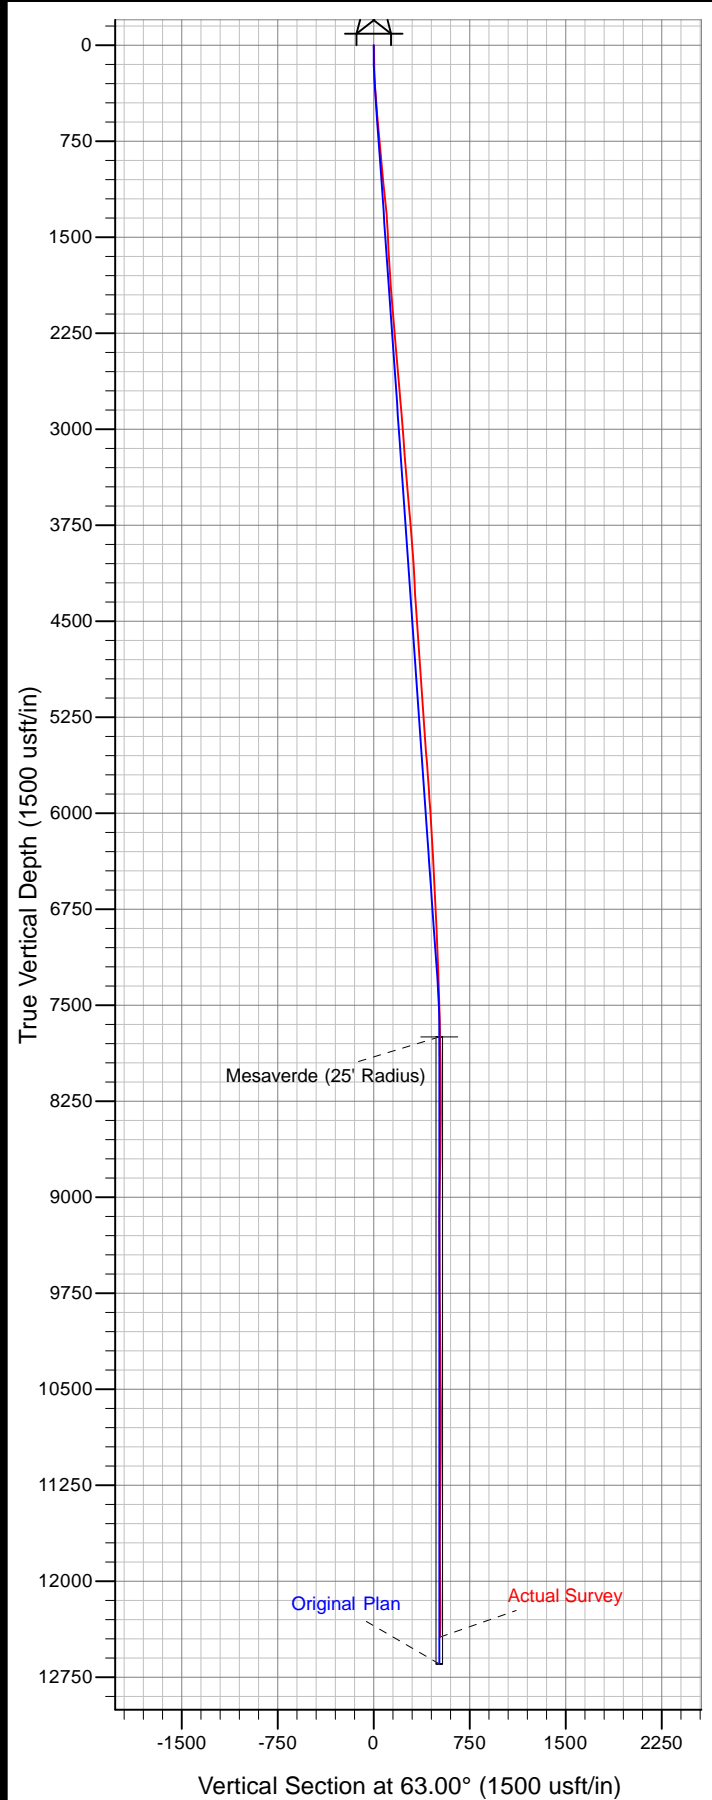

Azimuths to True North
Magnetic North: 10.51°

Magnetic Field

Strength: 52390.5nT

Dip Angle: 66.02°

Date: 11/15/2011

Model: IGRF2010