SWEPI LP

CONSTRUCTION LAYOUT FOR

DEAL GULCH #1-16 & #2-16
SECTION 16, T5N, R90W, 6th P.M.
SW 1/4 NE 1/4

FIGURE #1

SCALE: 1" = 60'
DATE: 12-05-11
DRAWN BY: J.I.
REV.: 02-08-12
REV: 05-17-12 J.M.H.
REV: 06-19-12 J.M.H.

ROBERT L. KAY
REGISTERED
17492
LAND SURVEYOR
STATE OF COLORADO
06-20-12

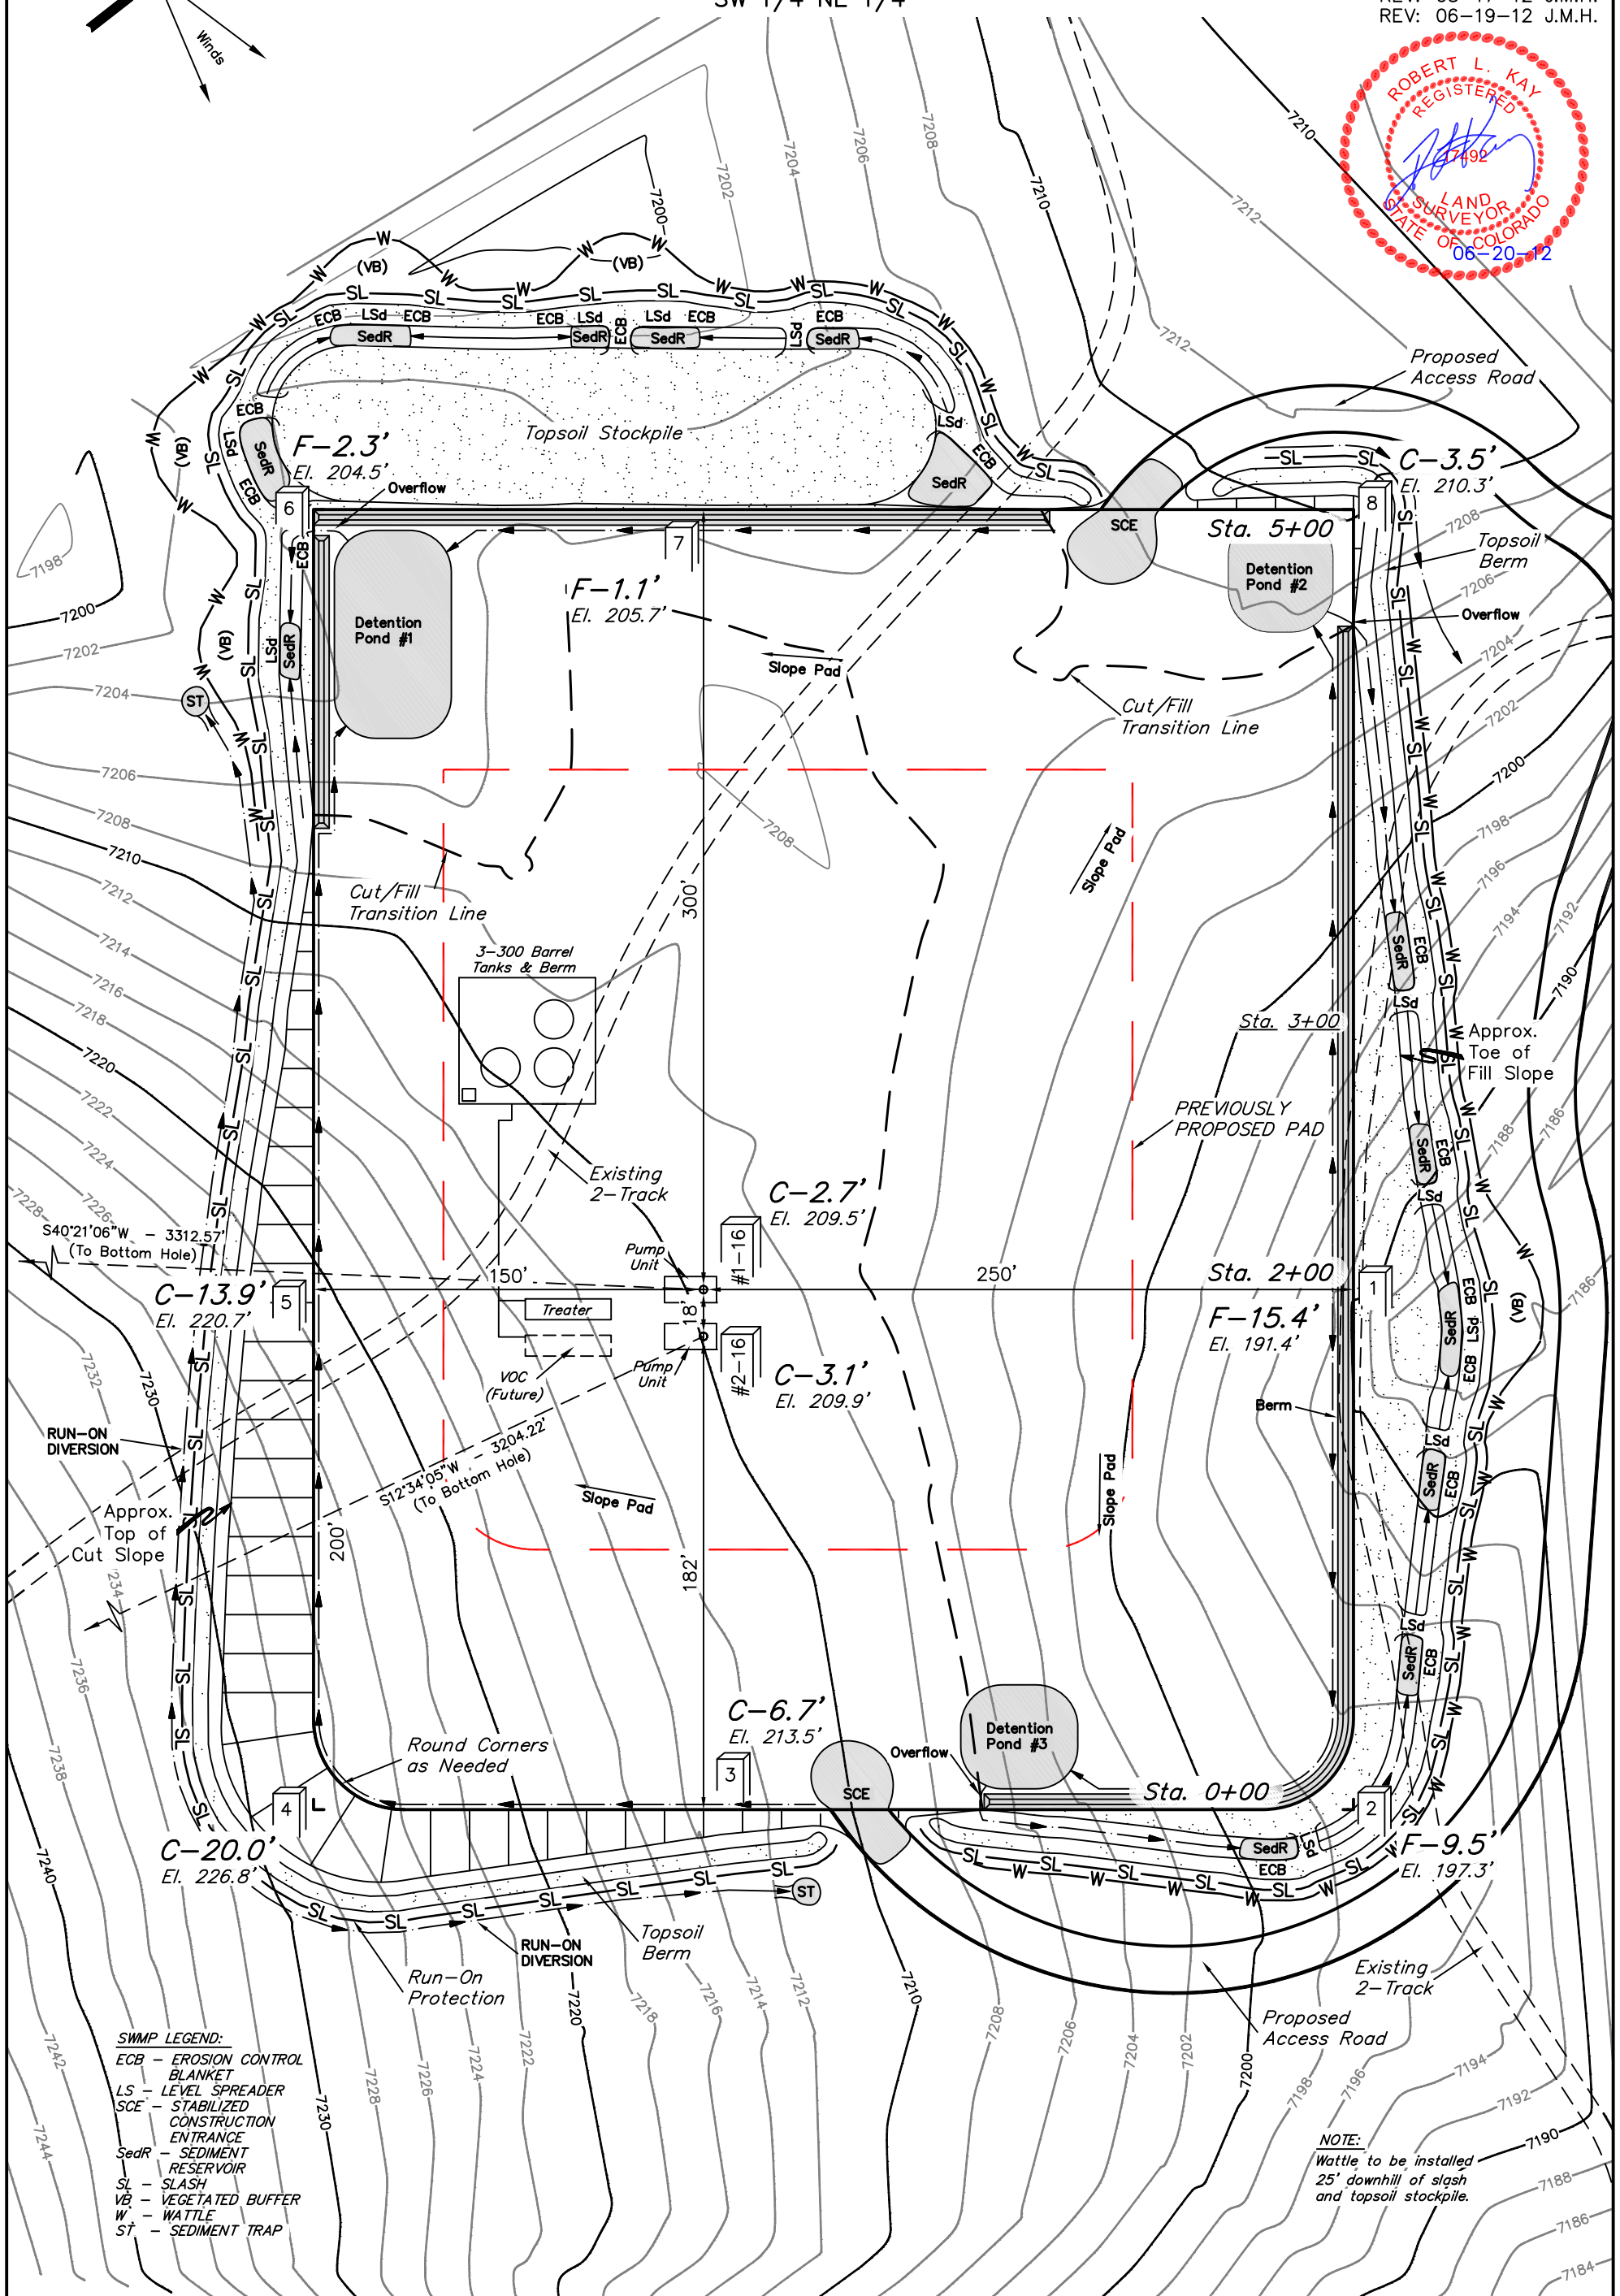

Elev. Ungraded Ground At #1-16 Loc. Stake = 7209.5'
FINISHED GRADE ELEV. AT #1-16 LOC. STAKE = 7206.8'

UINTAH ENGINEERING & LAND SURVEYING
85 So. 200 East * Vernal, Utah 84078 * (435) 789-1017