


SITE SKETCH

CECIL FARMS PC 106-68-1HN

SECTION: 6
TOWNSHIP: 6N
RANGE: 66W

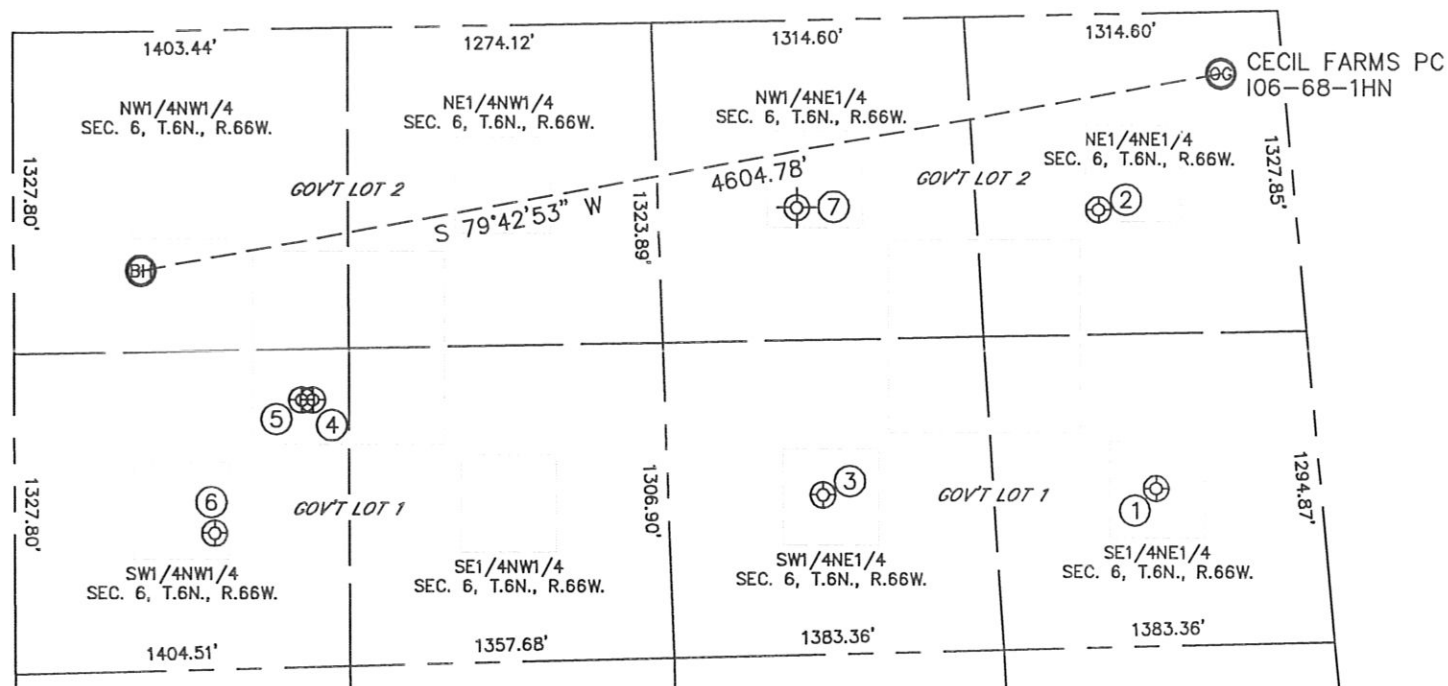

①

CECIL FARMS 6-14
SE1/4NE1/4
1967' FNL
684' FEL
LAT-40.51823°N
LONG-104.81503°W
PDOP: 2.8
ELEV: 4878'

②

CECIL FARMS 6-11
NE1/4NE1/4
808' FNL
822' FEL
LAT-40.52140°N
LONG-104.81586°W
PDOP: 2.2
ELEV: 4874'

③

WEBER 6-13
SW1/4NE1/4
1966' FNL
2077' FEL
LAT-40.51818°N
LONG-104.82005°W
PDOP: 2.2
ELEV: 4903'

④

HKS 6-25
SW1/4NW1/4
1537' FNL
1251' FWL
LAT-40.51929°N
LONG-104.82774°W
PDOP: 2.0
ELEV: 4891'

⑤

HKS 6-22 (DIR)
SW1/4NW1/4
1537' FNL
1205' FWL
LAT-40.51929°N
LONG-104.82790°W
PDOP: 2.0
ELEV: 4890'

⑥

HKS 6-23
SW1/4NW1/4
2082' FNL
839' FWL
LAT-40.51778°N
LONG-104.82923°W
PDOP: 1.9
ELEV: 4897'

⑦

S B H #1
(PLUGGED & ABANDONED)
NW1/4NE1/4 (COGCC)
775' FNL (COGCC)
2080' FEL (COGCC)
LAT-40.52141°N (COGCC)
LONG-104.82033°W (COGCC)
PDOP: N/A
ELEV: 4899' (COGCC)

