

Job # 12097-John Craig 6-2
 Rev: 5-29-12

Inv # 1944


High Prairie Surveying of Kiowa, Colorado has in accordance with a request from **Nighthawk Production LLC.** has determined the location of **John Craig 6-2** to be 2038 feet FNL, and 2267 feet FWL, (90° off Section lines) of SECTION 2, Township **10s**, Range **56w** of the 6th Principal Meridian, **Lincoln County**, Colorado.

Date: Staked on 5/29/12 drawn on 5/29/12.

Re: Staked by Keith Westfall
Drawn: Drawn by Elijah Frane

Basis of Elevation Spot: USGS BM = E 25, PID = KJ0219, H-Order = First, V-Order = First, Stability = C, P-DOP = 2.4, Sats = 9 US NAD 83 CO-C, Lat. = 39.21461, Long. = W103.60209, Elevation = 5248.17 gr. (as FT).

Notes: There are improvements within 400 ft of proposed well pad (See Location Drawing).
 The ground elevation at staked location = 5271.00' gr.
 This drawing does not represent a monumented survey or Land Survey Plat.

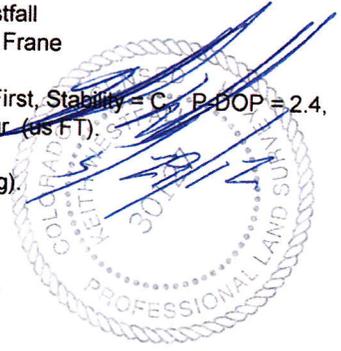

Basis of Bearing: Bearings were determined based on the North line of Section 2 to bear N88°50'20"E with all other bearings contained herein relative thereto.

