

Williams Production RMT Company LLC

FINAL

**RWF 43-31**


API #05-045-19786-00

375' FSL x 2412' FWL - (SESW) - SHL

2483' FSL x 1086' FEL - (NESE) - BHL

Sec. 31-T6S-R94W

Garfield County, Colorado

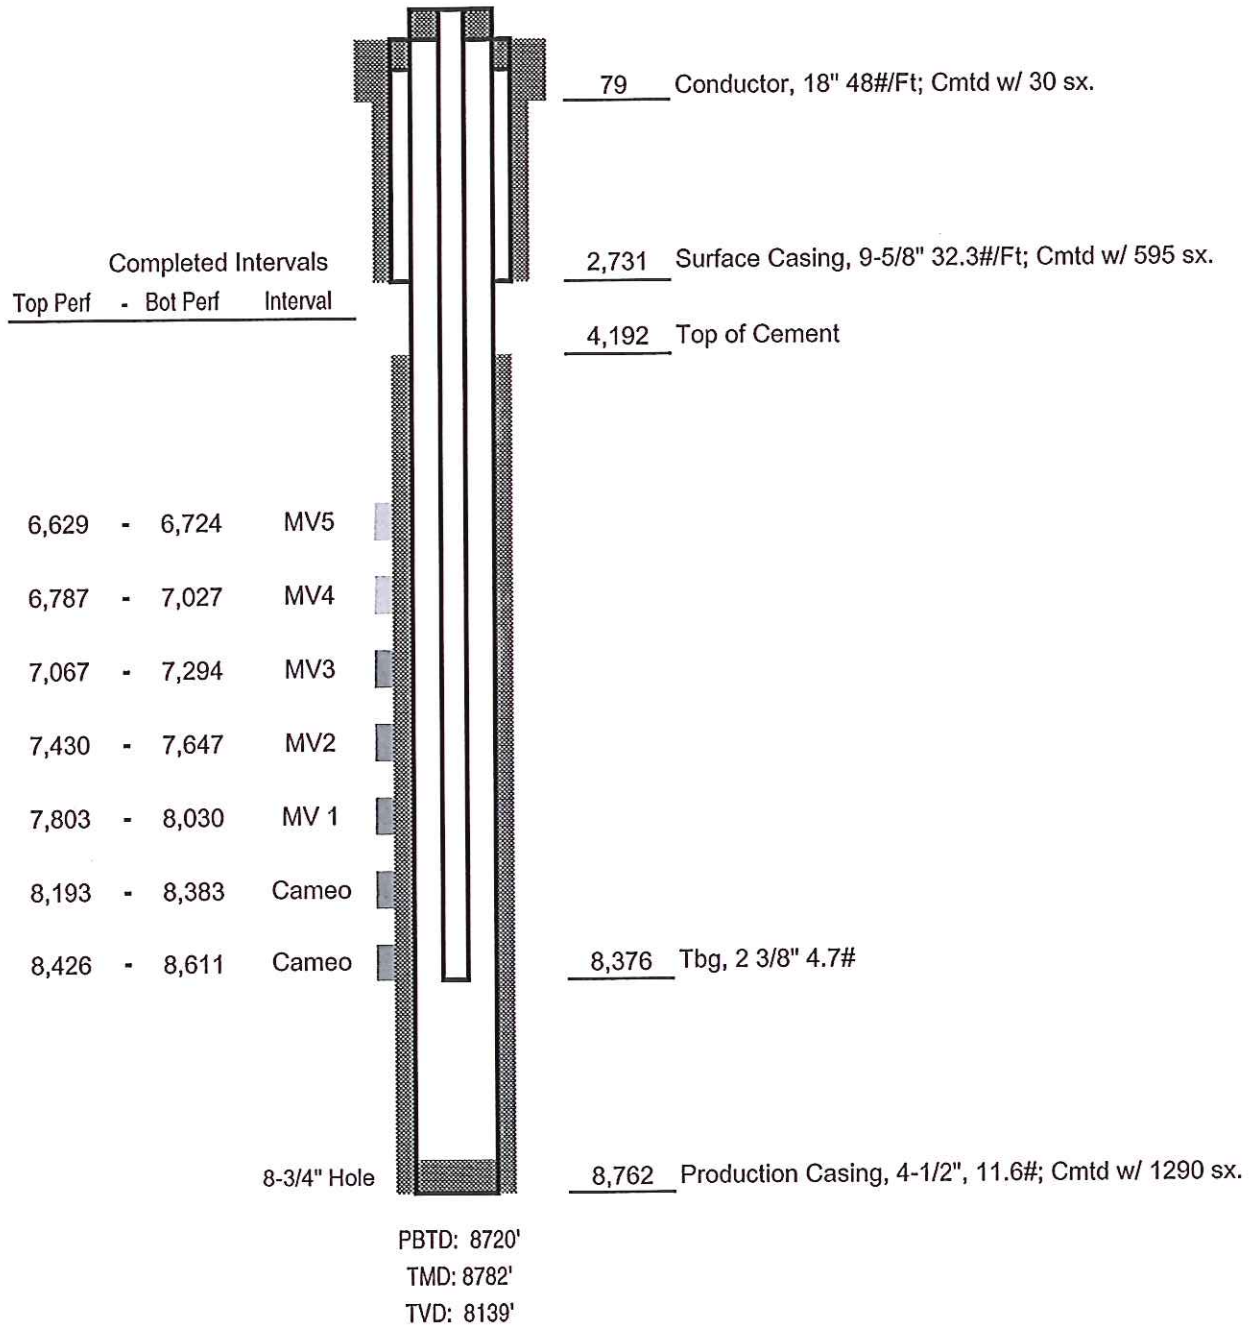

Not to Scale