


Well Name: LEHFELDT C27-11

VERTICAL - ORIGINAL HOLE, 7/19/2012 4:42:06 PM

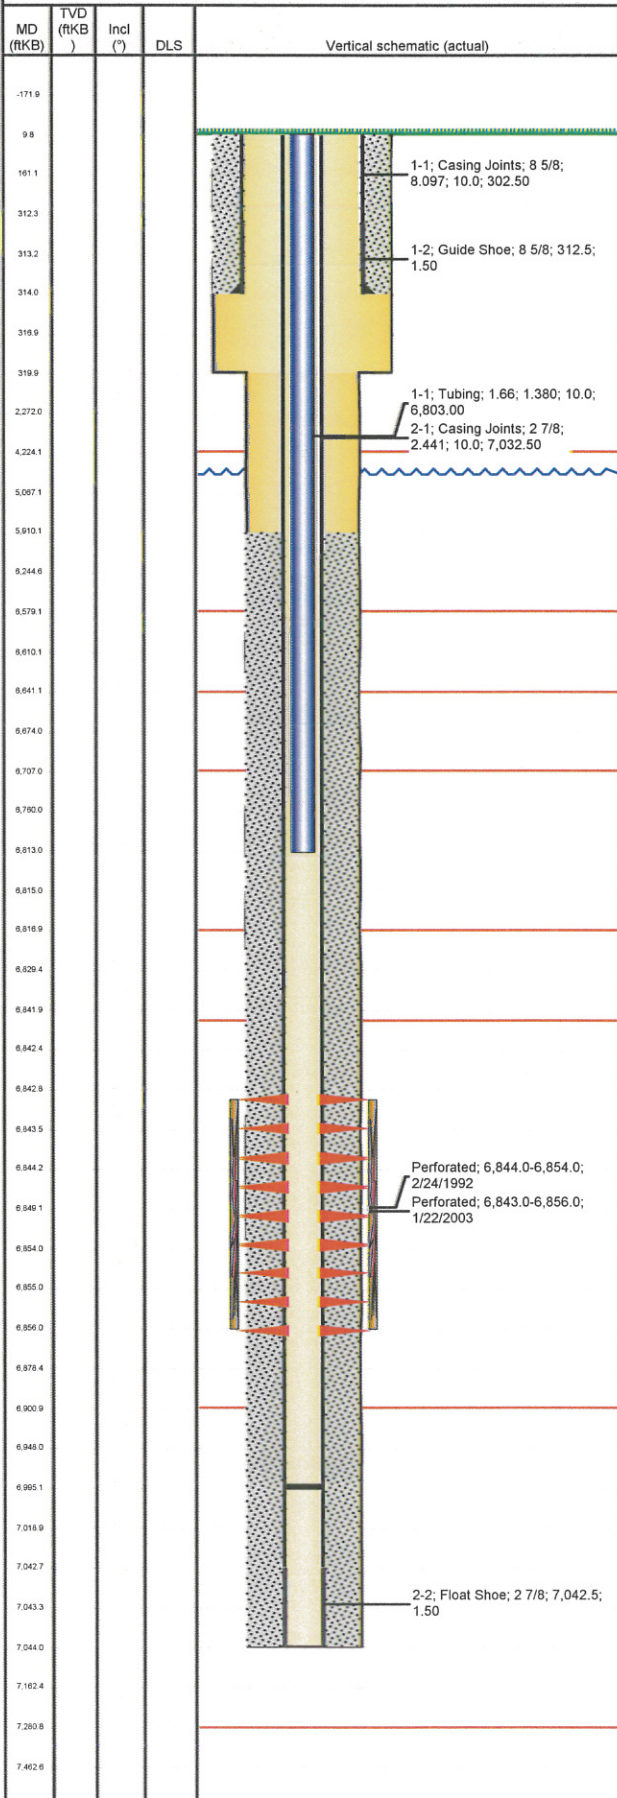

Well Header

API	Business Unit	District	Well Config
05-123-15430	WATTENBERG	15	VERTICAL
Original KB Elevation (ft)	KB - GL / MSL (ftKB)	Spud Date	P & A Date
4,692.00	10.00	2/15/1992	

Comment
TD DISCREPANCY SATE REPORTS SAYS 7043' OTHER REPORTS SAYS 7044'. CASING LANDED AT 7044'.

Directions To Well

Surface Location (Congressional)

Quarter 1	Quarter 2	Quarter 3	Quarter 4	Section	Township	Twnshp...	Range	Rng E/W...
		NE	SW	27	4	N	64	W

Bottom Hole Location

North-South Distance (ft)	From N or S Line	East-West Distance (ft)	From E or W Line

Plug Back Total Depths

Date	Depth (ftKB)	Method	Com
2/19/1992	7,041.0	CASING TALLY	FLOAT SHOE
2/24/1992	6,993.0	CASED HOLE LOG	DEPTH LOGGER ON CBL
1/21/2003	6,979.0	TAG	CLEAN OUT
4/9/2004	6,995.0	TAG	C/O LND TBG

Wellbore Sections

Section Des	Size (in)	Act Top (ftKB)	Act Btm (ftKB)
SURFACE	12 1/4	10.0	320.0
PRODUCTION	7 7/8	320.0	7,044.0

Zone Statuses

Zone Name	Status Date	Status	Job
CODELL	3/22/1992	PR	DRILLING/COMPLETION - ORIGINAL, 2/15/1992 00:00
CODELL	1/29/2003	PR	RE-FRAC, 1/21/2003 00:00

Casing Strings

Surface, 314.0ftKB

Casing Description	Run Date	OD (in)	Wt/Len (l...)	Grade	Top (ftKB)	Set Depth...
Surface	2/15/1992	8 5/8	24.00	J-55	10.0	314.0

Production, 7,044.0ftKB

Casing Description	Run Date	OD (in)	Wt/Len (l...)	Grade	Top (ftKB)	Set Depth...
Production	2/19/1992	2 7/8	8.70	N-80	10.0	7,044.0

Cement

Description	Top Depth (ftKB)	Bottom Depth (ftKB)
SURFACE CASING CEMENT	10.0	314.0
Description	Top Depth (ftKB)	Bottom Depth (ftKB)
PRODUCTION CASING CEMENT	5,910.0	7,044.0

Tubing Components

Item Des	OD (in)	Wt (lb/ft)	Grade	Jts	Len (ft)	Btm (ftKB)	Btm (TVD) (ftKB)
Tubing	1.66	2.33	?	207	6,803.00	6,813.0	

Perforation Data

Zone	Bnch/St g	Entered Shot Total	Top (ftKB)	Btm (ftKB)	Date
CODELL, ORIGINAL HOLE		56	6,843.0	6,856.0	1/22/2003
CODELL, ORIGINAL HOLE		40	6,844.0	6,854.0	2/24/1992

Stimulations & Treatments

Date	Zone	Primary Job Type
2/24/1992	CODELL, ORIGINAL HOLE	DRILLING/COMPLETION - ORIGINAL
Technical Result	Tech Result Details	Tech Result Note
Failure	Screen-Out	

Comment

STARTED SCREENING OUT @5# STAGE

Date	Zone	Primary Job Type
1/28/2003	CODELL, ORIGINAL HOLE	RE-FRAC
Technical Result	Tech Result Details	Tech Result Note

Comment

Other In Hole

Run Date	Des	OD (in)	Top (ftKB)	Btm (ftKB)

Logs

Date	Type	Top (ftKB)	Btm (ftKB)
2/19/1992	COMPENSATED DENSITY	6,840.0	7,060.0