


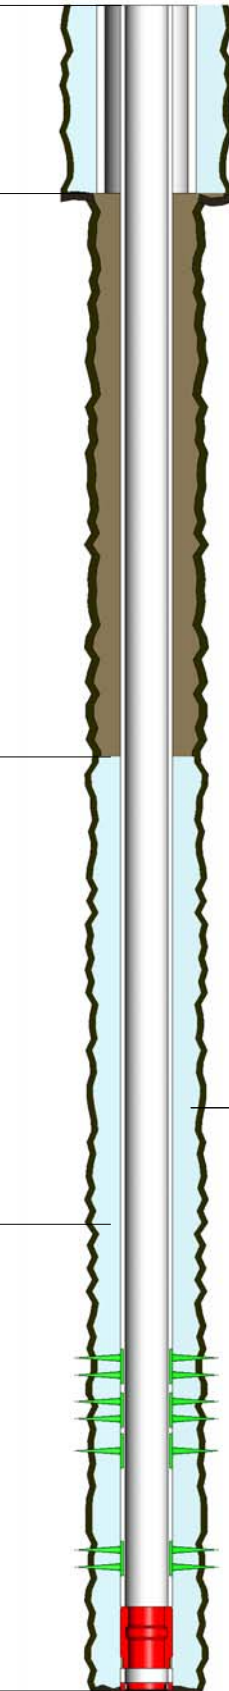

Company: US ROCKIES REGION		Site: ROBERT 3-14 PAD	
Project: COLORADO-WELD		Common Well Name: ROBERT 3-14	
API No: 0512323083	Datum: RKB	Section: 14	Div of Quarter Section: NE
Latitude: 40° 8' 37.500 N	Elevation: 5,062.0usft	Township: 2 N	Div of Section: NW
Longitude: 104° 44' 49.956 W	Water Depth: 5,050.0usft	Range: 66 W	

Casing Information	Casing Size & Weight	Cement Fluid (sacks)	Cement Depths (ft)	Schematic (7/23/2012)	Hole Size (in)	MD / PBMD (usft)	Perforation Intervals (usft)
SURFACE CASING - Set @ 1,028.0usft	8.625in,	, 3% CACL2 1/ 4 #/sk Flocel, 720	12 (TOC)				
PRODUCTION CASING - Set @ 7,682.0usft	4.500in,		1028				
			4073 (TOC)				
			6600		12.250		
		@ 14.6 ppg, @ 13 ppg, 180	7681			MD: 7,691 PBMD: 7,666	7,274 - 7,290 - NIOBRARA 7,340 - 7,354 - NIOBRARA 7,388 - 7,402 - NIOBRARA 7,528 - 7,545 - CODELL