



Physical Address: 401 Arapahoe St.
Mail to: Box 384 Kiowa, CO 80117
Ph. 303-621-8672 - Fax 303-621-2717
www.highprairiesurvey.com

Job: 12099 Knoss 6-21


Inv # 1960

High Prairie Surveying of Kiowa, Colorado has in accordance with a request from **Chuck Wilson, Nighthawk Production LLC** has determined the location of **Knoss 6-21** to be **1402 feet FNL**, and **1686 feet FWL**, (90° off Section lines) of **SECTION 21**, Township **12s**, Range **56w** of the 6th Principal Meridian, **Lincoln County, Colorado**.

Date: Staked on 5-31-12 drawn on 6-6-12.

Re: Staked by Keith Westfall
Drawn: Drawn by Elijah Frane

Topo Exhibit

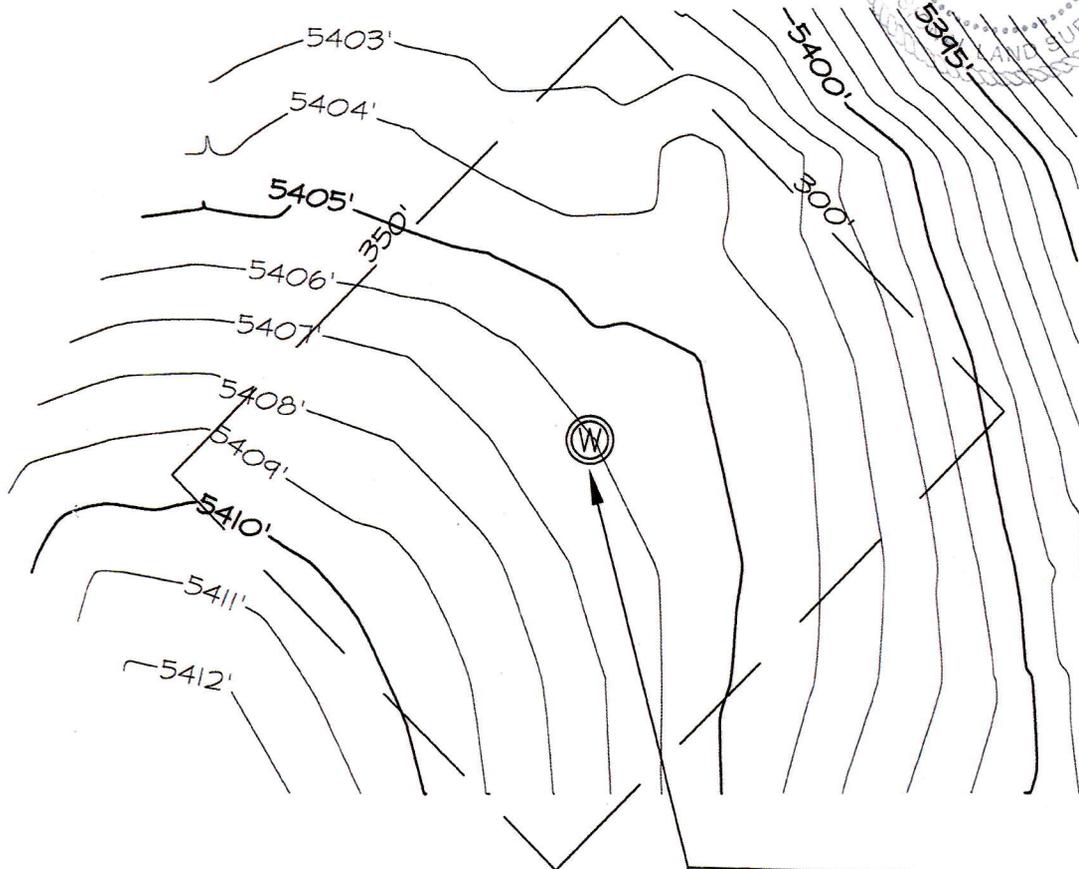

NIGHTHAWK PRODUCTION
NW ¼ SEC 21-12S-56W
KNOSS 6-21
LINCOLN CO. COLORADO