

Lat40°, Inc. 1635 Foxtrail Drive, Suite 325 Loveland, CO 970-776-3321


# WELL LOCATION CERTIFICATE

SECTION: 6  
TOWNSHIP: 9N  
RANGE: 61W

THIS MAP DOES NOT REPRESENT A BOUNDARY SURVEY


LAT: 40.78449°N  
LONG: 104.25946°W

LAT: 40.78409°N  
LONG: 104.23995°W

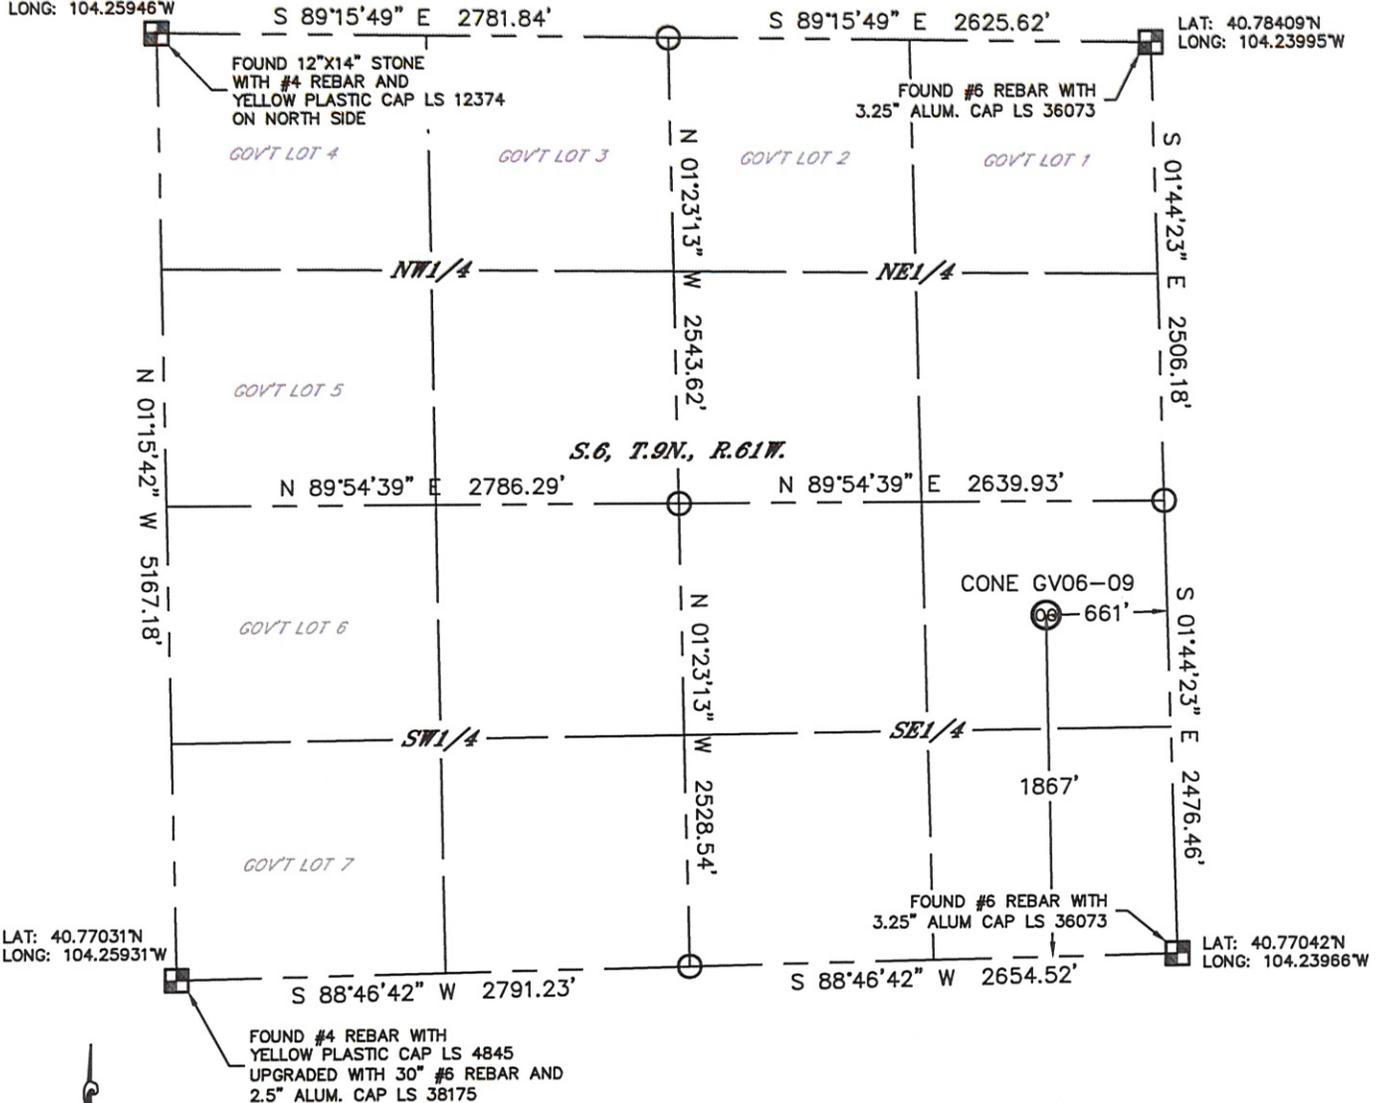

LAT: 40.77031°N  
LONG: 104.25931°W

LAT: 40.77042°N  
LONG: 104.23966°W

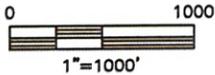

In accordance with a request from Ryan Hawkins with Noble Energy Inc. Lat40°, Inc. has determined the surface location of the CONE GV06-09 to be 1867' from the SOUTH line and 661' from the EAST line as measured at right angles from the section lines of Section 6, Township 9 North, Range 61 West of the Sixth Principal Meridian, County of Weld, State of Colorado.

I hereby state that this Well Location Certificate was prepared by me, or under my direct supervision, that the fieldwork was completed on 6/8/2012, for and on behalf of Noble Energy Inc. That this is not a Land Survey Plat or an Improvement Survey Plat, and that it is not to be relied upon for establishment of fence, building, or other future improvement lines.

**NOTE:**

- 1) Bearings shown are Grid Bearings of the Colorado State Plane Coordinate System, North Zone, North American Datum 1983/2007. The lineal dimensions as contained herein are based upon the "U.S. Survey Foot."
- 2) Ground elevations are based on an observed GPS elevation (NAVD 1988 DATUM).
- 3) NEAREST EXISTING WELL: NONE WITHIN SECTION
- 4) IMPROVEMENTS: See LOCATION DRAWING for all visible Improvements within 400' of disturbed area.
- 5) SURFACE USE: RANGELAND
- 6) INSTRUMENT OPERATOR: ADAM KELLY

**SURFACE LOCATION**

LAT: 40.77553°N  
LONG: 104.24215°W  
PDOP: 1.4  
ELEV: 4970'  
1/4, 1/4: NE1/4SE1/4  
NEAREST PROPERTY LINE: 621' NORTH

**NOTE**

According to Colorado law, you must commence any legal action based upon any defect in this W.L.C. within three years after you discover such defect. In no event, may any action based upon any defect in this survey be commenced more than ten years after the date of the certificate shown hereon. (13-80-105 C.R.S.)

**LEGEND**

- = ALIQUOT MONUMENT AS DESCRIBED
- = CALCULATED POSITION




Brian T. Brinkman—On behalf of Lat40°, Inc.  
Colorado Licensed Professional Surveyor No. 38175  
Date: 6/13/2012  
PROJECT#: 2012085

Lat40°, Inc. 1635 Foxtrail Drive, Suite 325 Loveland, CO 970-776-3321


# SITE SKETCH

CONE GV06-09

SECTION: 6  
TOWNSHIP: 9N  
RANGE: 61W

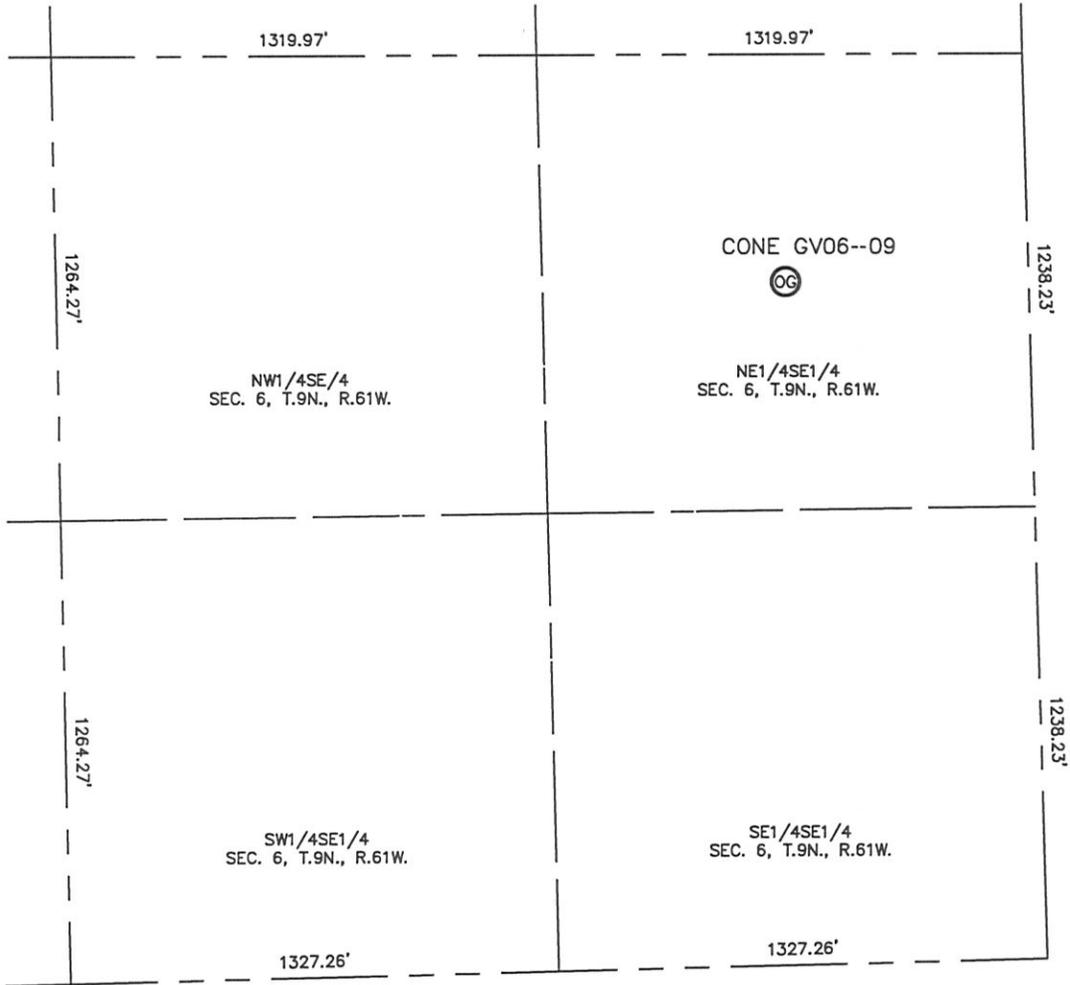

NOTE: NO EXISTING WELLS WITHIN QUARTER SECTION.

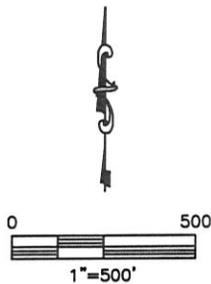

DATE: 6/13/2012  
PROJECT#: 2012085