


WPX Energy Rocky Mountain, LLC
Jolley KP 334-8
Kokopelli Field
SHL 192' FSL 2380' FWL (SE/4 SW/4) BHL 930' FSL 2007' FEL (SW/4 SE/4)
Section 8-T6S-R91W 6th PM
Garfield County, Colorado

Formation Tops
(Measured Depths)

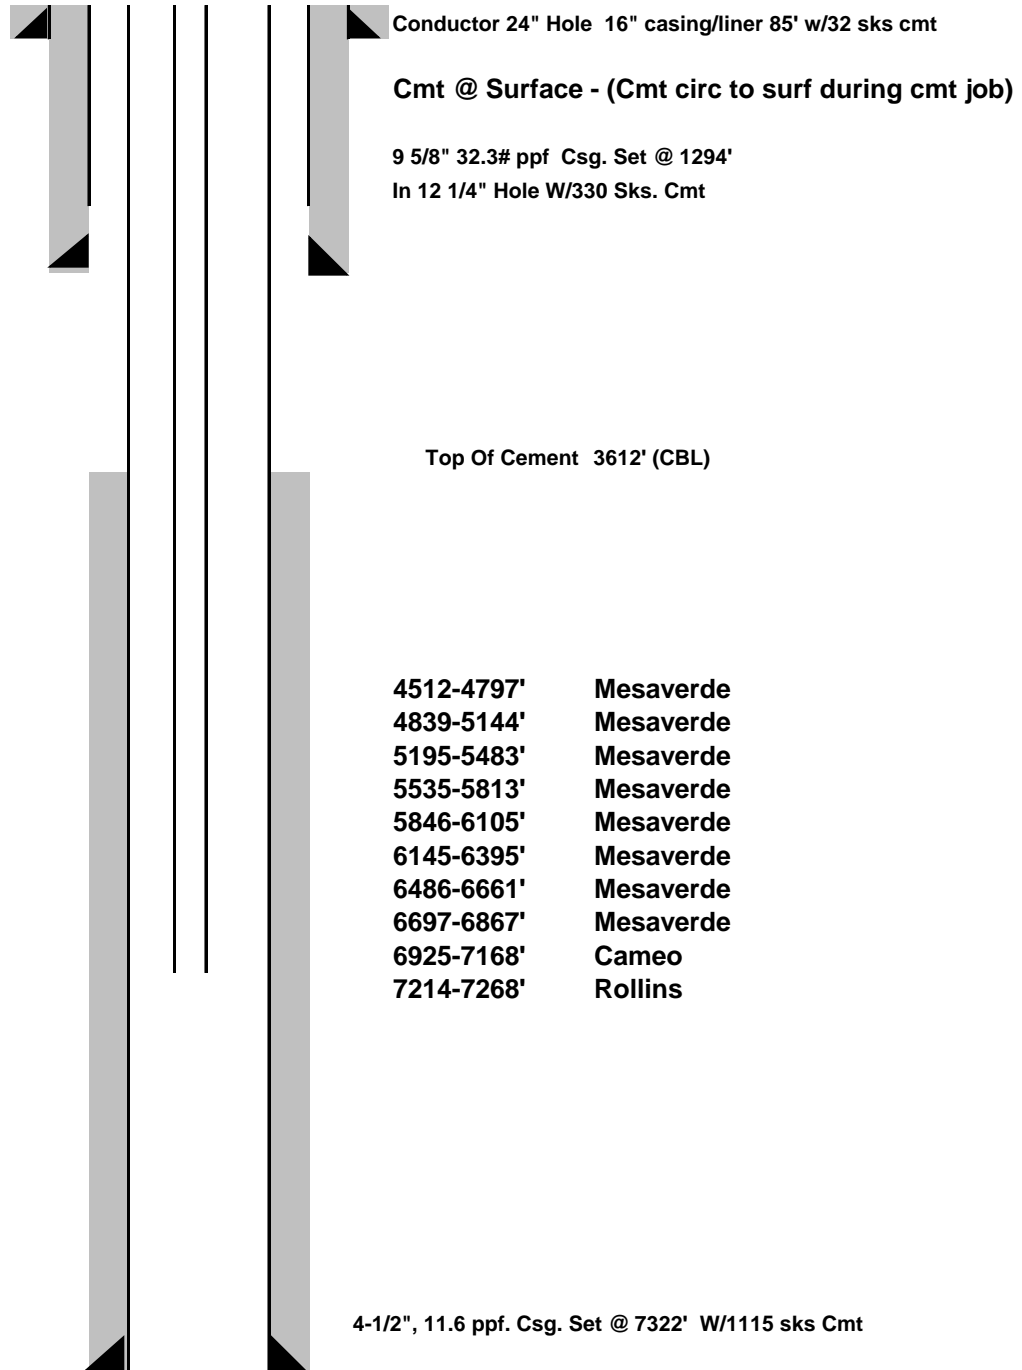

Tubing String: 2-3/8" Set @6213.2'

PBTD @ 7285'
TMD @ 7340'
TVD @ 7144'