


WELL LOCATION CERTIFICATE


THIS MAP DOES NOT REPRESENT A BOUNDARY SURVEY

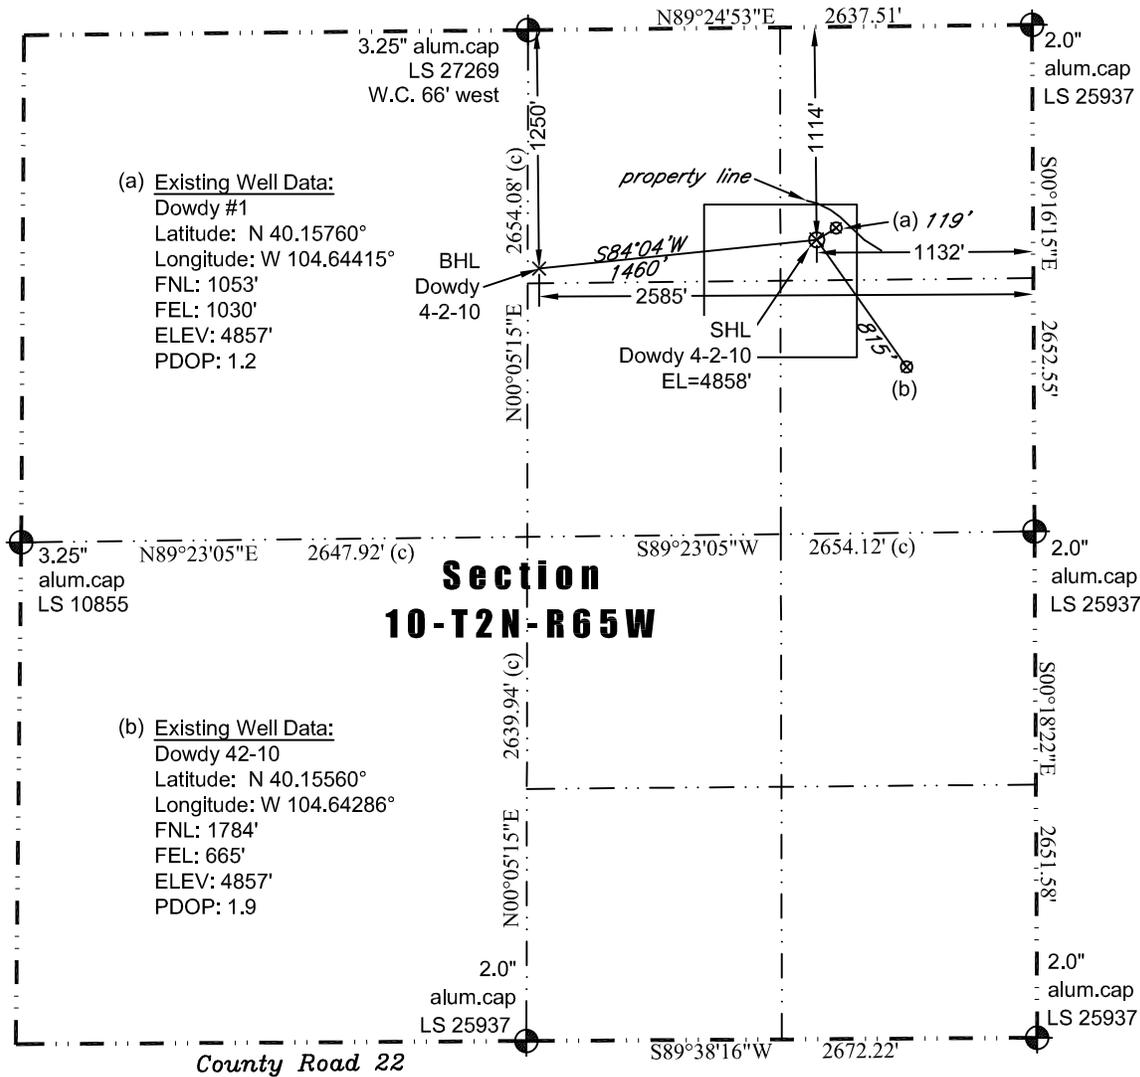

(a) Existing Well Data:
 Dowdy #1
 Latitude: N 40.15760°
 Longitude: W 104.64415°
 FNL: 1053'
 FEL: 1030'
 ELEV: 4857'
 PDOP: 1.2

(b) Existing Well Data:
 Dowdy 42-10
 Latitude: N 40.15560°
 Longitude: W 104.64286°
 FNL: 1784'
 FEL: 665'
 ELEV: 4857'
 PDOP: 1.9

Section 10-T2N-R65W

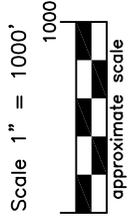

Scale 1" = 1000'
 approximate scale

LEGEND
 — found survey monument
 - - - calculated dimension

In accordance with a request from Jay Knutson of EnCana Oil & Gas (USA) Inc., JR Land Surveying, LLC has determined the location of the **Dowdy 4-2-10** well site to be SHL: 1114' FNL and 1132' FEL, (BHL 1250' FNL and 2585' FEL), as measured at ninety (90) degrees from the section lines of Section 10, Township 2 North, Range 65 West of the 6th Principal Meridian, Weld County Colorado.

Proposed Surface Hole Data:

Latitude: N 40.15744° (BHL: 40.15706°)
 Longitude: W 104.64452° (BHL: 104.64972°)
 PDOP: 2.2

Nearest:

- Building 1,208' northwest
- Public Road 4,170' south
- Property Line 173' northeast
- Existing Well: Dowdy #1, 119' northeast
- Above Ground Utility 1,030' north
- Railroad 23,768' southeast
- Well Window: SHL is 185' inside

I hereby certify that this Well Location Certificate was prepared by me or under my direct supervision on 5/25/2012 for and on behalf of EnCana Oil & Gas (USA) Inc. That it is not a Land Survey Plat or an Improvement Survey Plat and that it is not to be relied upon for establishment of fences, buildings, or other future improvement lines. **38219**

5-25-2012
 John Robert McGehee LS#38219
 Well: Dowdy 4-2-10 WLC

- Notes:
- 1) Bearings and distances based on NAD 83 Colorado North State Plane Coordinates using RTK GPS observations taken 5/24/12 by operator John Rice.
 - 2) Conversion factor to ground (1.000270725).
 - 3) Elevations based on NAVD 88 GPS heights and Geoid 2003 corrections.
 - 4) See Location Drawing for visible improvements within 400 feet of Pad Site.
 - 5) The surface use is a uncultivated field.

NOTICE: According to Colorado law you must commence any legal action based upon any defect in this W.L.C. within three years after you first discover such defect. In no event may any action based upon any defect in this W.L.C. be commenced more than ten years from this said date of the certification shown hereon.