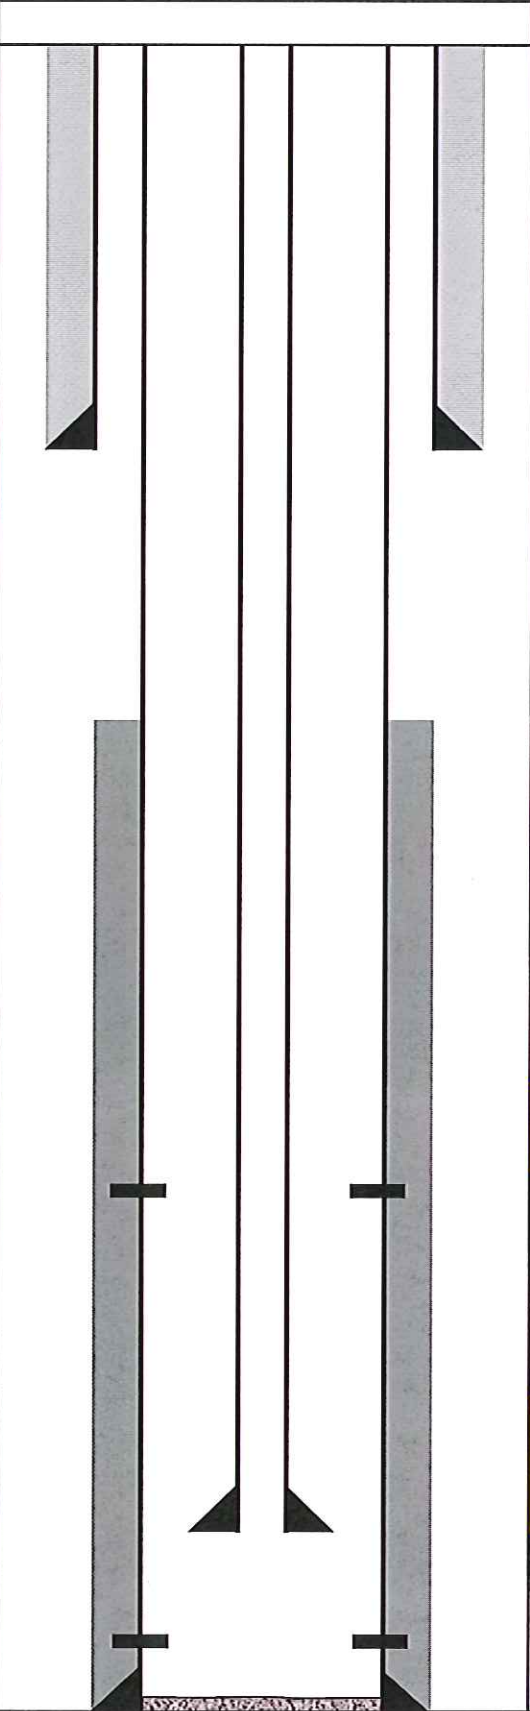


WPX Energy Rocky Mountain LLC
RWF 433-18
API # - 05-045-09941
NWSE 18 6S 94W
Garfield County, Colorado

	Perf Depths (MD)		WELLBORE	DEPTH (MD)
	Top	Bottom		
				TOC - 0
				13 1/2" OH
				9 5/8" 32.3# H-40 Surface Csg @ 1,106 BOC - 1,106
				7 7/8" OH
				TOC - 5,334
				6346-6543 - Sqz'd MV 3 w/115 sxs 17 ppg Class G cement
Mesa Verde 2	6,724	6,934		
Mesa Verde 1	7,082	7,387		
Cameo	7,756	8,003		260 jts 2 3/8" 4.7# J-55 Tubing Landed - 07/03/12 @ 8,224
Lower Cameo	8,142	8,512		4 1/2" 11.6# I-80 Production Csg @ 8,634 BOC - 8,634