




**Lease Name:** Hilfer #13-8D

**Legals:** NESW – Sec. 8, T4N, R67W

**County:** Weld County, Colorado

**API#:** 05-123-35002

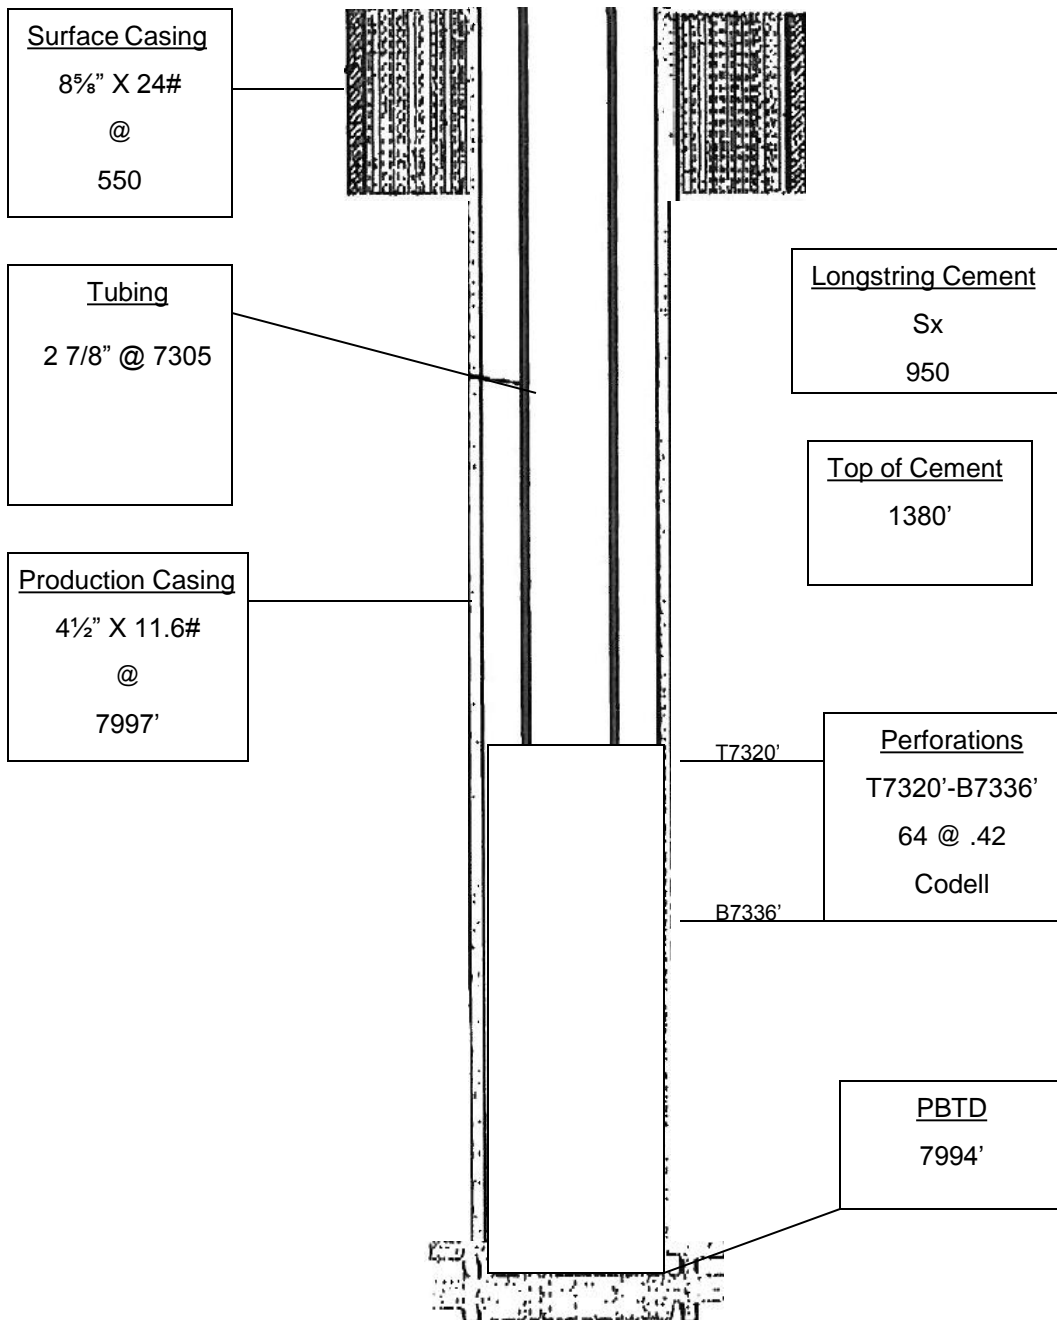

**Wellbore Diagram**