

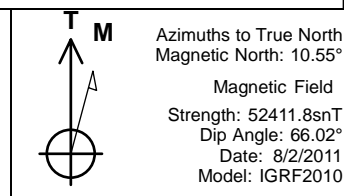


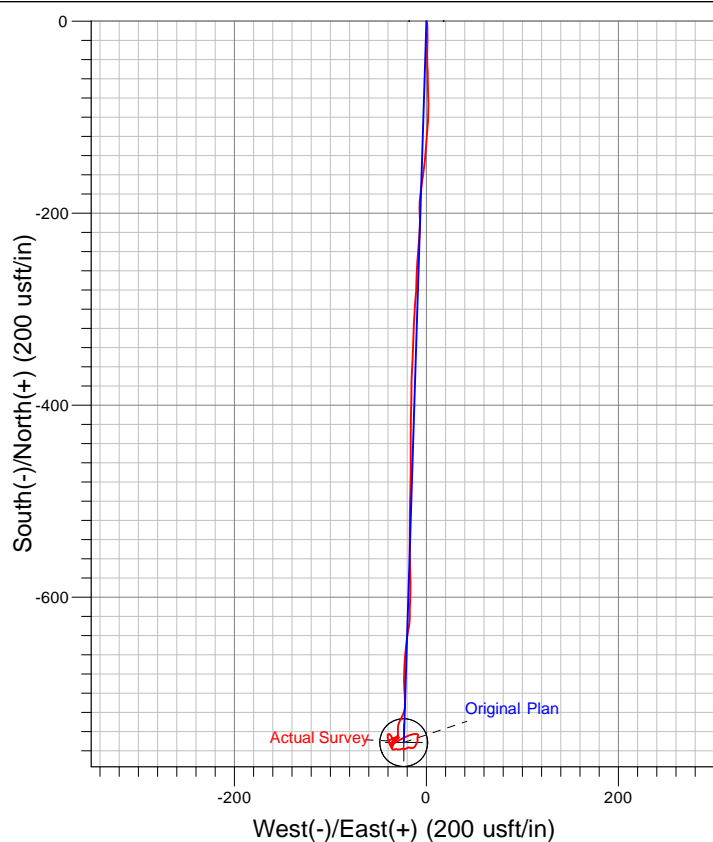

+N/-S	+E/-W	Northing	Easting	Latitude	Longitude	Slot
0.0	0.0	1772353.20	2197193.30	39° 55' 9.122 N	108° 21' 44.976 W	A9

KELLY BUSHING @ 6799.0usft (Cyclone 29 (21' RKB) jib)

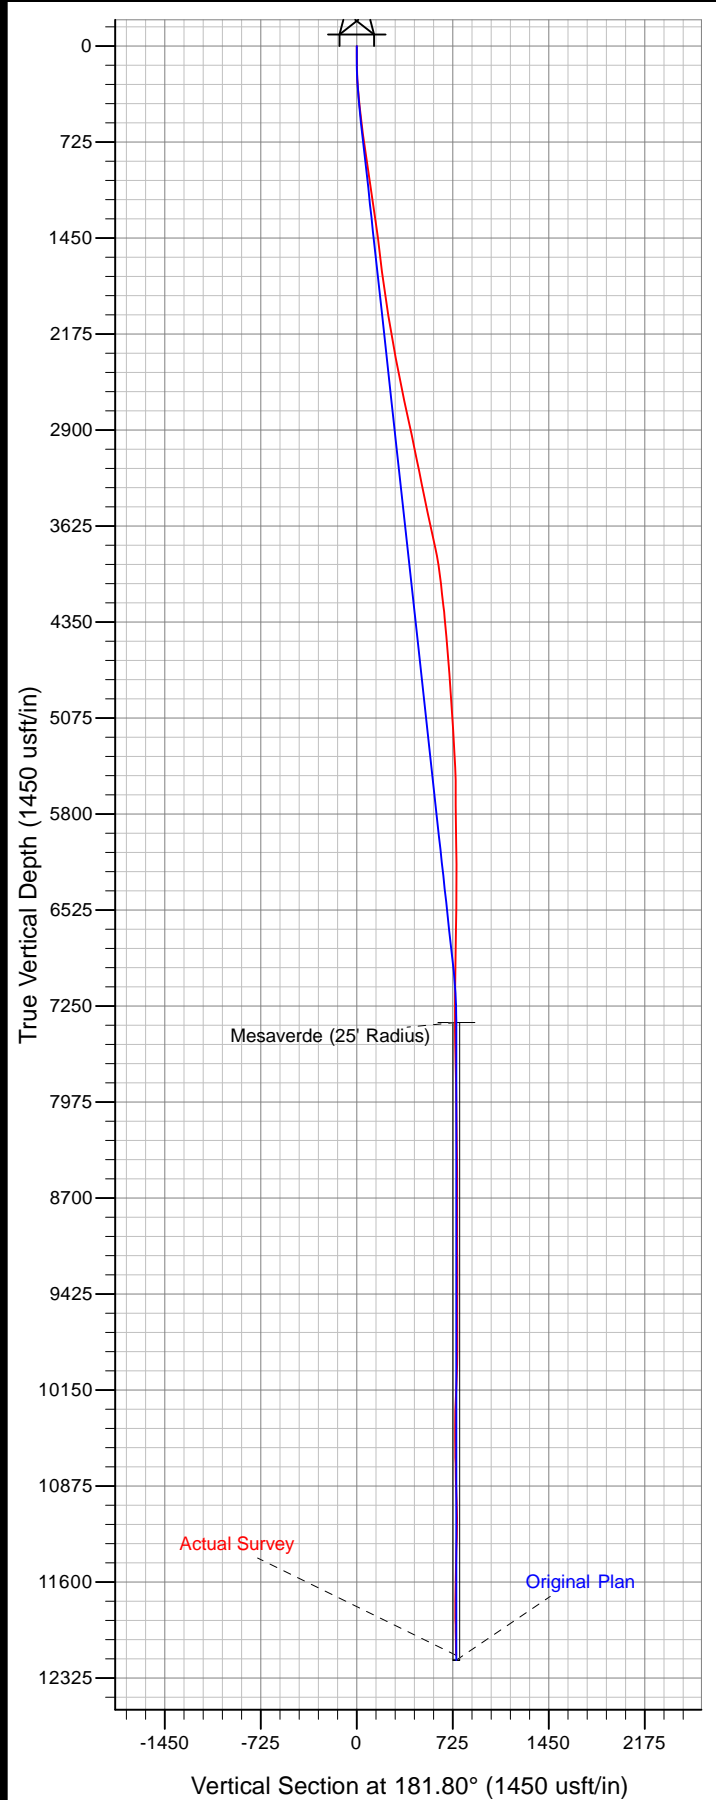

Azimuths to True North
Magnetic North: 10.55°

Magnetic Field

Strength: 52411.8snT

Dip Angle: 66.02°

Date: 8/2/2011

Model: IGRF2010