

WPX Energy Rocky Mountain LLC

**FINAL**

**RWF 541-36**


API #05-045-20745-00

1459' FNL x 2460' FEL - (SWNE) - SHL

1086' FNL x 775' FEL - (NENE) - BHL

Section 36-T6S-R94W

Garfield County, Colorado

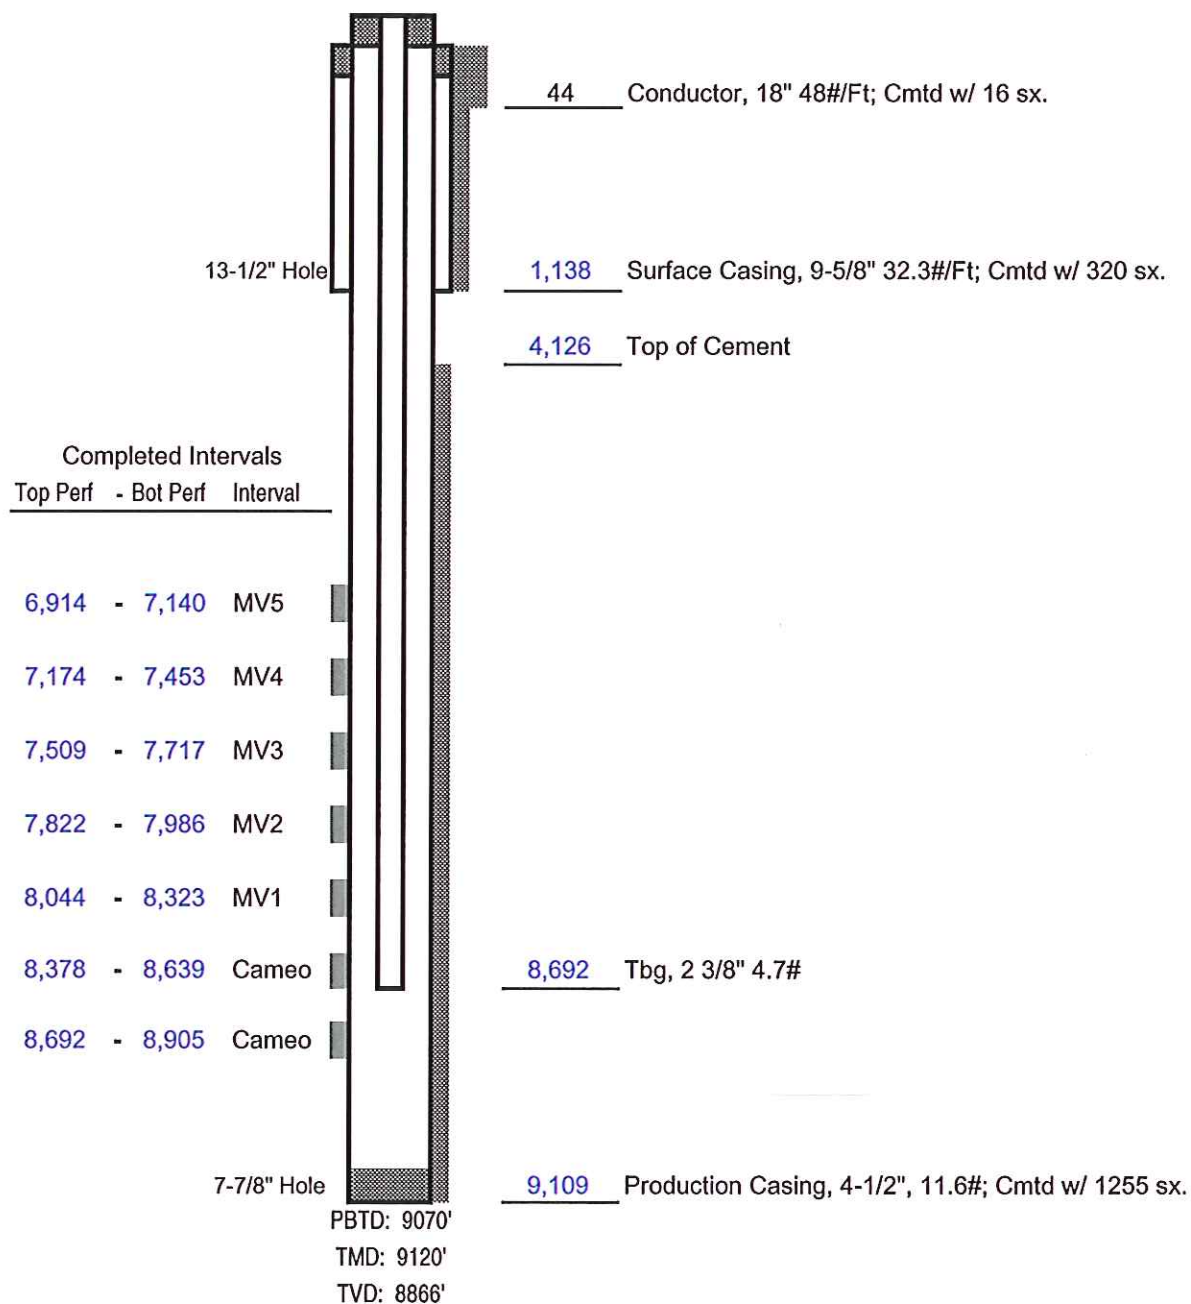

Not to Scale