

Williams Production RMT Co.
Chevron TR 42-32-597
Trail Ridge Field
SHL 1034' FNL 360' FEL (NE/4 NE/4) BHL 2201' FNL 701' FEL (SE/4 NE/4)
Section 32-T5S-R97W 6th PM
Garfield County, Colorado

Formation Tops
(Measured Depths)

Mesaverde @ 5604'


Cameo @ 7902'

Rollins @ 8258'

PBTD @ 8457'

TMD @ 8514'

TVD @ 8362'

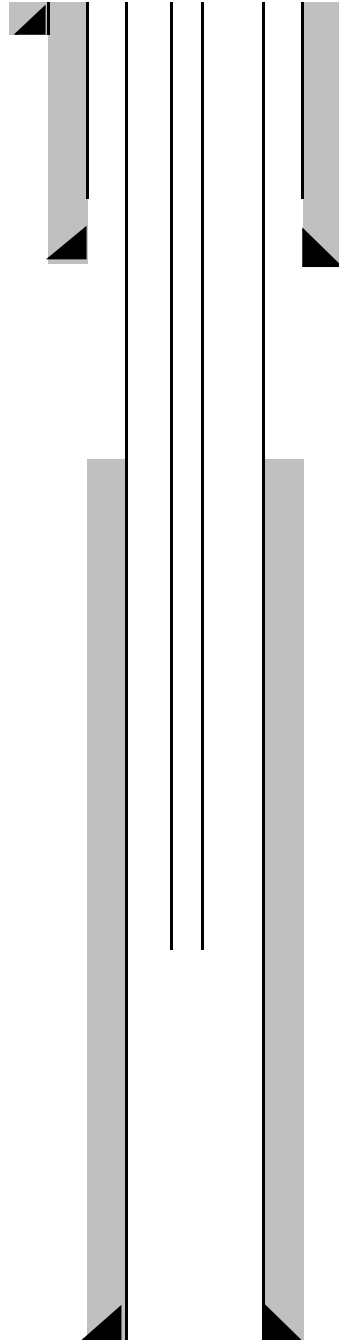

Conductor 26" Hole 16" casing/liner 65' W/23 sks cmt

Cmt @ Surface - (Cmt circ to surf during cmt job)

9 5/8" 32.3# ppf Csg. Set @ 2875'

In 12 1/4" Hole W/ 1450 Sks. Cmt

Top Of Cement 4810'

6533-6579' Mesaverde
 6618-6726' Mesaverde
 6841-7000 Mesaverde
 7049-7291' Mesaverde
 7366-7602' Mesaverde
 7649-7762' Mesaverde
 7833-7979' Mesaverde/Cameo
 8056-8204' Cameo

4-1/2", 11.6 ppf. Csg. Set @ 8489' W/ 850 sks Cmt