

WPX Energy Rocky Mountain LLC

FINAL

RWF 311-36


API #05-045-20755-00

1548' FNL x 1729' FWL - (SENW) - SHL

158' FNL x 884' FWL - (NWNW) - BHL

Section 36-T6S-R94W

Garfield County, Colorado

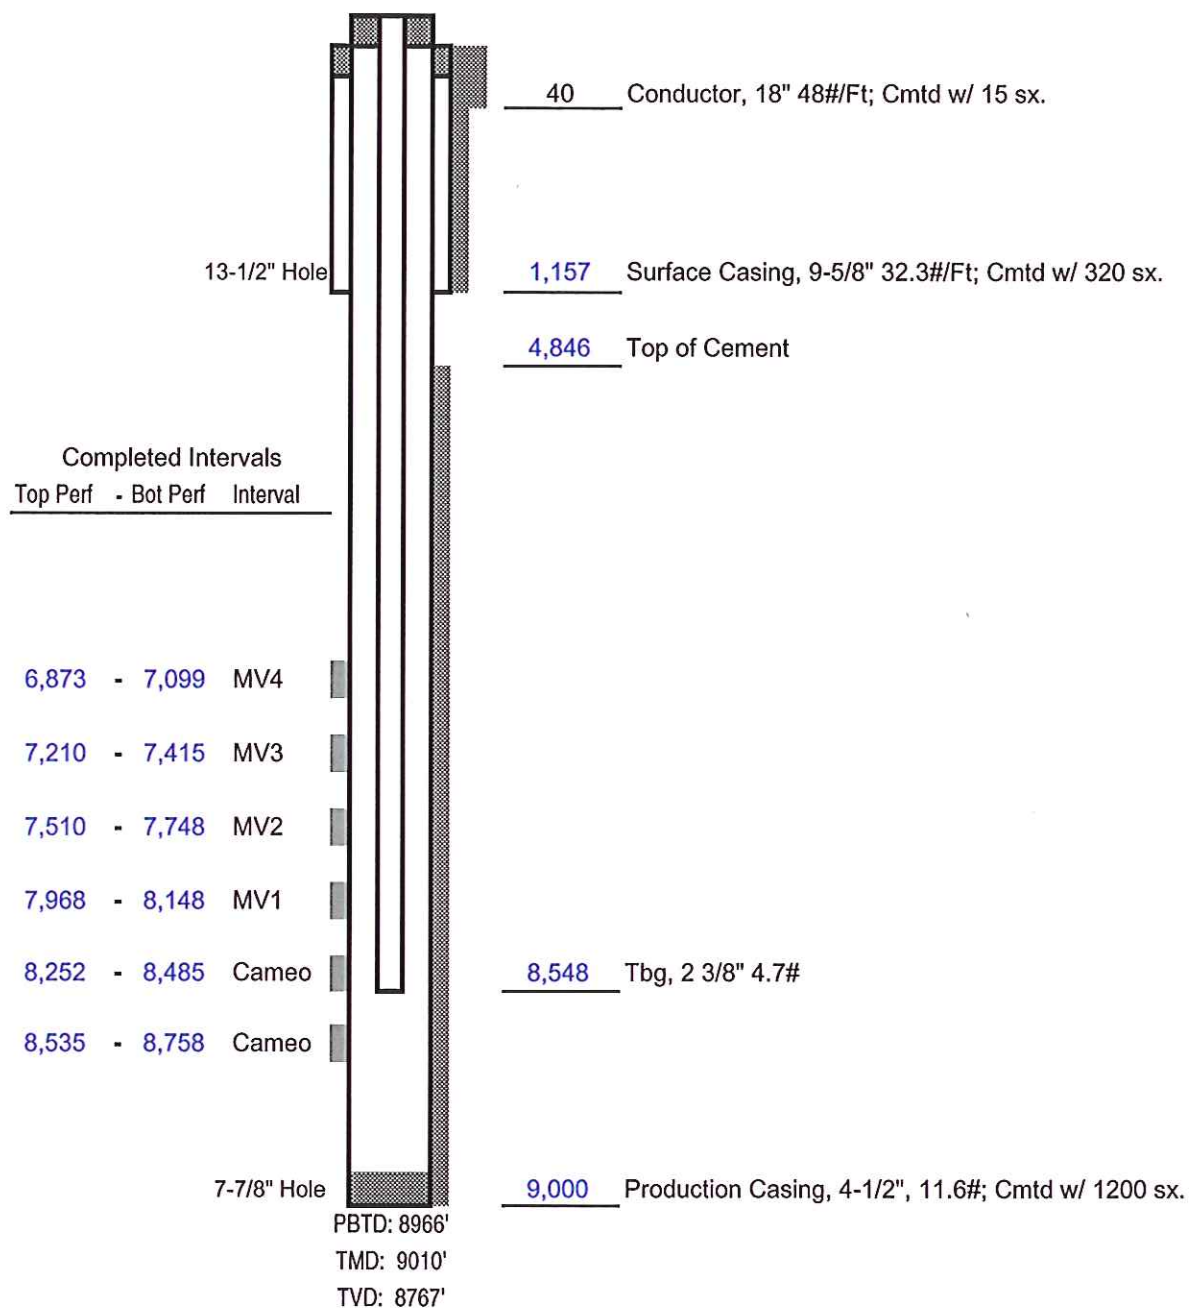

Not to Scale